

RE: Elida Mennonite School
Report
Drinking Water Program
Allen County
PWS ID: OH0251912

RECEIVED

MAR 06 2017

DDAGW - NWDO

Elida Mennonite School
3666 N. Grubb Rd.
Delphos, OH 45833
(419) 339-6301


< North

Non-Lead Service Line

Cold water lines

Hot water lines

The building was constructed in 1950 and added onto in 1964. All plumbing was prior to 1986 so it is probable that fixtures/fittings/solder contain lead.

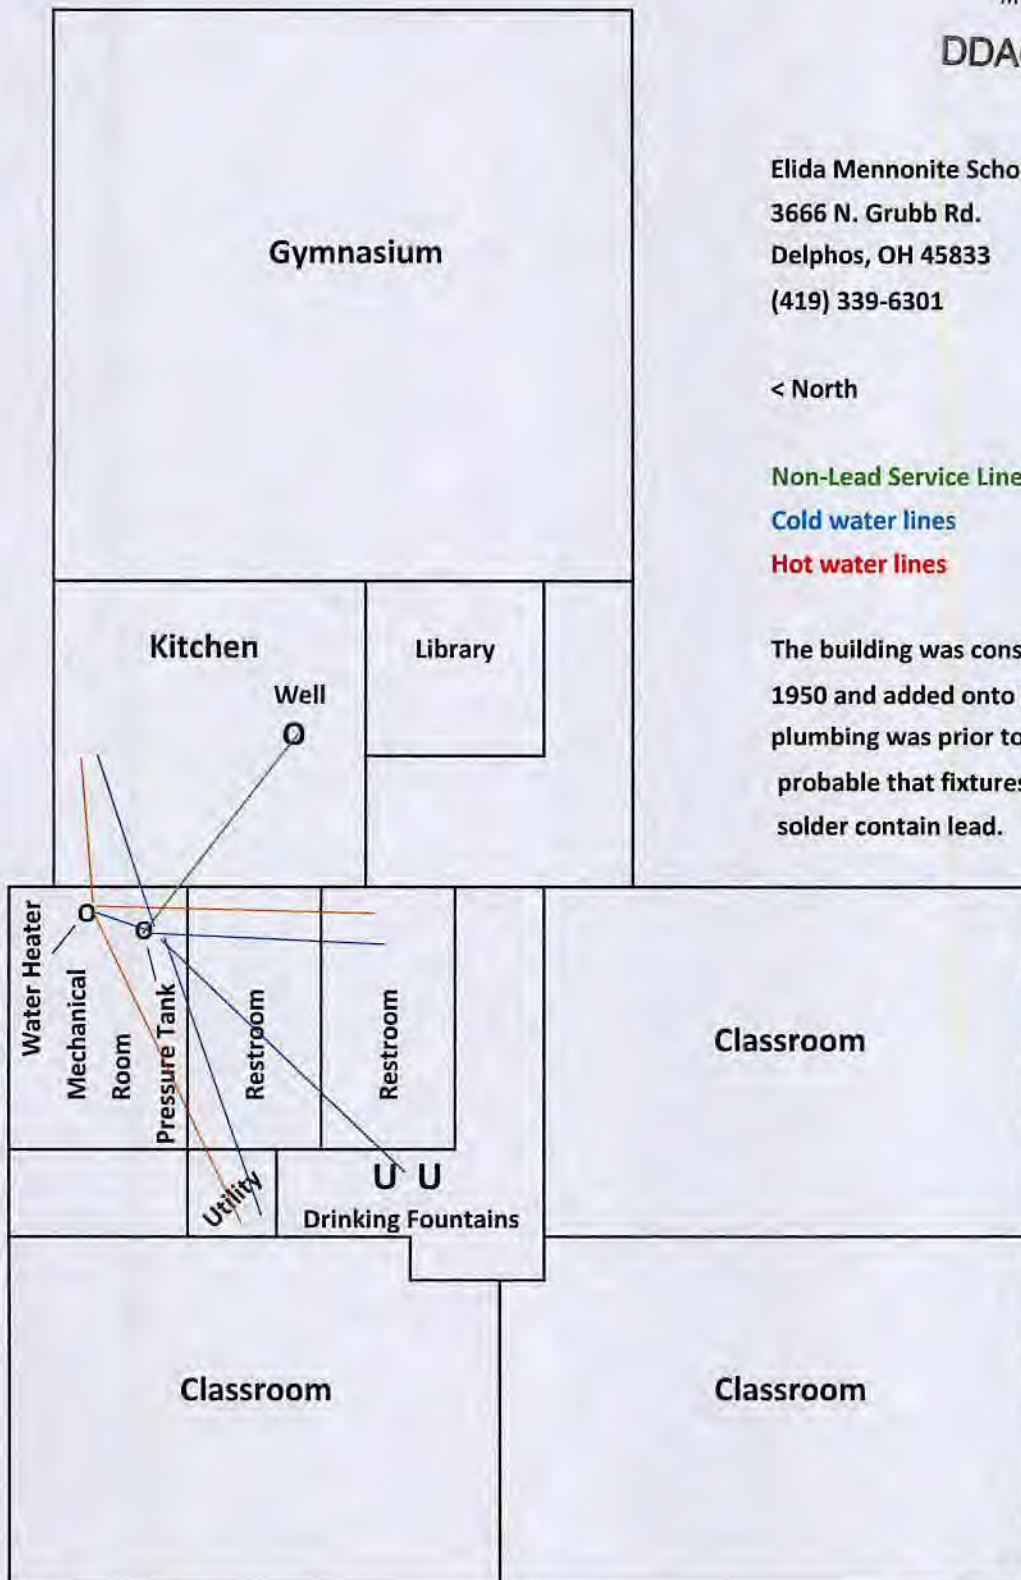

RECEIVED

MAR 06 2017

DDAGW - NWDO

Sample monitoring locations are:

1. Kitchen faucet
2. North restroom faucet
3. South restroom faucet
4. North drinking fountain
5. South drinking fountain

Contact information is: Nelson Bear (419) 230-5257