

RECEIVED

FEB 27 2017

OHIO EPA NEDO



Ed Nyszczycy  
Manufacturing Engineering Manager  
Arresters

**Hubbell Power Systems, Inc.**  
8711 Wadsworth Road  
Wadsworth, OH 44281  
Tel: (330) 335-2361 Ext. 286  
Fax: (330) 334-4114

Date: February 23, 2017

Ohio EPA North East District Office  
2110 E. Aurora Rd.  
Twinsburg, OH 44087

Subject: Lead Mapping in Distribution Systems, Lead/Copper sample site listing

Please find enclosed a water distribution map, outlining lead containing plumbing, solder and fixtures as well as the listing of our sample locations.

The PWS ID for this documentation is: OH5253712 and is located at 8711 Wadsworth Road, Wadsworth Ohio.

If there is any additional information needed please feel free to contact me at 330-335-2361 x 1-286 or [emnyszcz@hubbell.com](mailto:emnyszcz@hubbell.com).


Regards

Ed Nyszczycy

Entity: Hubbell Power Systems  
Doc Type: Report  
Doc Subtype: \_\_\_\_\_  
Program: DDAGW  
County: Medina  
Secondary ID: OH5253712  
EDOC in Color




W-3298

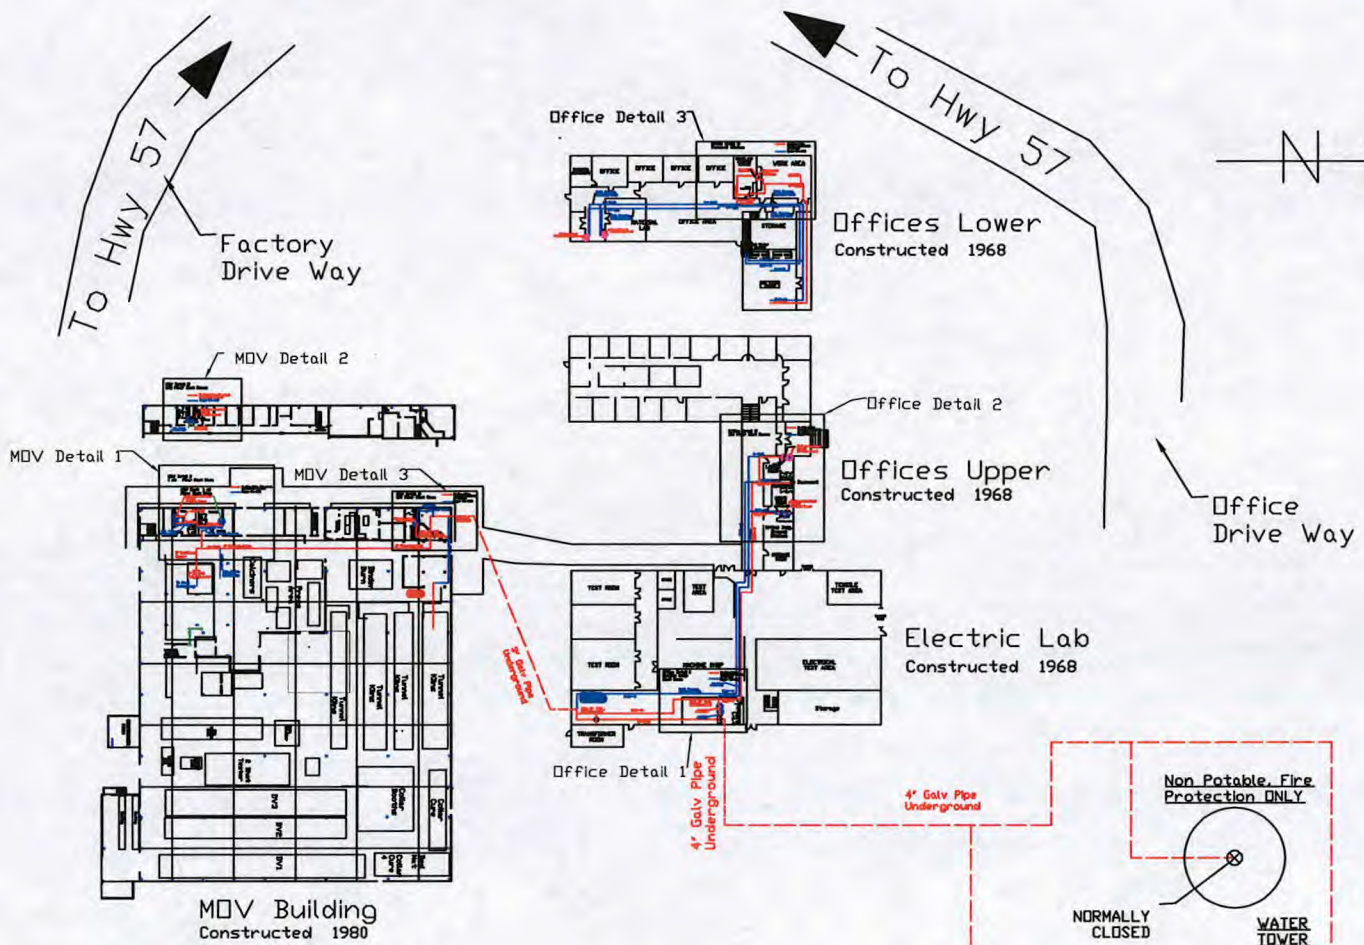

Hubbell Power Systems/Ohio Brass  
 8711 Wadsworth Road  
 Nontransient Non Community  
 PWS ID OH5253712  
 Tel: 330-335-2361

WELL #2  
 41.03804 N  
 81.75845 W

WELL #3  
 41.03854 N  
 81.75745 W

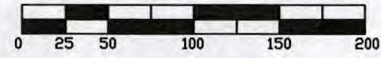

Scale in Ft

- Pb Free Piping, Galvanized, PCV/PEX As Labeled
- Copper Pre 1998

Rev'd	Date	<b>TOLERANCES</b>		<b>OHIO BRASS/HUBBELL</b> DWG: Water Distribution Map DRAFTSMAN: Ed Nyszczy DATE: 2-8-17 FILE: W-3298
		Inch	Millimeter	
		.0 ± .020	.0 ± .50	
		.00 ± .010	.00 ± .25	
		.000 ± .005		
		ANGLES ± 0° 30'		



Office Detail 1  
Machine Shop  
Rest Room

— Pb Free Piping,  
Galvanized, PCV/PEX  
As Labeled

— Copper Pre 1998

Hot, Copper  
Installed 1968

Cold, Copper,  
Installed 1968

Cold →


← Hot

Cold, 2" PVC,  
Installed 2015

Cold →

Cold, 3/4" PEC  
Installed 7-2015

Hot, Copper  
Installed 1968

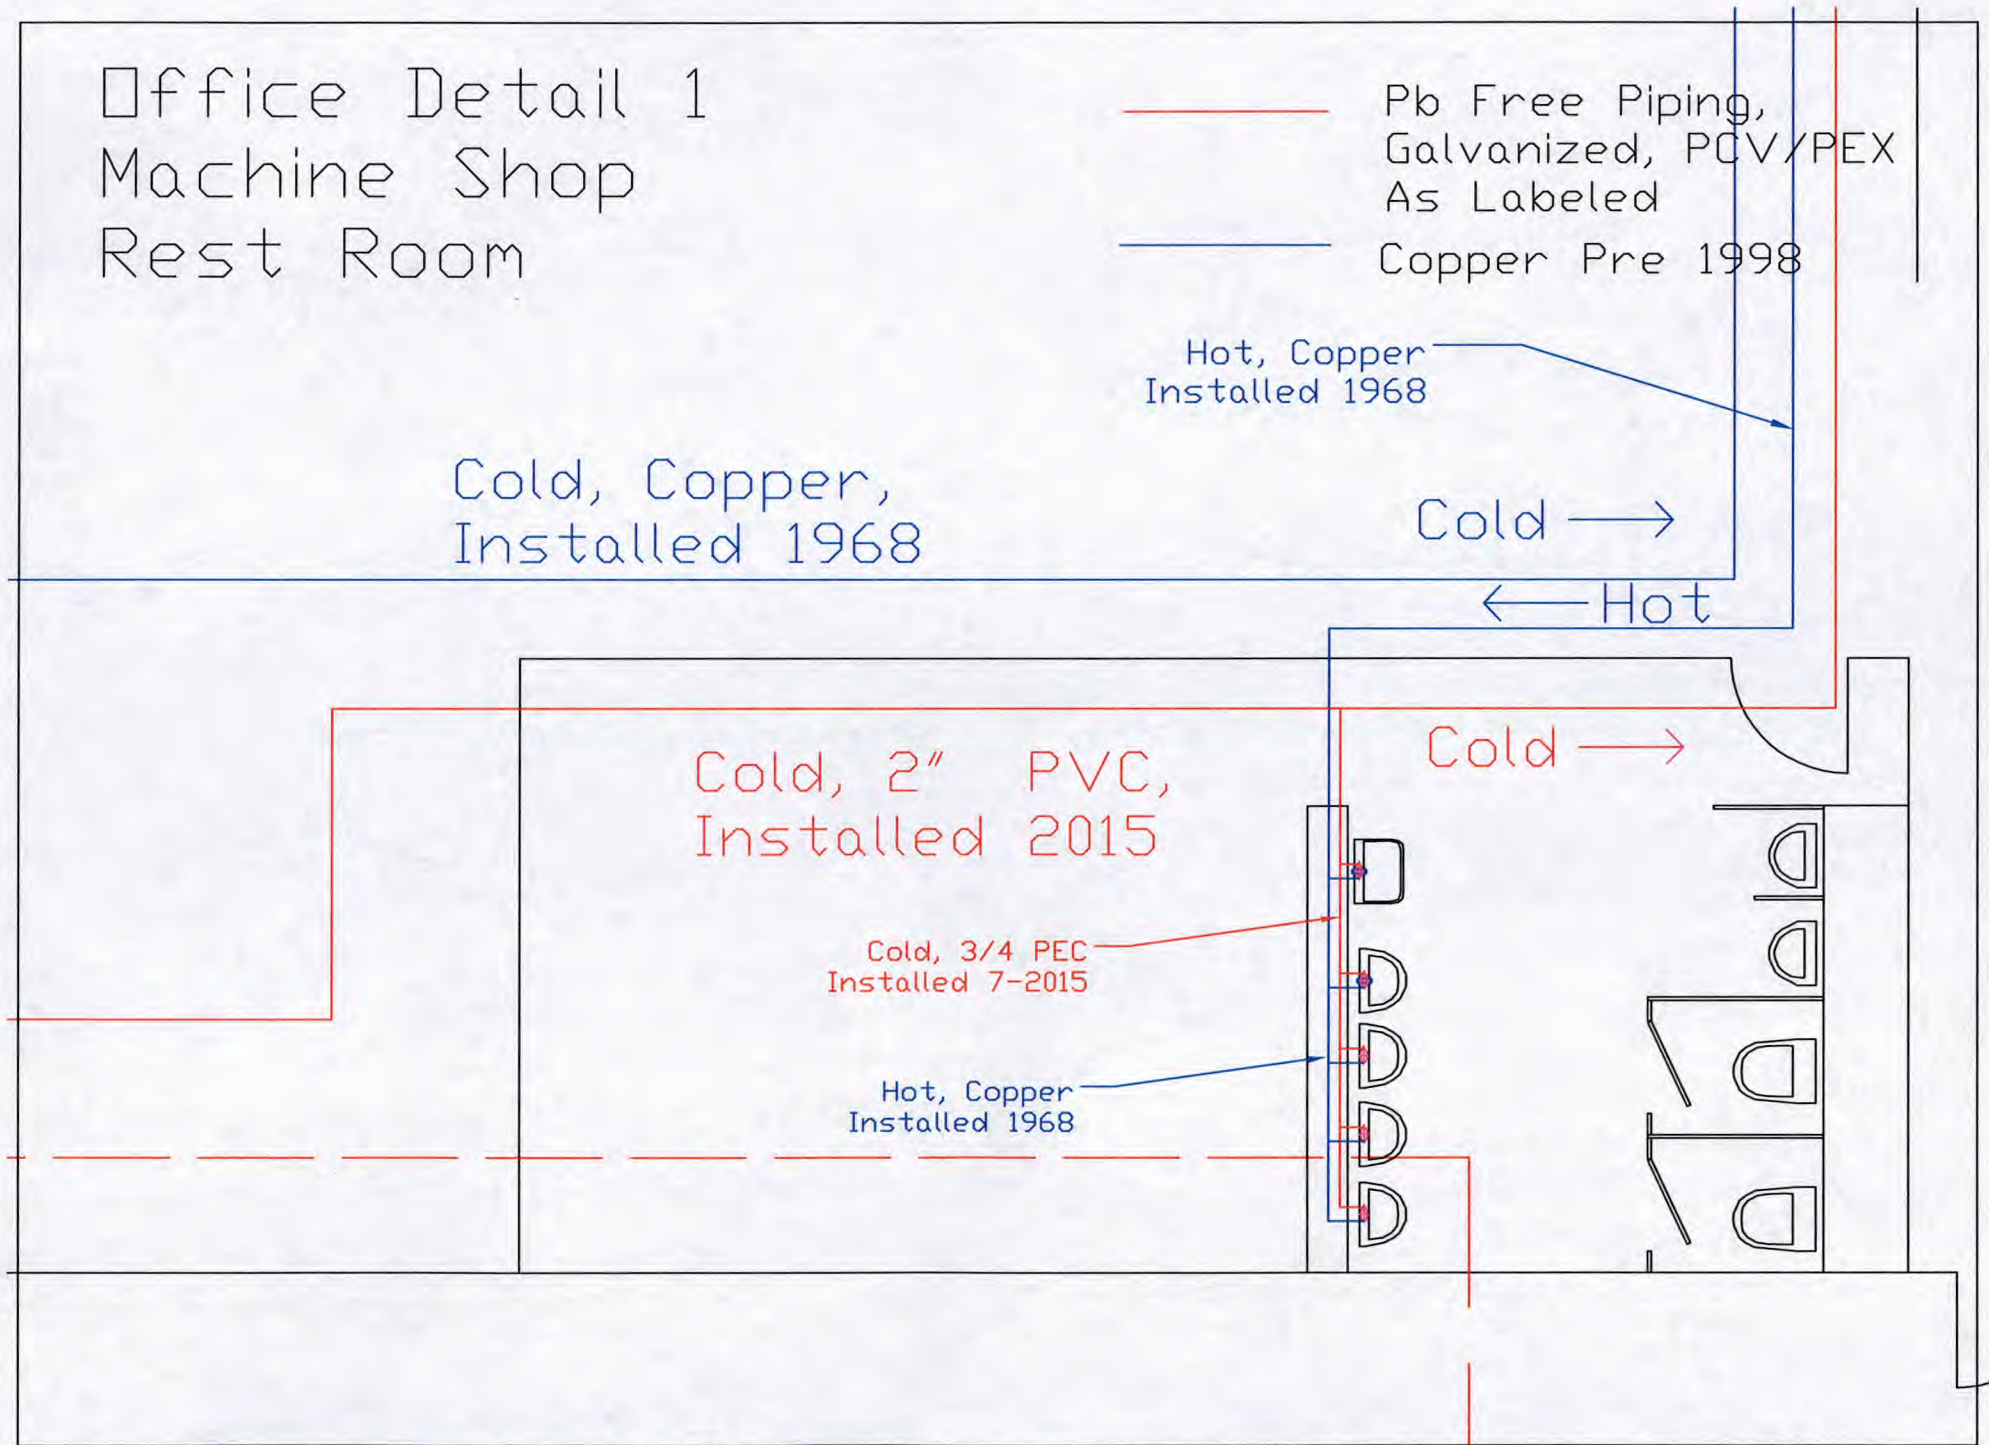



Office Detail 2  
1st Floor Rest Rooms

Pb Free Piping,  
Galvanized, PCV/PEX  
As Labeled  
Copper Pre 1998

Fixture installed  
7-2015  
Pb Free Brass

← Hot

LC203  
Sample Point

LADIES  
ROOM

Cold →

To Basement

Cold →

MEN'S  
ROOM

Fixtures Installed  
7-2015  
Pb Free Brass

LC202 Sample Point

Hot →

Cold →

LC201 Sample Point

Office Bldg,  
Ground  
Kitchen

Cold →

← Hot


Cold →



# Office Detail 3 Basement Kitchen

— Pb Free Piping,  
Galvanized, PCV/PEX  
As Labeled

— Copper Pre 1998

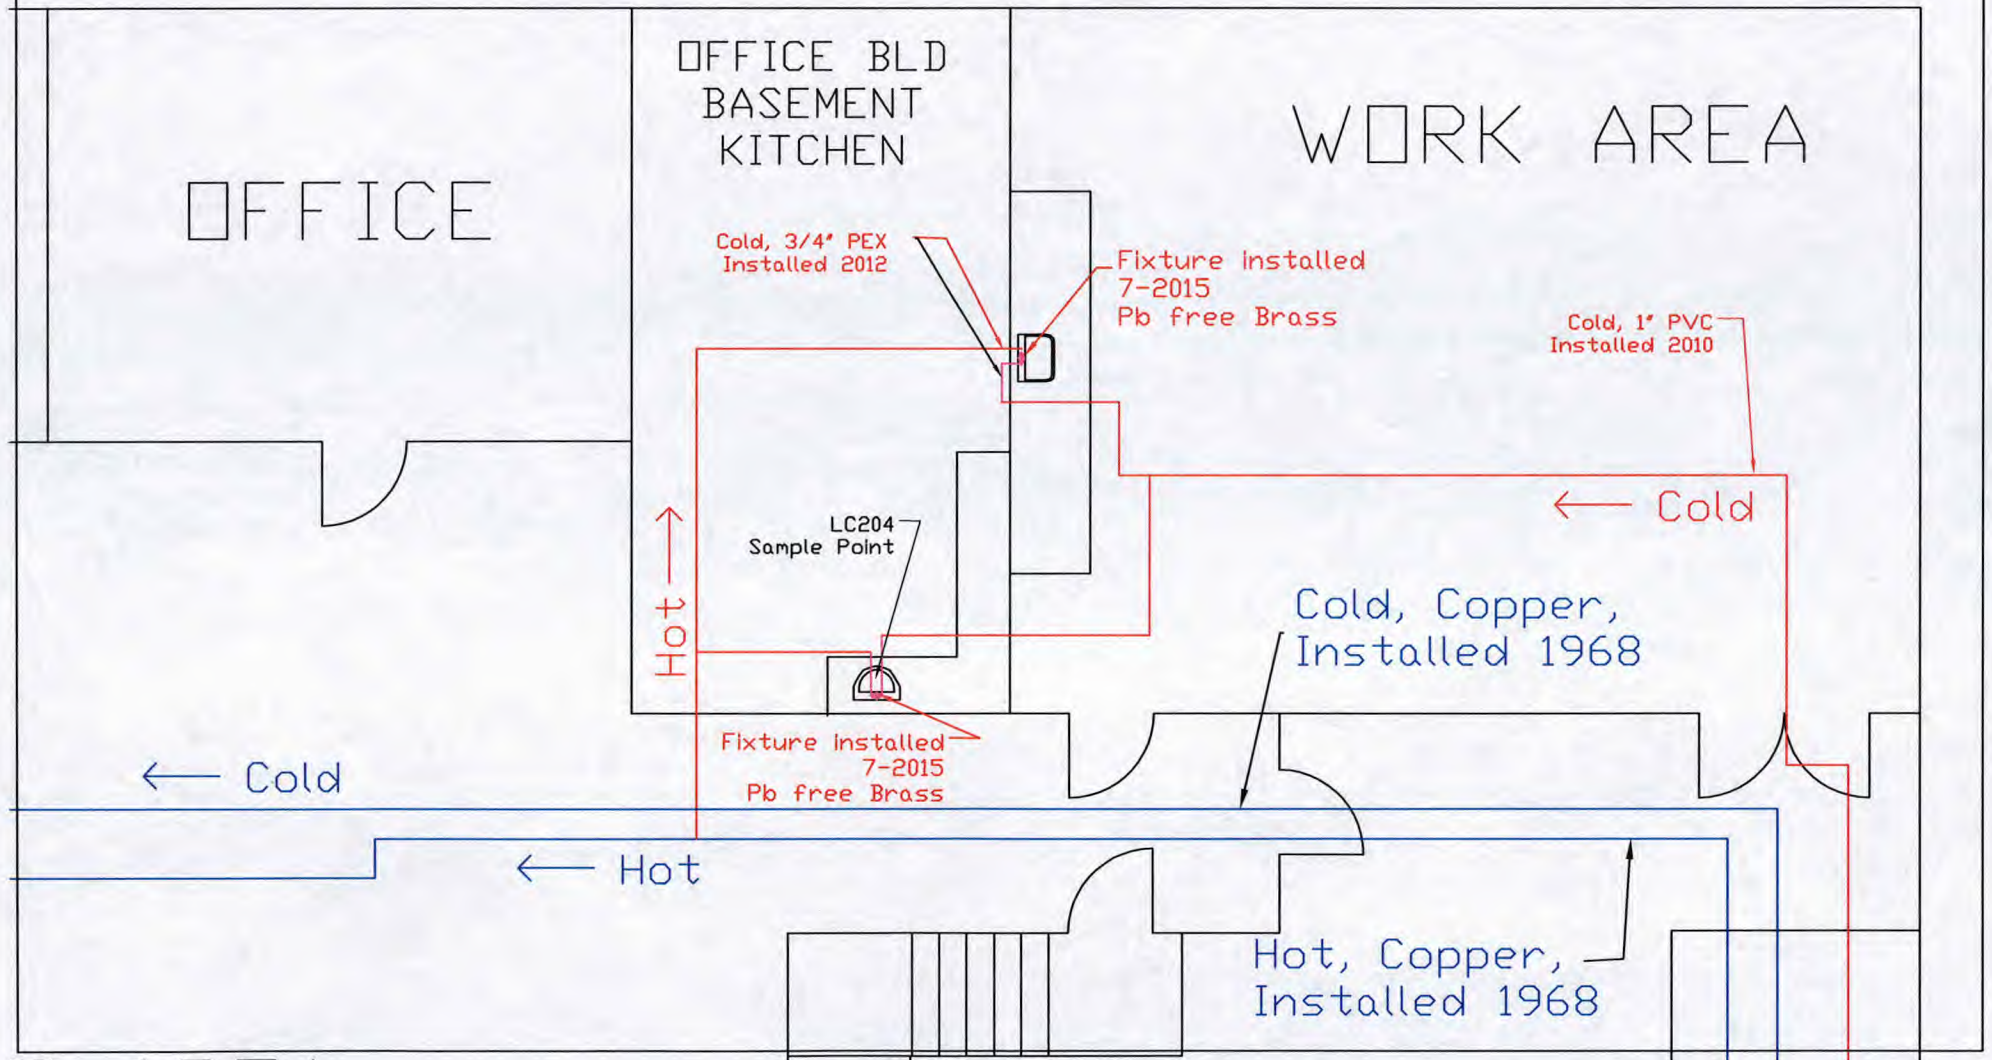




MOV Detail 1  
1 st Floor Rest Room

MOV Rest 1 st  
Floor Rest Room

— Pb Free Piping, Galvanized,  
PCV/PEX As Labeled  
— Copper Pre 1998

Fixtures Installed  
7-2015  
Pb Free Brass

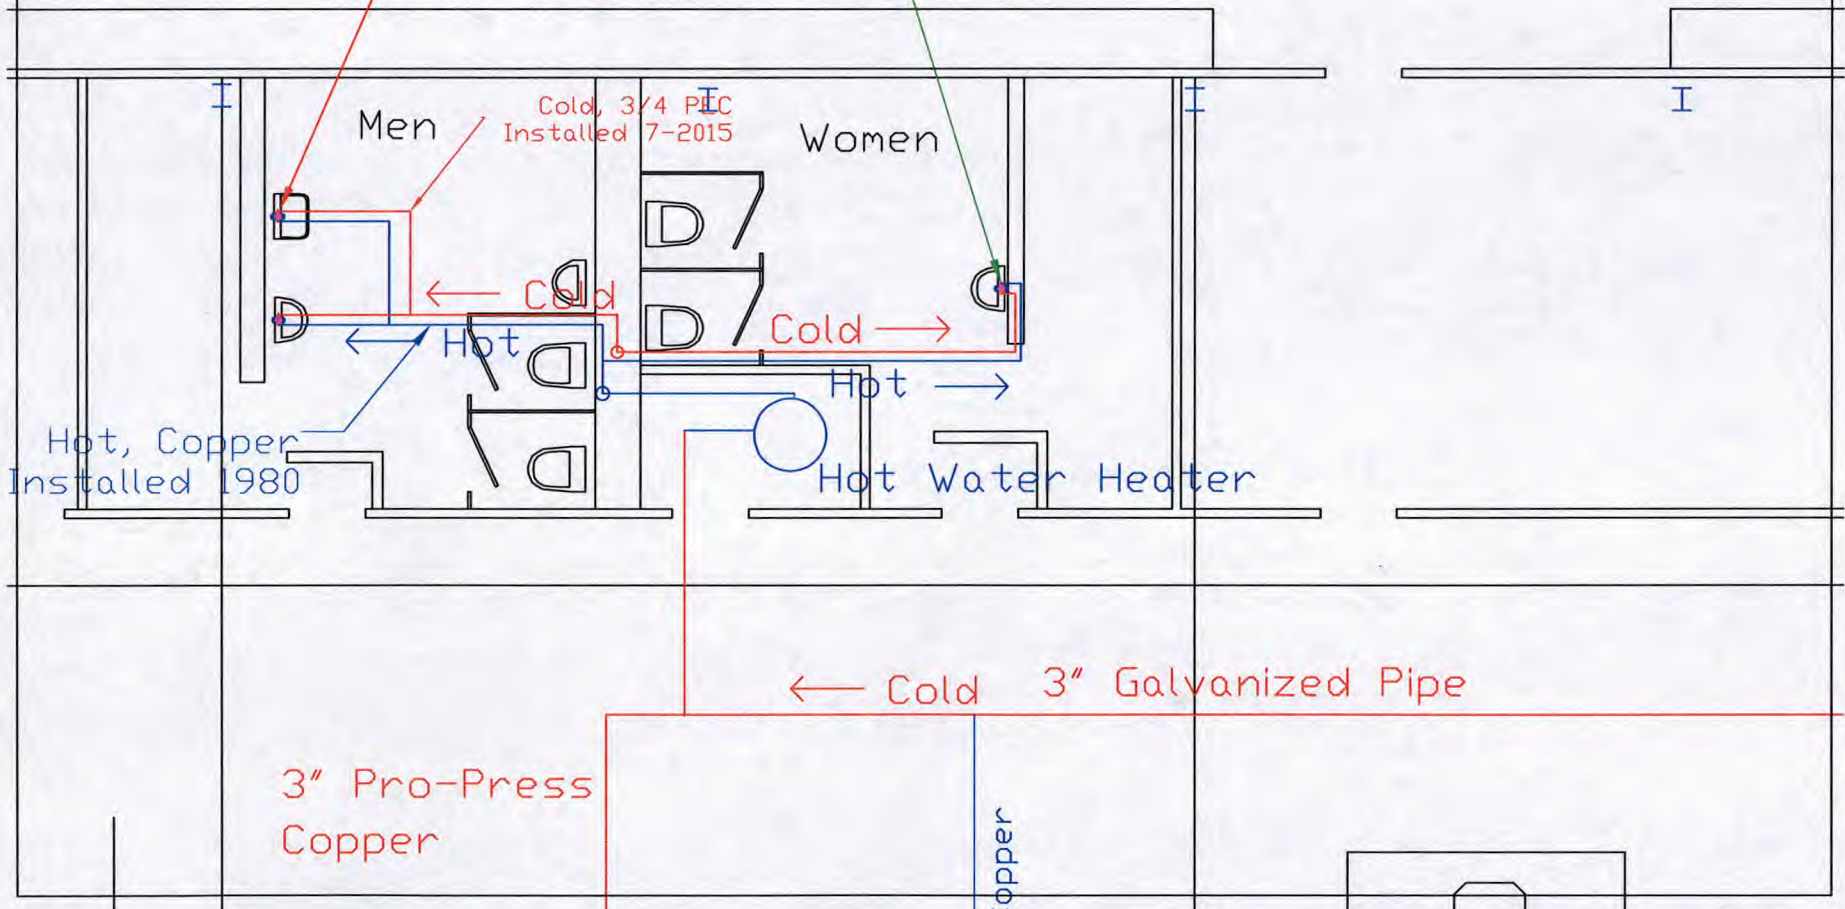

Men

Women

Cold, 3/4" PIC  
Installed 7-2015

← Cold

Hot

Cold →

Hot

Hot Water Heater

Hot, Copper  
Installed 1980

← Cold 3" Galvanized Pipe


3" Pro-Press  
Copper

Copper



# MOV Detail 2

## 2nd Floor Rest Rooms

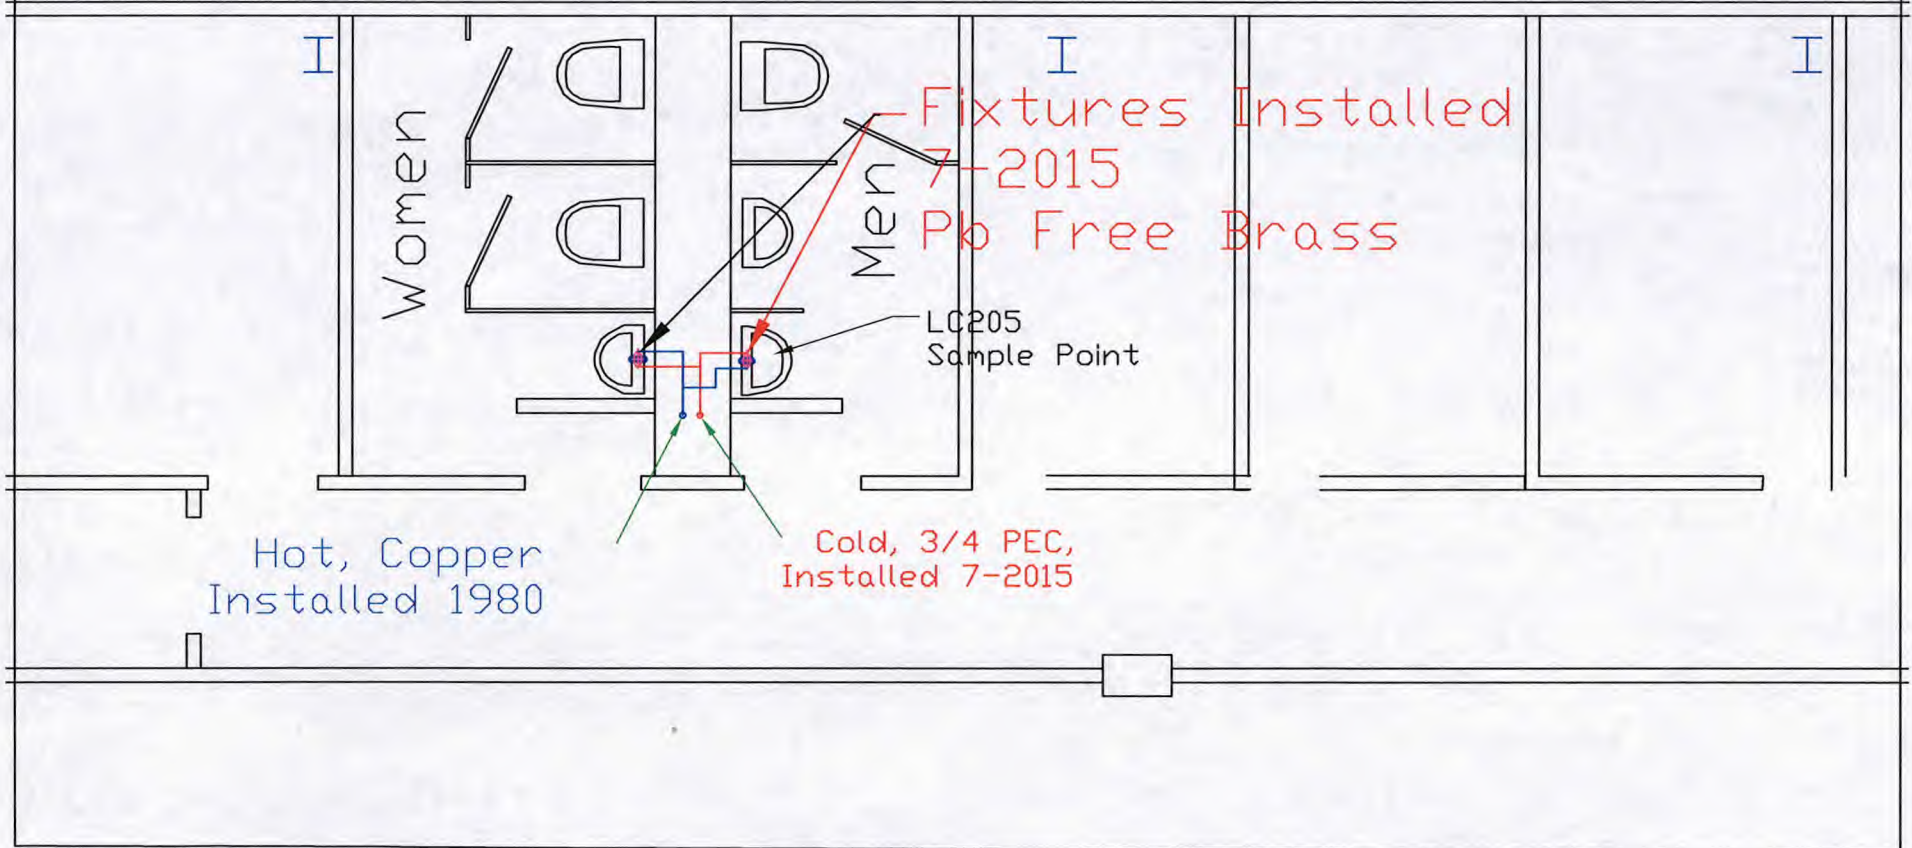



# MOV Detail 3 1st Floor Rest Room

————— Pb Free Piping,  
Galvanized, PCV/PEX  
As Labeled

————— Copper Pre 1998

