



## LEAD MAPPING REPORT FOR CITY OF MEDINA PWS: OH5200514

### METHODOLOGY

Adopting the most conservative approach we indicate areas built prior to 2014 as having the potential for lead in their fixtures and/or services. We marked those addresses that were designated in our Curb Box books as having lead on our side of the customers' services with a solid yellow dot. Due to the age of the records and the number of times they have been transcribed to different media they are not 100% verified. They are however our best indication of what composes the city side of customer services. We have also indicated our Tier 1 lead sampling sites with a solid red dot.


We have marked our mains based on date of installation. We have divided them into three groups: pre-1998 (yellow), 1998-2014 (violet), and post 2014 (green). These are provided to give an indication of the age of the distribution system. It shows what portion of the city was developed as the lead rules changed. It will also show where lines have been replaced in the older sections of the city.

It is the City's practice to replace lead services whenever we come across them during main/service repairs or during replacement projects. We have no official records of what is on the customer's side but we will make that part of our meter work orders to verify what type of service enters the house. This will give us the ability to improve our database as we move forward.

In addition to our map of the city we are including our Lead and Copper SMP IDs, and a list of addresses where we suspect lead services lines on our side based on the notations in our curb box books.



# City of Medina PWS ID OH5200514 Lead Mapping

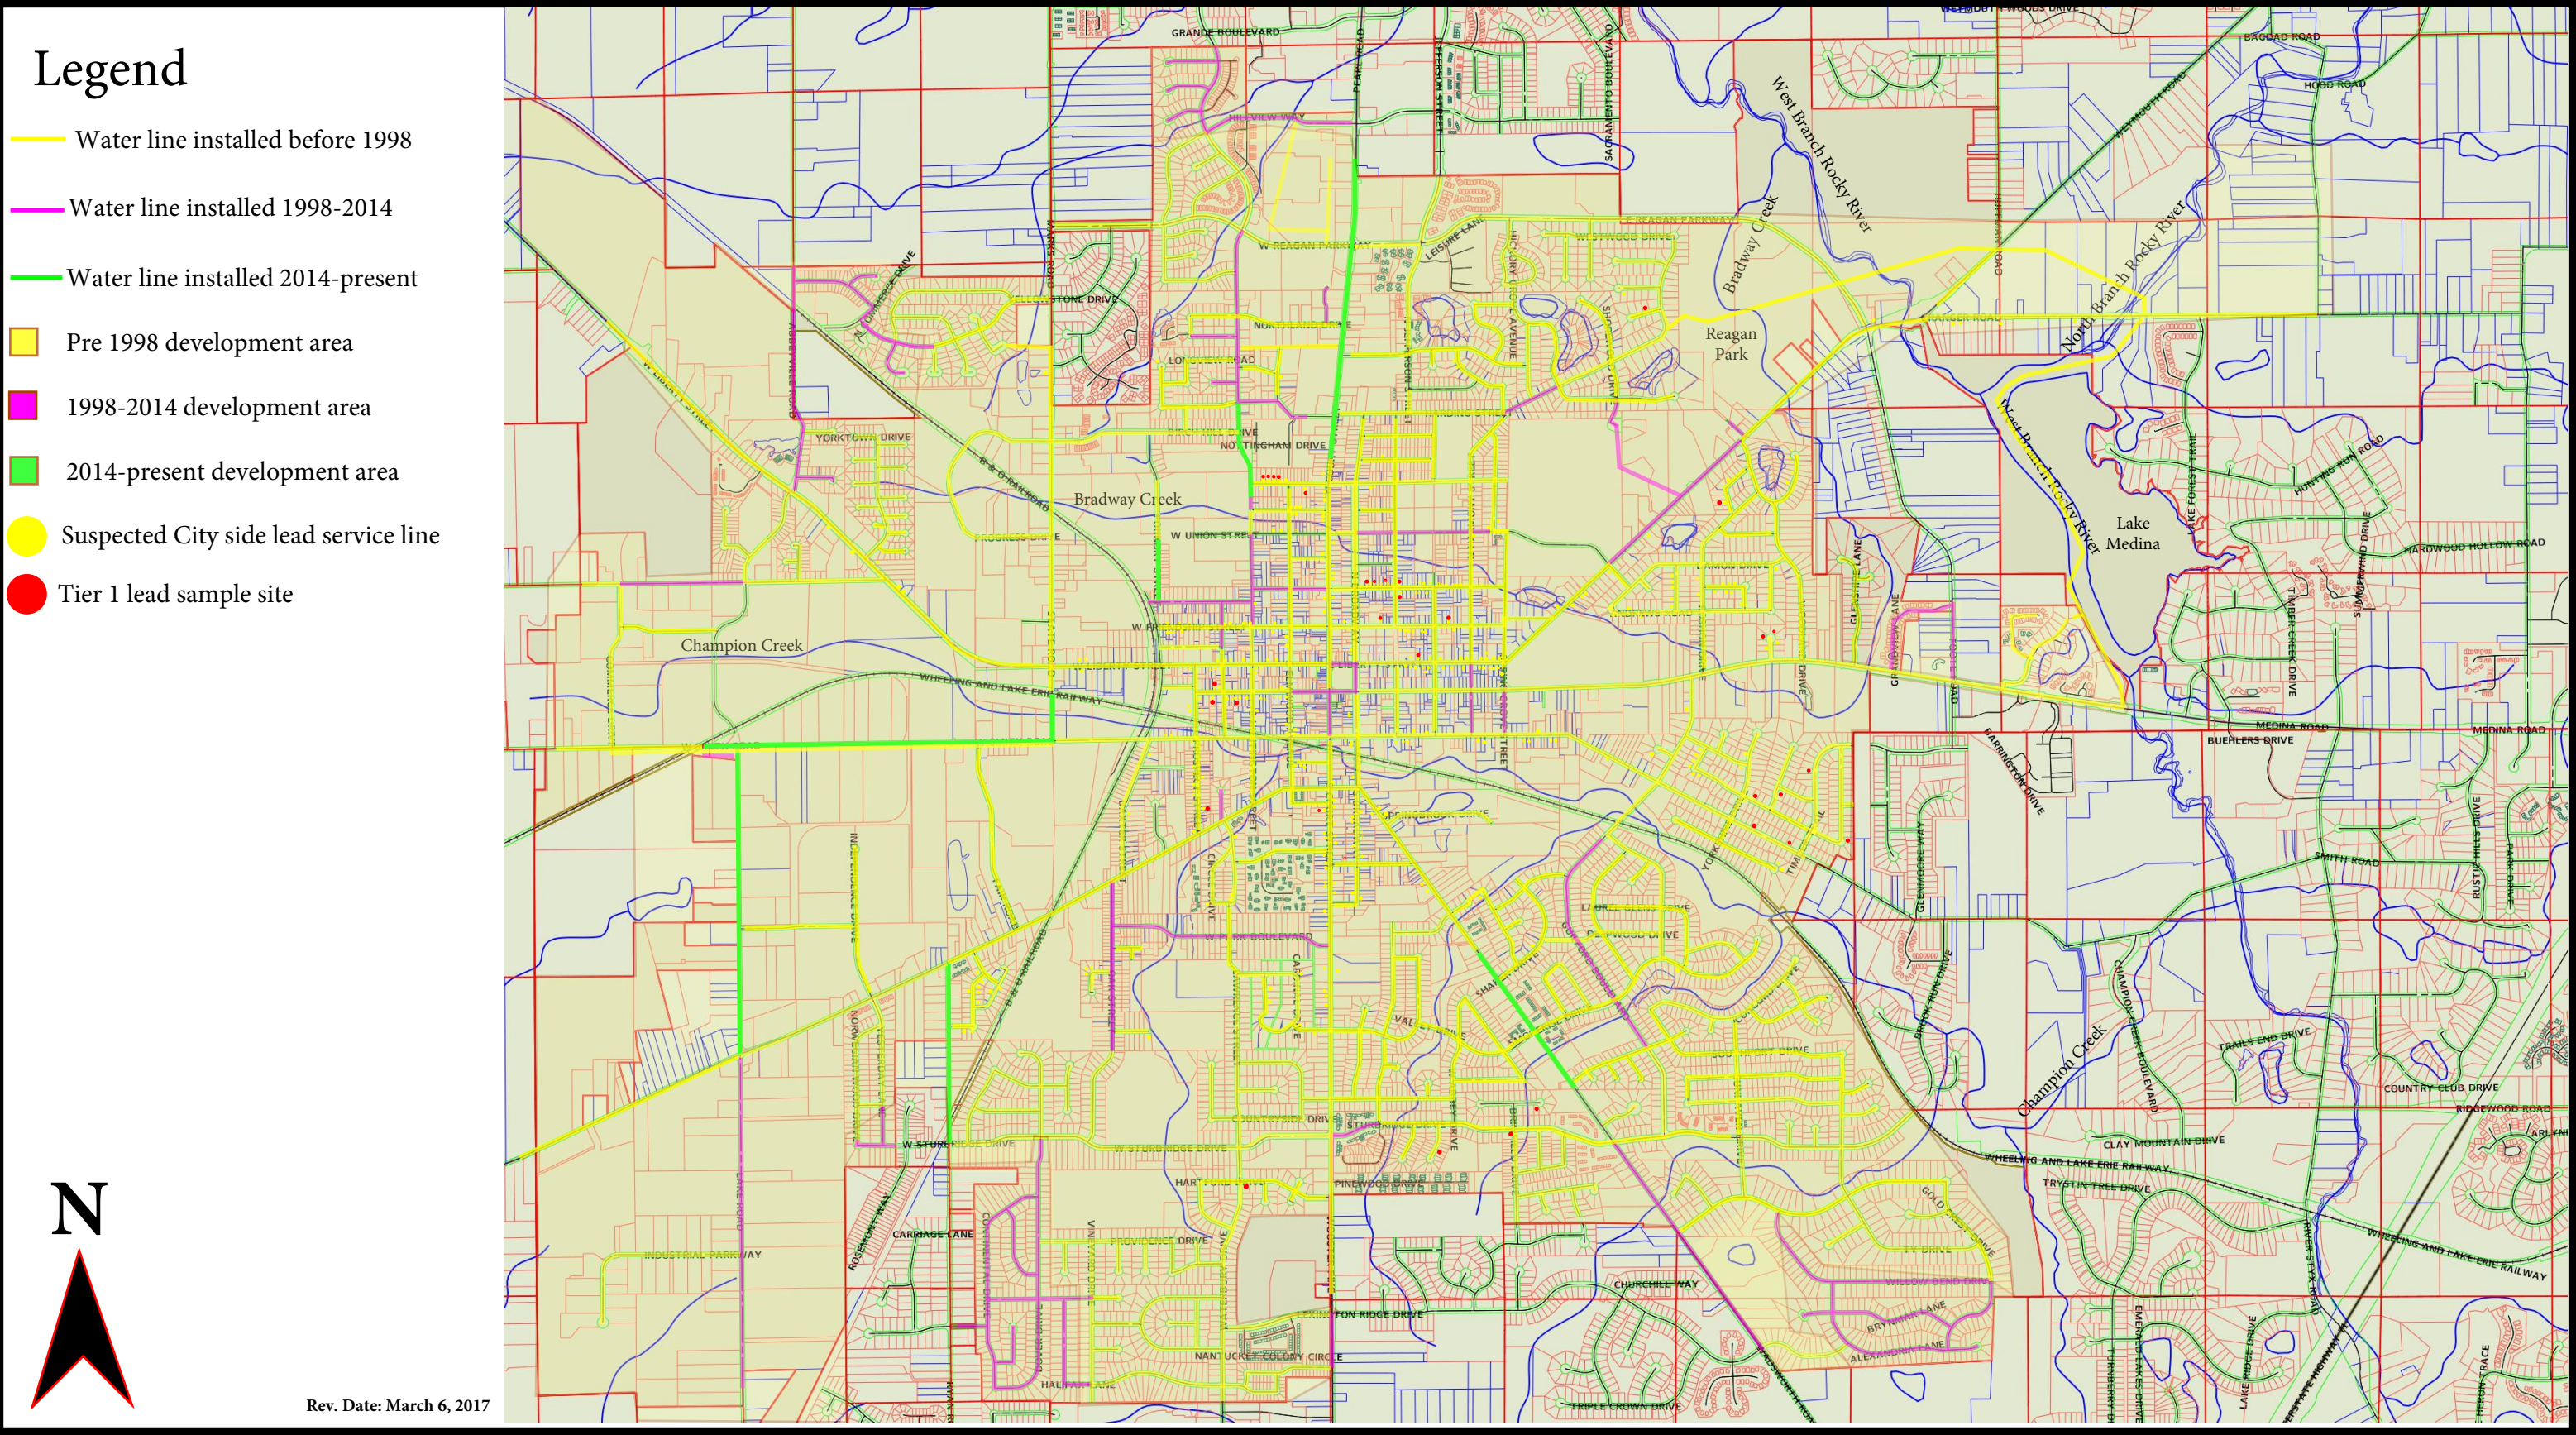

Rev. Date: March 6, 2017