
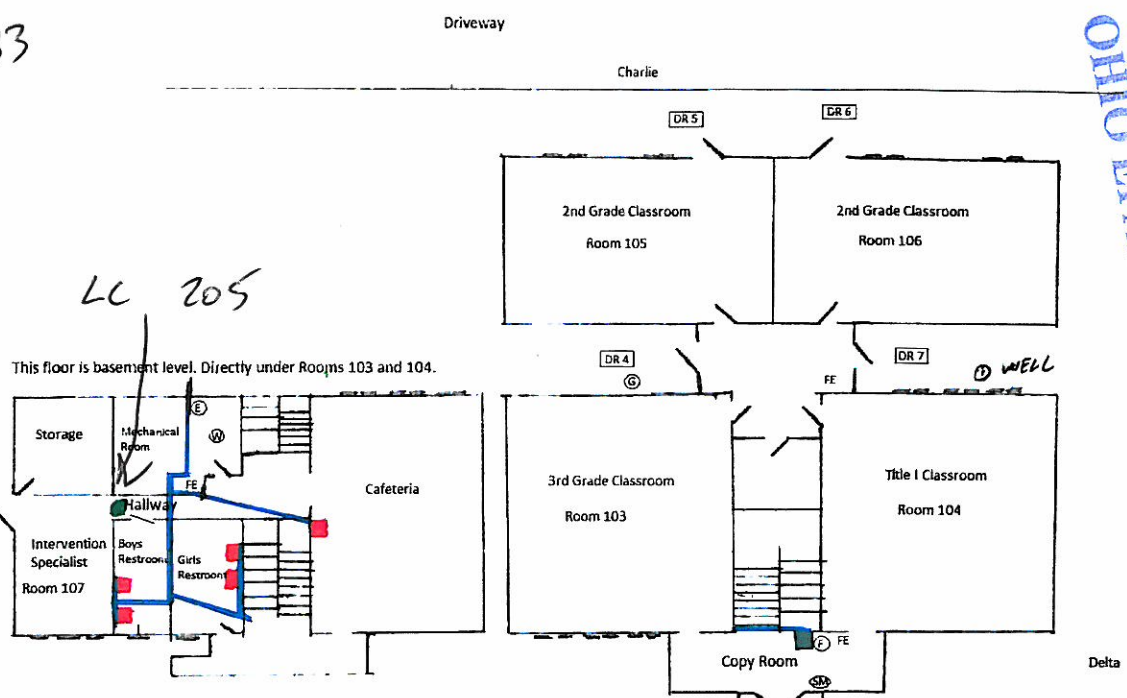


ALL PIPING
WAS INSTALLED
BEFORE 1983

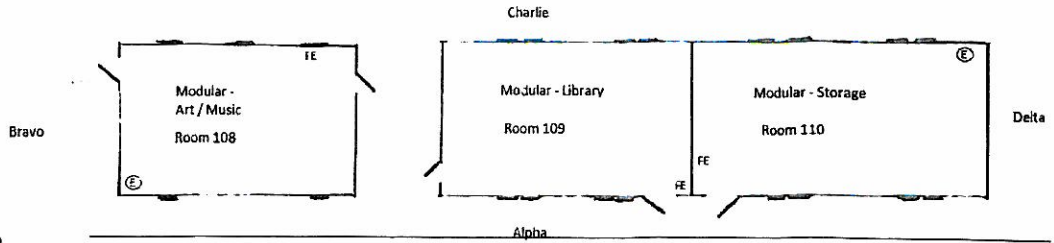

East Holmes Local Schools

OH.3832412

Flat Ridge Elementary School
2609 CR 600
Charm, OH 44617


IRN: 065672
Phone: 330-893-3156

Emergency contacts:
Casey Travis, Principal
330-440-3069

Troy Phillips, Maintenance
330-432-7940

- Location of AED
- Electrical Shutoff
- Fire Alarm Panel
- Gas Shutoff
- Knox Box
- Water Shutoff
- Exterior Doors
- Fire Extinguisher
- Security Monitoring Control

- SINKS
- DRINKING FOUNTAIN
- COPPER
- PLASTIC

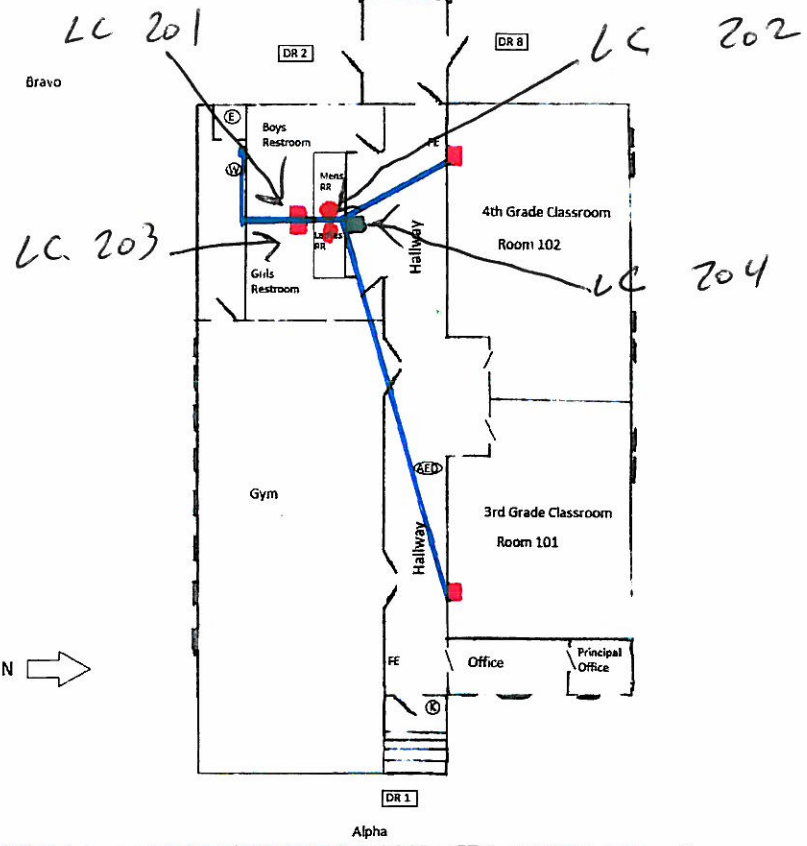

County Road 600

RECEIVED
 MAR 06 2017
 OHIO RANEDO