


BUILDING HAS GALVANIZED PIPING


Entity: Lakville Elem  
 Doc Type: RIPR  
 Doc Subtype: \_\_\_\_\_  
 Program: \_\_\_\_\_  
 County: Holmes  
 Secondary ID: 243832912

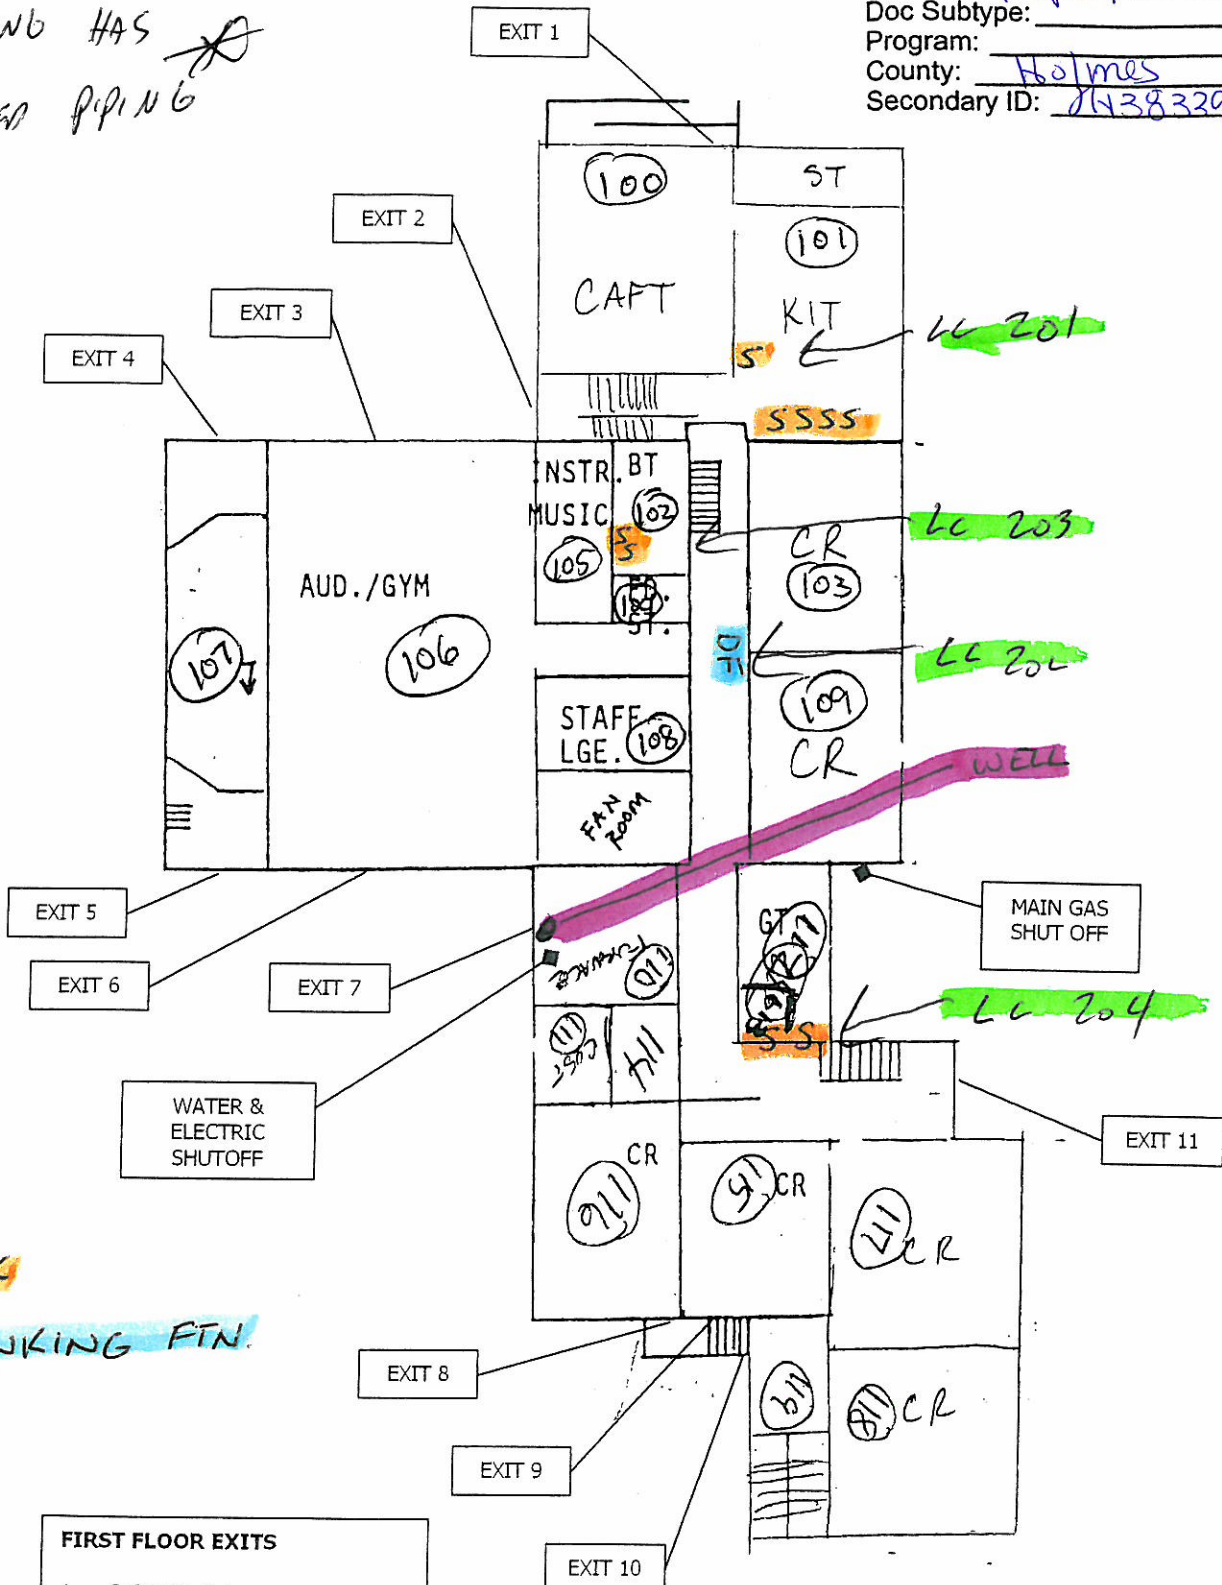


S - SINK

DF - DRINKING F.T.N.

- FIRST FLOOR EXITS**
- 1 Cafeteria Exit
  - 2 97 Addition Exit
  - 3 East Gym Exit
  - 4 East Stage Exit
  - 5 West Stage Exit
  - 6 West Gym Exit
  - 7 Furnace Room Exit
  - 8 Room 116 Exit
  - 9 Room 115 Exit
  - 10 85 Addition Exit
  - 11 South Exit

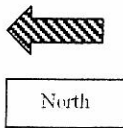


**Lakville Elementary School**  
 14059 State Route 226  
 Lakerville, Ohio 44638  
 (419) 827-2006  
 IRN 019679

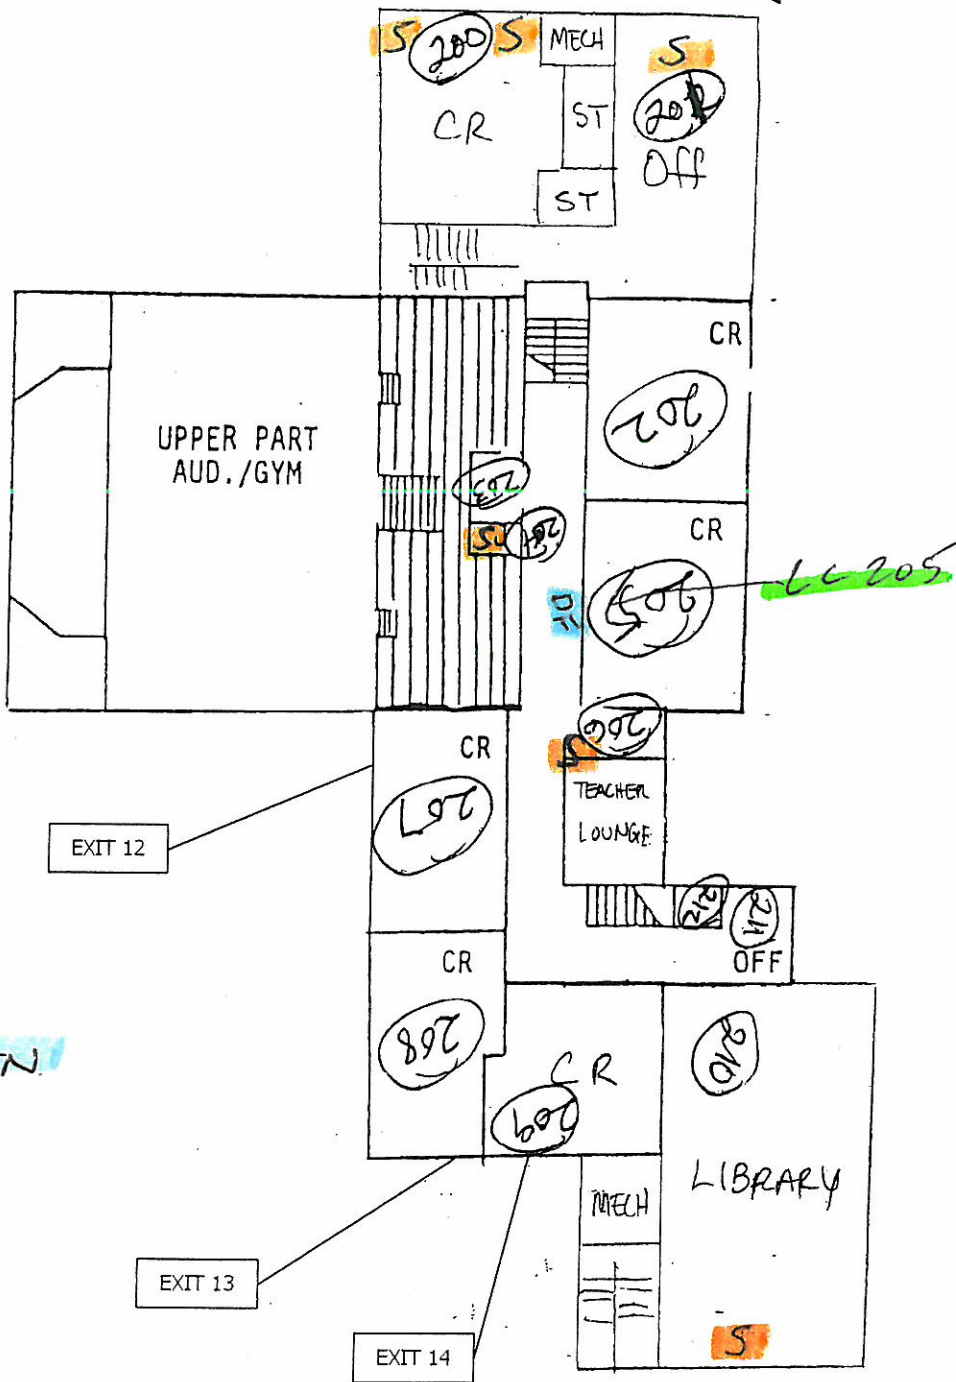

S - SINK

DF - DRINKING FTN.

SECOND FLOOR EXITS	
12	Room 207 Fire Escape Exit
13	Room 208 Fire Escape Exit
14	Room 209 Fire Escape Exit

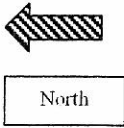

Lakeville Elementary School  
 14059 State Route 226  
 Lakeville, Ohio 44638  
 (419) 827-2006  
 IRN 019679



March 6, 2017

RECEIVED  
MAR 06 2017  
BY:.....

Ohio EPA  
Northeast District Office  
2110 East Aurora Road  
Twinsburg, OH 44087  
330.963.1200

Dear Mr. Henn,

Per our conversation on Monday, March 6, 2017, we are not aware of any lead pipes coming into either Hartville Elementary, and/or Lake Elementary.

Hartville Elementary was built in 1926, and Lake Elementary was built 1954, 1958, and 1965.

Sincerely,

A handwritten signature in black ink, appearing to read "Chris Eliopoulos".

Chris Eliopoulos, Director  
Operations/Transportation  
Lake Local School District

13188 Kent Ave. NE, Hartville OH 44632  
Phone 330.877.4275\*Fax 330.877.4749

Vision: To be the best organization for learning.

Mission: Providing education to achieve success

Values: Responsibility, honesty, respect, integrity, citizenship, commitment, our community, our partnerships, and every person as a unique individual with the ability to acquire and apply knowledge.