

EH 505 4412



RECEIVED
MAR 06 2017
OHIO EPA NEDO

To whom it may concern,

I am writing this letter in regards to the water situation at ISLE's Purple Cat located at 4738 McCartney Rd. Coitsville, Ohio. The Purple Cat is a day program for adults with disabilities where we focus on teaching job skills that translate into community employment and having fun.

We use the water for our restrooms, hand washing, washing clothes and washing dishes. We do not consume the water. Our well was installed in 2008 by Book & Book Well Drilling. In 2009 they installed a constant pressure pump. All our service lines were installed after the 1986 service line bans. The well that was installed in 2008 feeds the building through a PVC service line and is the predominant service line to our program. We also utilize a water softener and an iron filter (media is katalox light).


I hope this information helps to answer your questions.

Marc Saculla

A handwritten signature in black ink that reads 'Marc Saculla'.

Purple Cat Administrator

Purple Cat Water Supply Map

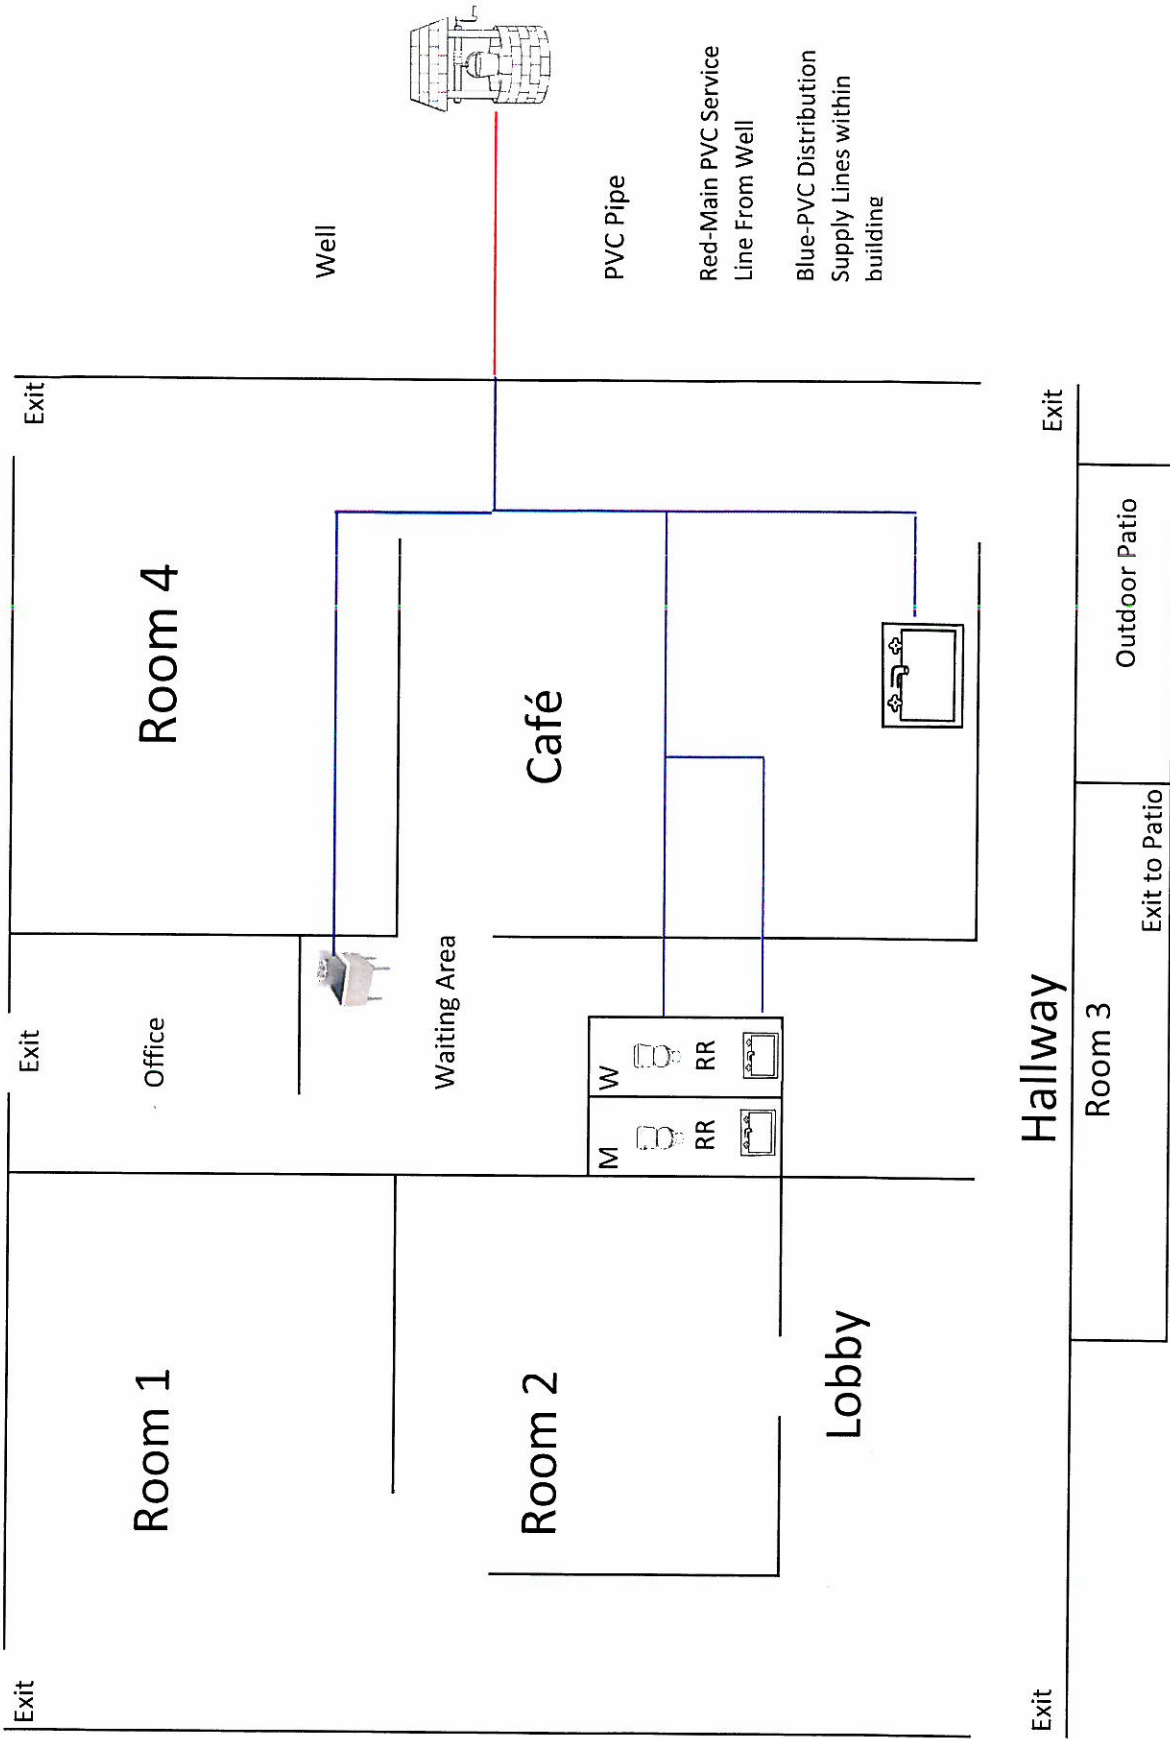

Exit

Exit

Exit

Room 1

Office


Room 4

Well


Waiting Area

Room 2

Café

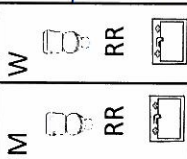

Lobby

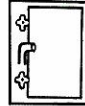

PVC Pipe

Red-Main PVC Service Line From Well

Blue-PVC Distribution Supply Lines within building

Hallway

Exit

Exit

Room 3

Exit to Patio

Outdoor Patio



Marc Saculla <marc@goldenstringradio.org>

(no subject)

Zmith, Linda <LZmith@mahoninghealth.org>
To: "marc@bigpurplecat.com" <marc@bigpurplecat.com>

Tue, Feb 14, 2017 at 1:25 PM

We have a plumbing permit issued in 2009 – a rough inspection was done on 4/6/2009 and a finish on 6/9/2009; however, we only keep records for five years and 2009 records have been destroyed.

A plumbing permit issued in 2015 was when you tied into sanitary sewer – an inspection was done 12/2/2015. A drawing was not needed for this work.

We do not have a well permit for this address. You can check with the Ohio Dept. of Natural Resources [614/265-6638](tel:6142656638) for all well logs

Linda C. Zmith

Secretary, Environmental Division

Mahoning County District Board of Health

50 Westchester Drive – Suite 202

Youngstown, Ohio 44515

Phone: 330/270-2855 Ext. 102

Fax: 330/270-2859

lzmith@mahoninghealth.org

www.mahoninghealth.org



Public Health
Prevent. Promote. Protect.
**Mahoning County
District Board of Health**



NOTICE OF CONFIDENTIALITY: This message and any response(s) to it may constitute a public record; it may be subject to disclosure upon a public record request or as required by a judicial order (Ohio public records law - ORC 149.43) This email message, including any attached files, is intended only for the person or entity to whom it is addressed and may contain confidential and/or privileged material. If the reader of this message is not the intended recipient, or the employee or agent responsible for delivering this communication to the intended recipient, you are notified that any review, use, distribution, dissemination, downloading, copying or disclosure is strictly prohibited. All health information **MUST** be protected. Any protected health information (PHI) enclosed is protected by Federal confidentiality rules (42 CFR Part 2) and/or Ohio law