

Preferred Airparts, LLC


Div. of JILCO Industries Inc.

PO Box 12
11234 Hackett Rd.
Kidron, OH 44636
Tel. 330-698-0280 Ext 234
U.S. & CAN 800-433-0814
FAX 330-698-3165

RECEIVED

MAR 06 2017

OHIO EPA NEDO

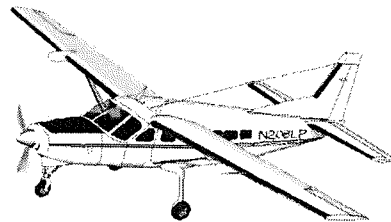

Off 85763412


Ohio EPA - Division of Drinking and Ground Waters Information Request

Bio- Preferred Airparts has become a leading supplier of New Surplus and used aircraft parts for nearly anything that flies. Cessna parts are a mainstay here at Preferred but we also constantly buy new surplus inventories of Piper, Continental and Lycoming parts as well, along with many others.

Mapping info- The 22,500-square foot shipping building was built in 1989 and houses the dual tank filters for water treatment. Sample location #LC203 is in this building. A 3,400-square foot sales and administrative building was added in 2007 where sample locations LC 201, 202, 204, NS 205 are located. Plumbing throughout both buildings are copper with brass fixtures.

Thank you,

Jeff Ullom
Human Resources
Preferred Airparts, LLC
Kidron, Ohio
330-698-0280 ext 234
800-433-0814 ext 234
Jeff@preferredairparts.com
www.preferredairparts.com

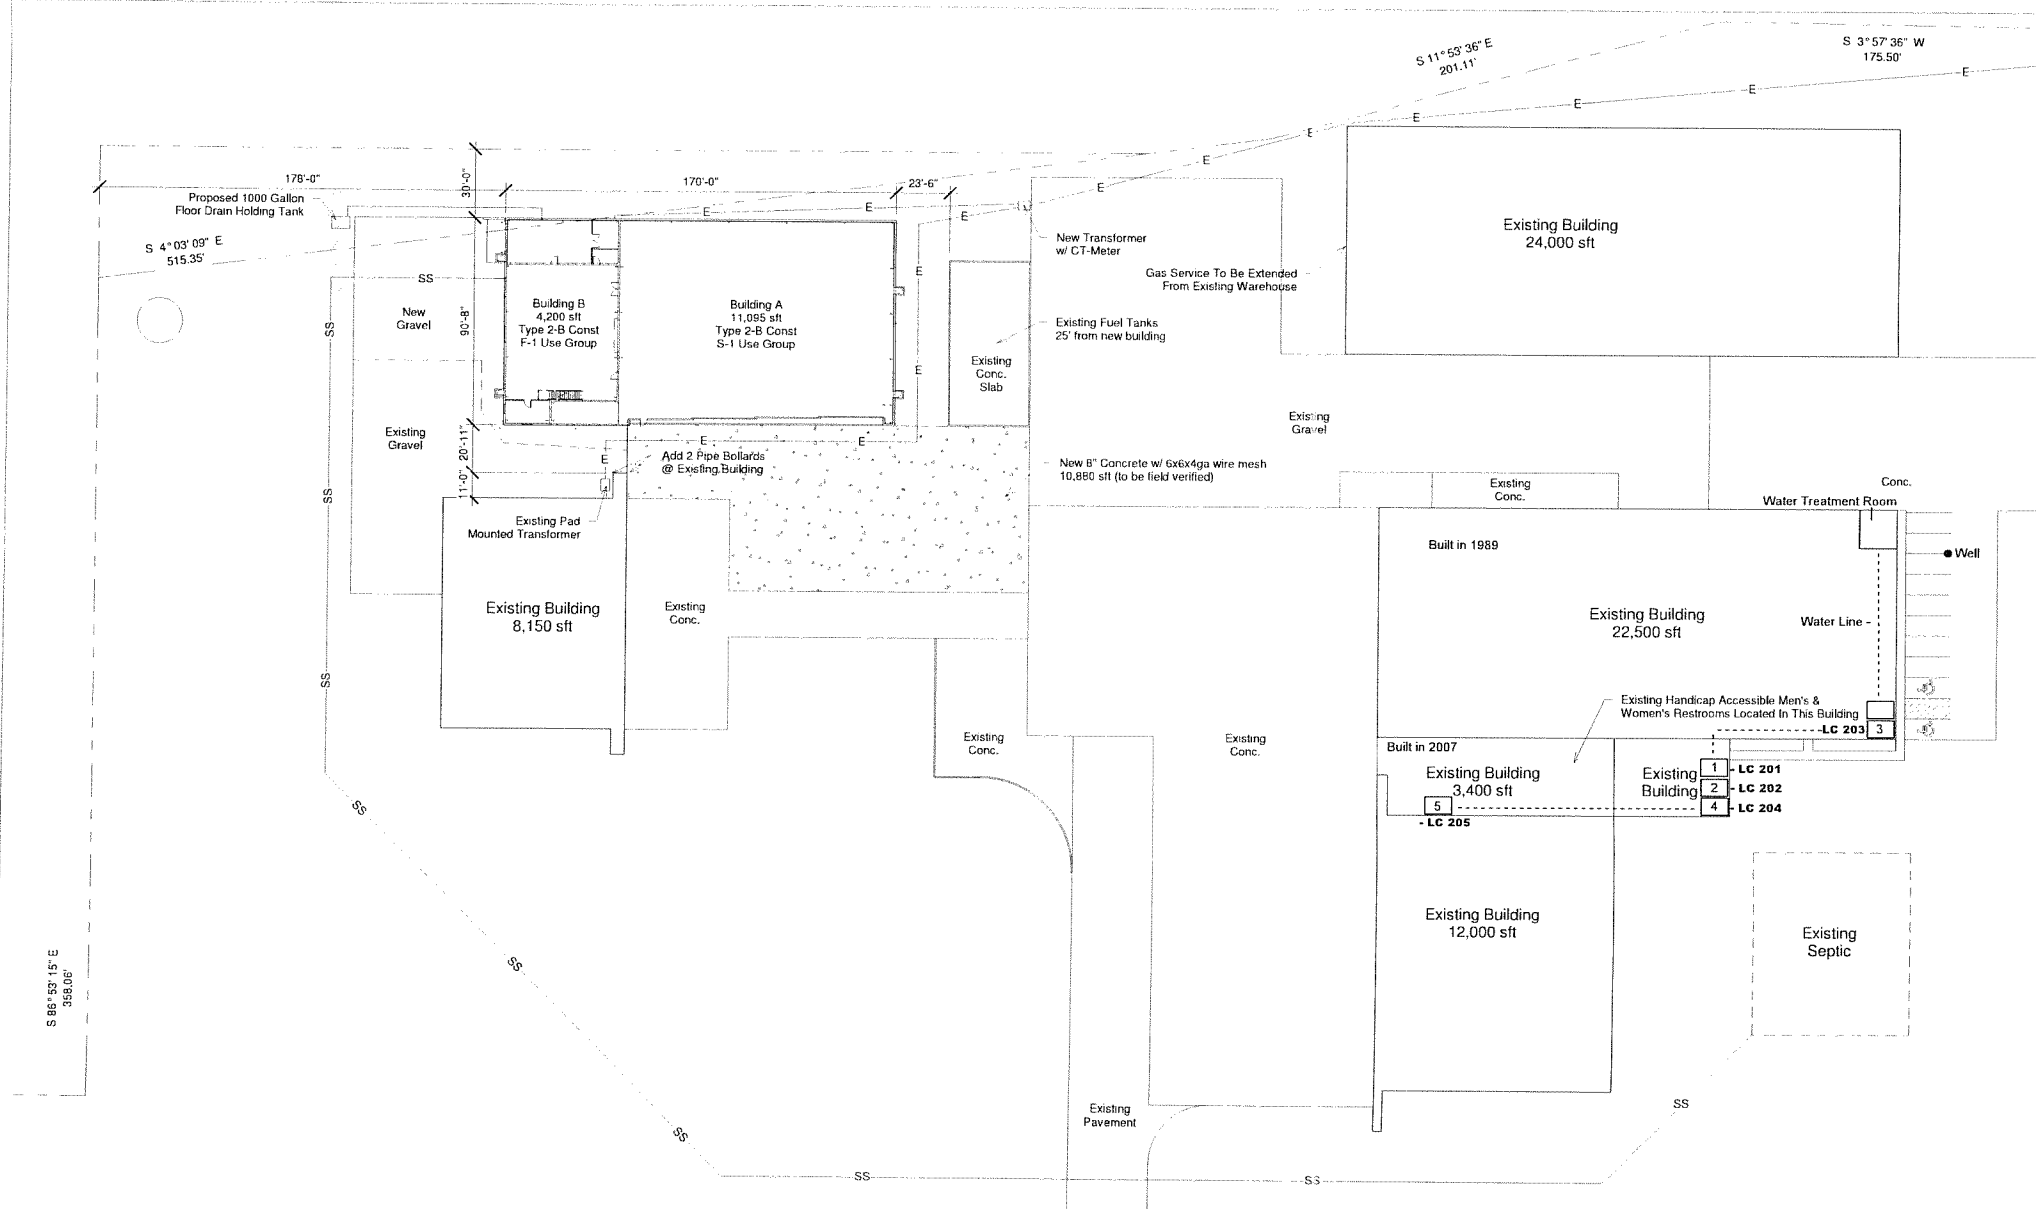

Proposed 1000 Gallon Floor Drain Holding Tank

Building B
4,200 sft
Type 2-B Const
F-1 Use Group

Building A
11,095 sft
Type 2-B Const
S-1 Use Group

Existing Building
24,000 sft

Existing Building
8,150 sft

Existing Building
22,500 sft

Existing Building
3,400 sft
- LC 205

Existing Building
12,000 sft

Existing Building
1 - LC 201
2 - LC 202
3 - LC 204
4 - LC 204

Existing Septic

Water Treatment Room

Well

Existing Handicap Accessible Men's & Women's Restrooms Located In This Building - LC 203

Existing Pavement