



TRINIDAD JR HIGH  
BUILT IN 1972  
SINKS WERE  
UPDATED IN  
1991

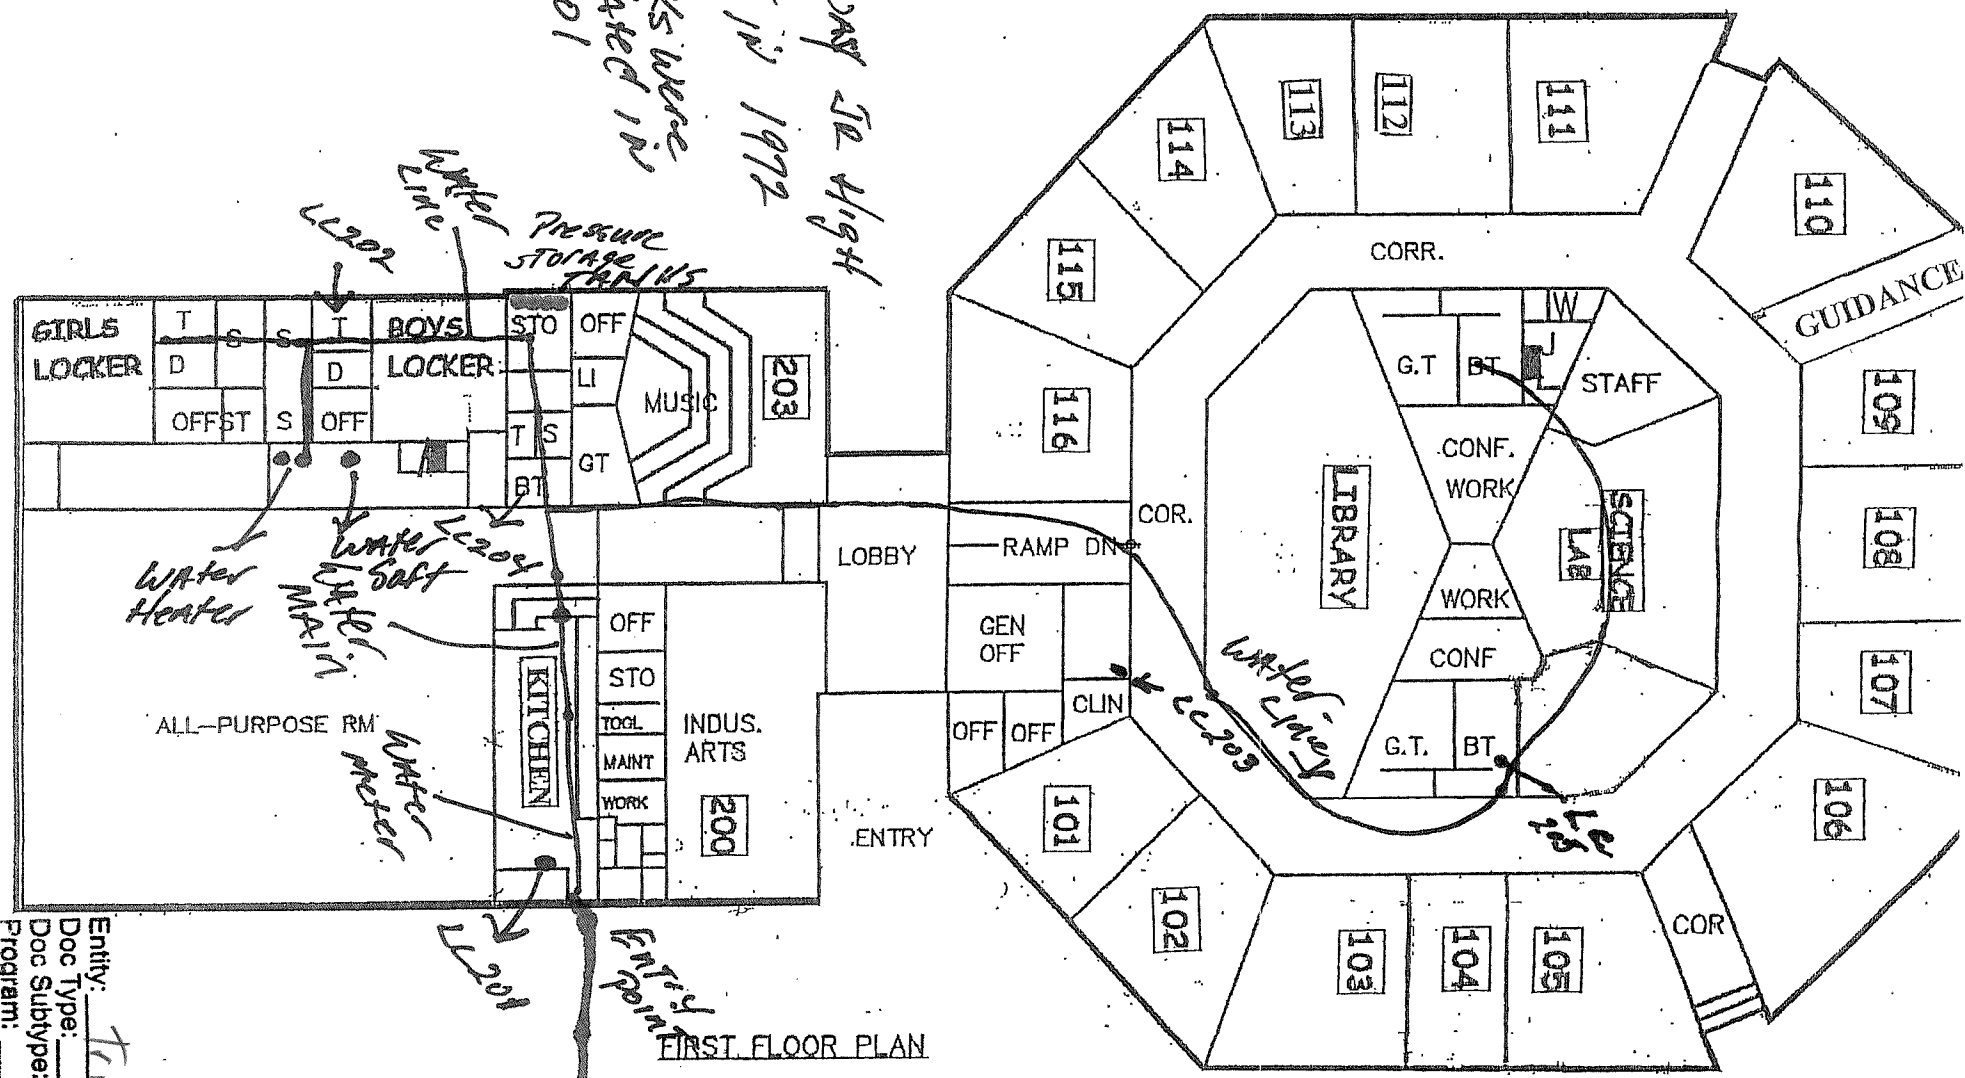

FIRST FLOOR PLAN

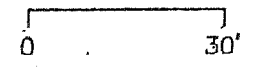

Entity: Trinidad Jr High  
 Doc Type: Report  
 Doc Subtype: DW  
 Program: DW  
 County: DH  
 Secondary ID: 8549412

Water Meter