

Harsco Minerals International
101 Tidewater Road NE
Warren, OH 44483

Phone: 330.372.1781
Fax: 330.372.1314
www.harsco-m.com



March 7, 2017

Re: Lead Service Line and Fixture Mapping Project

To Whom It May Concern:

Harsco Minerals is a small manufacturing site consisting of a series of production and small office buildings. It employs a total of 12 people. I do not have access to sophisticated mapping software, so I apologize in advance for the crudeness of the enclosed maps. I hope it will suffice in meeting the minimum requirements. Also, there is minimal information available on the history of the water system.

There is one water well on-site to provide for four bathrooms located in various buildings. Water is used for restroom purposes only and no kitchen or other fixtures are located at the facility. There is no access to water in any of the production buildings. Potable water is brought in for drinking purposes. All buildings are one level.

The water well is located near the center of the production plants. A small pump and softener is in an enclosed structure approximately 40 feet away. The main service line travels to the oldest/original building. The building is believed to be from the 1920's. The exact date of water tie-in to the building is unknown, but it is assumed to be before 1986.

Two modular buildings, 24'x60' office trailers, were installed on the property in 1999. The trailers were manufactured in 1996. Each unit has one bathroom with toilet and sink.

A third modular building, 12'x70' trailer was installed in 2011. The trailer was manufactured in 2010. This unit has a bathroom stall, urinal, and sink.

It is assumed that the lead content for the interior plumbing and fixtures correspond to the above manufactured dates. Lead content therefore is probable. There are no separate hot water service lines to any of the sinks. Small electric point-of-use water heaters are under each fixture.

Please do not hesitate to contact me if any further information is required.


Regards,

A handwritten signature in black ink that reads "Brian Diyorio".

Brian Diyorio
Site Manager

Google Maps

HARSCO MINERALS
101 TIDEWATER RD NE
WARREN, OH 44483
330-372-1781

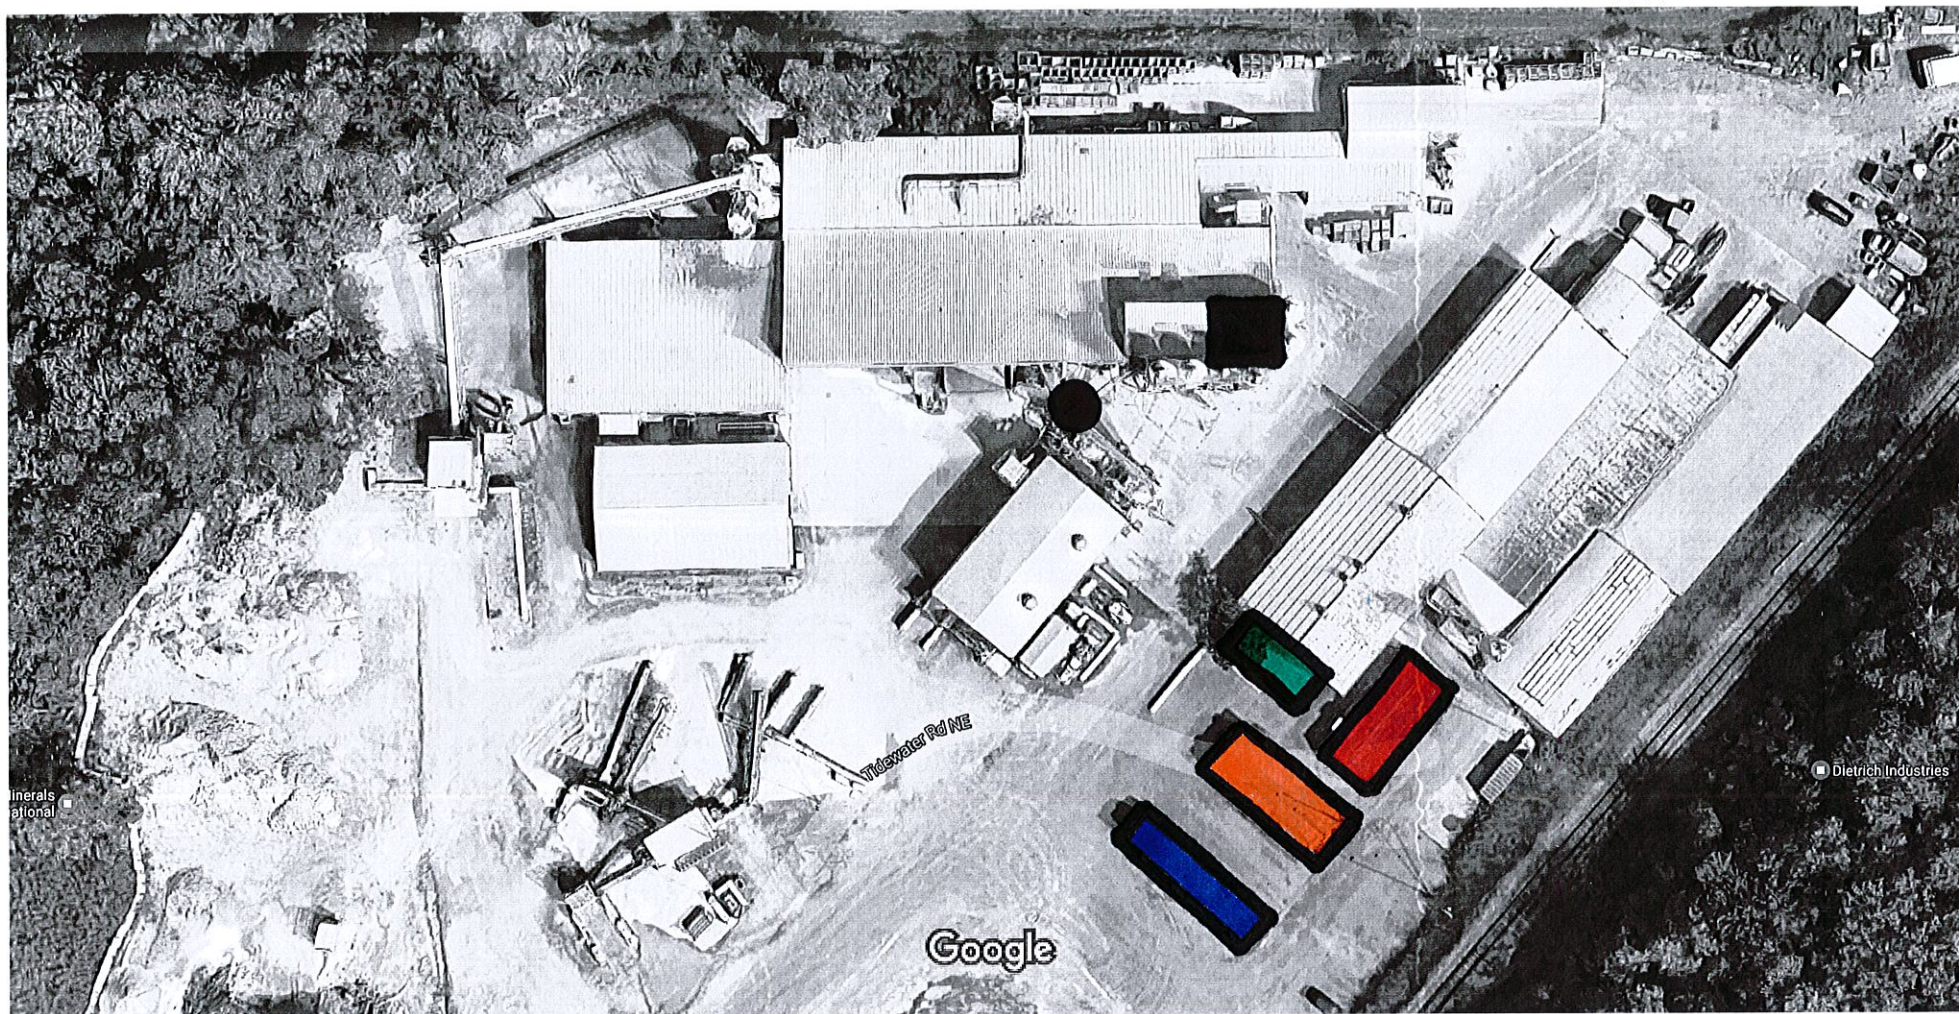


Imagery ©2017 Google, Map data ©2017 Google 50 ft

● WELL
■ DISTRIBUTION ROOM

■ SHIP/REC - LC201
■ OFFICE - LC202

■ LAB TESTING - LC203
■ EMPLOYEE BREAK ROOM - LC204

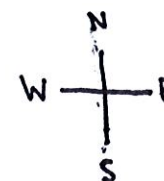


HARSCO METALS

101 TIDEWATER RD NE

WARREN, OH 44483

330-372-1781

HARSCO
METALS & MINERALS

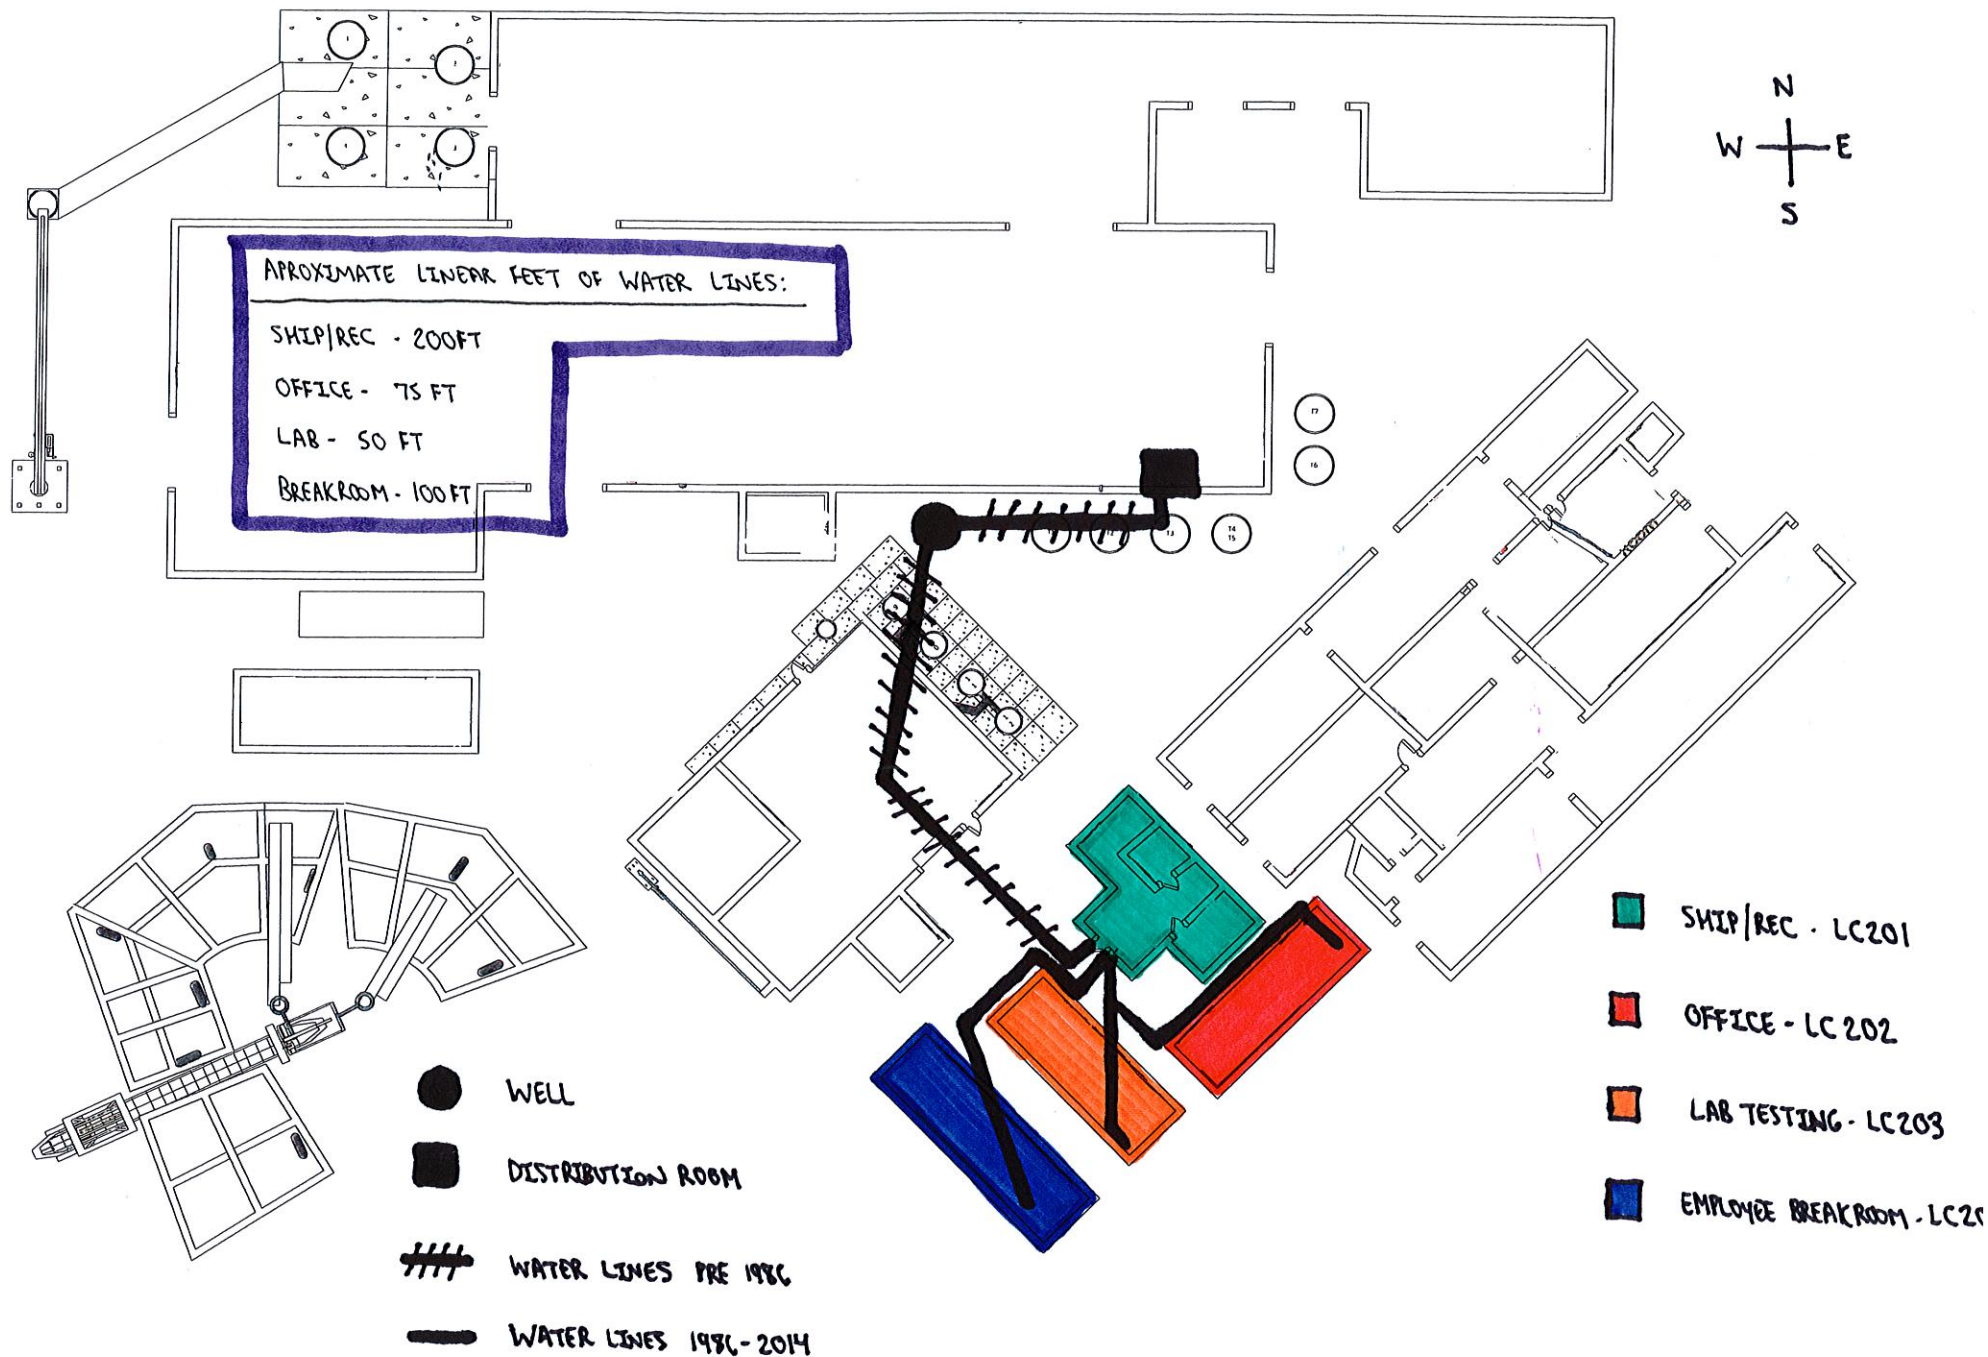

MARSCO MINERALS
 101 TIDEWATER RD NE
 WARREN, OH 44483
 330-372-1781

