


RECEIVED
MAR 07 2017


BY:

Well

Copperhead Rd

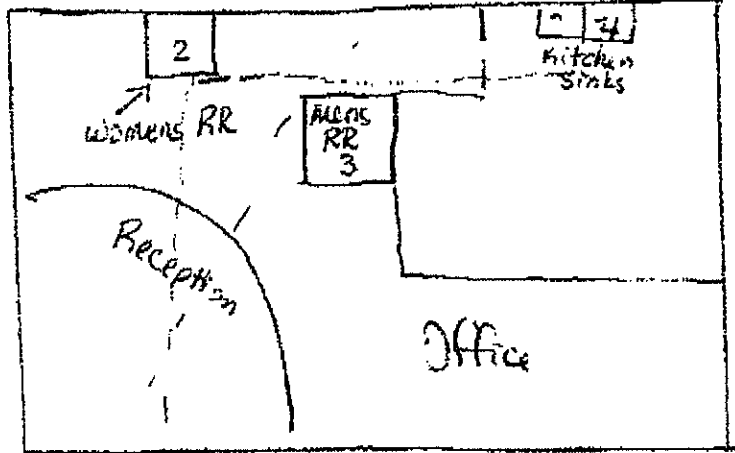

- SMP001 - Plant sink
- 002 - Women RR office
- 003 - Men RR office
- 004 - Kitchen sink
- 005 - Drinking fountain plant

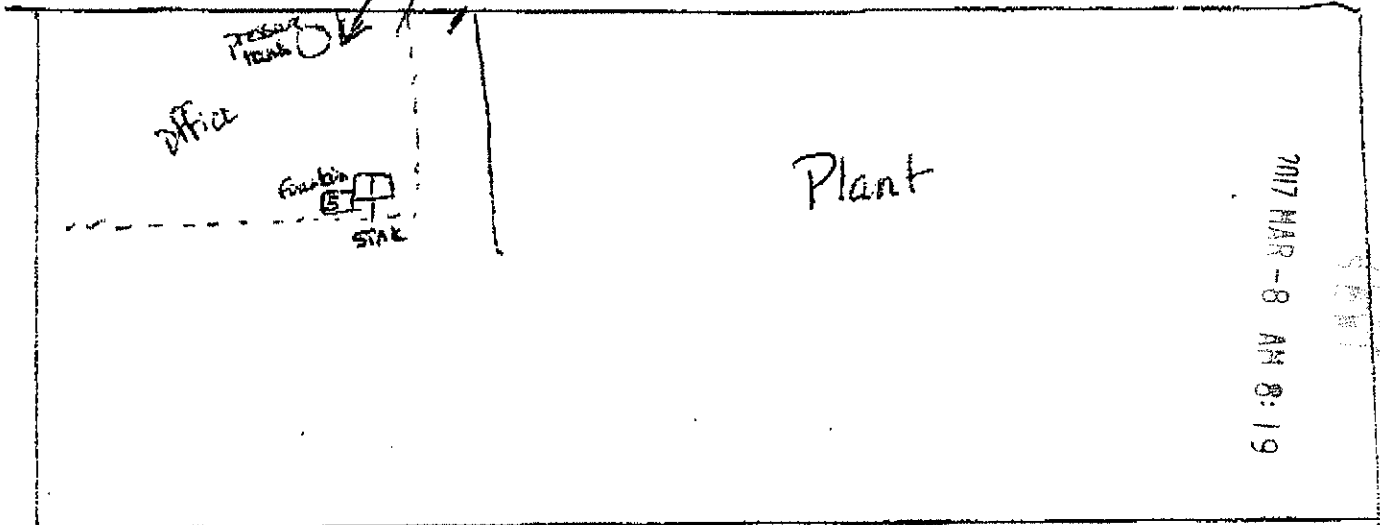

Scenic Wood Products
10143 Copperhead Rd. NW
Sugarcreek, OH 44681

* All plastic lines
Main plant built 1995
Office modular built 2000
New well installed 2016

PWS # DH 7950412