

RECEIVED
MAR 07 2017


SMP 001 - Lunchroom
002 - mens RR
003 - womens RR
004 - 2nd floor
hand sink
005 - 2nd floor
restroom

BY:

Fryburg Door
W086 St Rt. 241
Millersburg, OH 44654
PWS # 3848712

St. Rt. 241

Built 2000
Addition built 2013
Copper lines

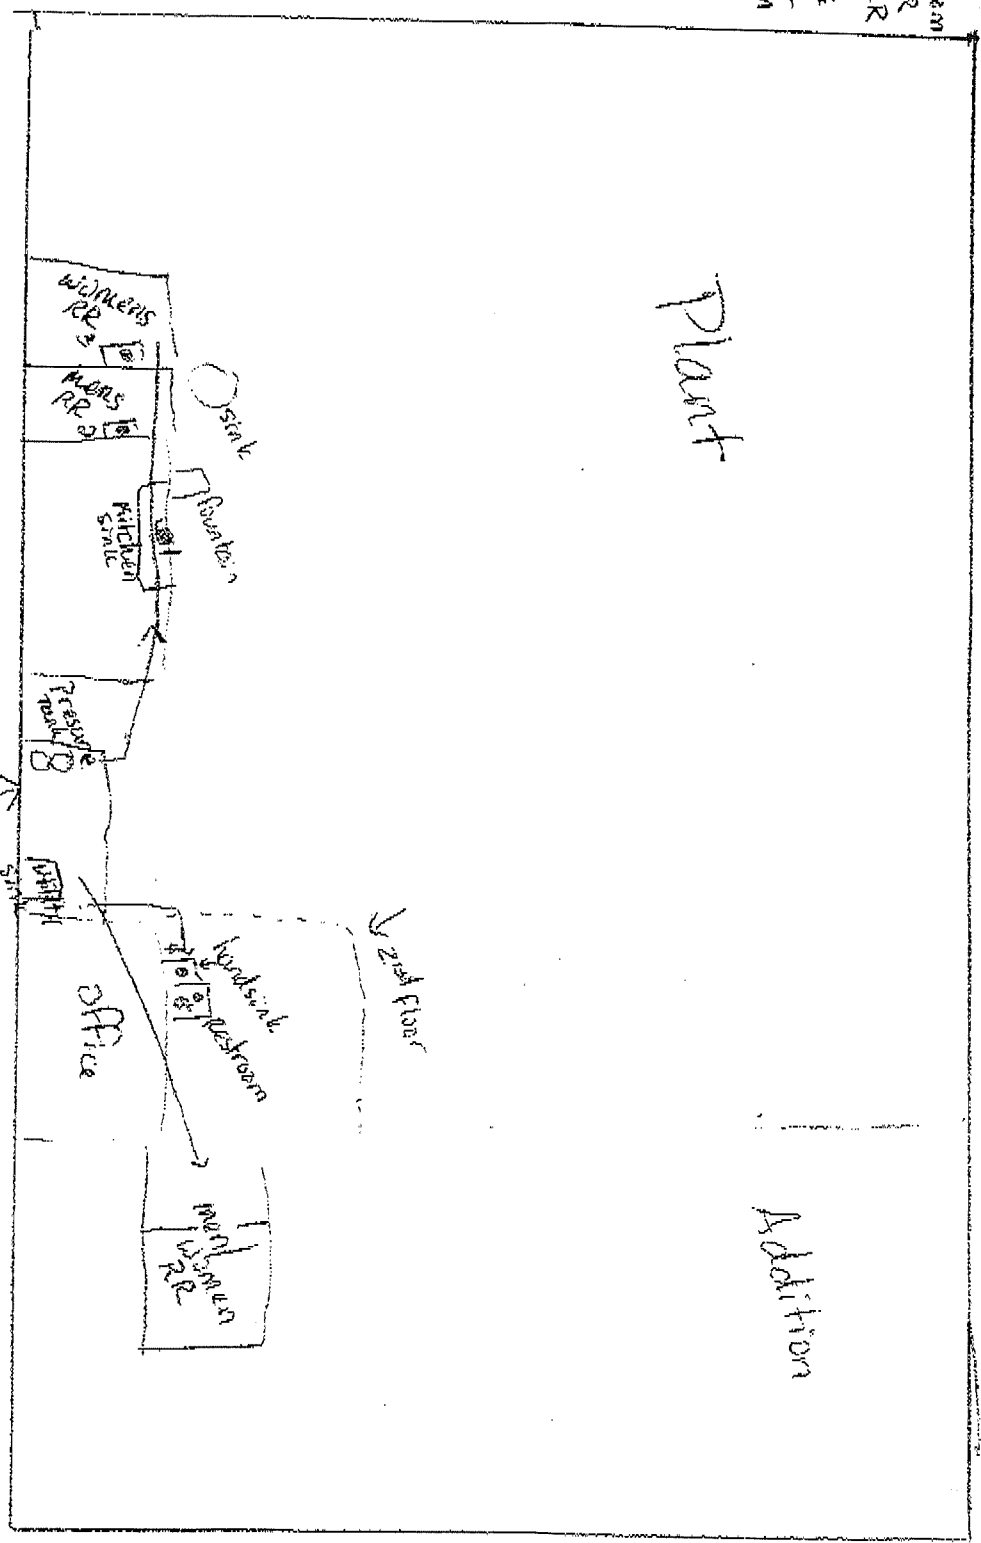

Entity: FD Hardwoods
Doc Type: REPORT
Doc Subtype: _____
Program: DDAW
County: HOLMES
Secondary ID: 043848712