

Jackson Ridge Rehab. & Care  
 7055 High Mill Ave. N.W.  
 Canal Fulton, OH 44614  
 PWS# OH 7602112

Lines from wells to pressure tanks in basement under physical therapy are steel  
 Lines run up thru ceiling to each room and unit (page 1 & 2) these lines are copper  
 Each apartment unit has one bathroom and kitchenette


SMP 001 - Kitchen  
 SMP 002 - South dining/activity room  
 SMP 003 - Maint. office  
 SMP 004 - Front office restroom  
 SMP 005 - Room 111 sink

**RECEIVED**  
 MAR 07 2017  
 BY: .....

Entity: Jackson Ridge Rehab  
 Doc Type: REPOL  
 Doc Subtype: DDAGW  
 Program: STARK  
 County: OH 7602112  
 Secondary ID: OH 7602112

# Jackson Ridge Rehabilitation

PWS#0A7602112

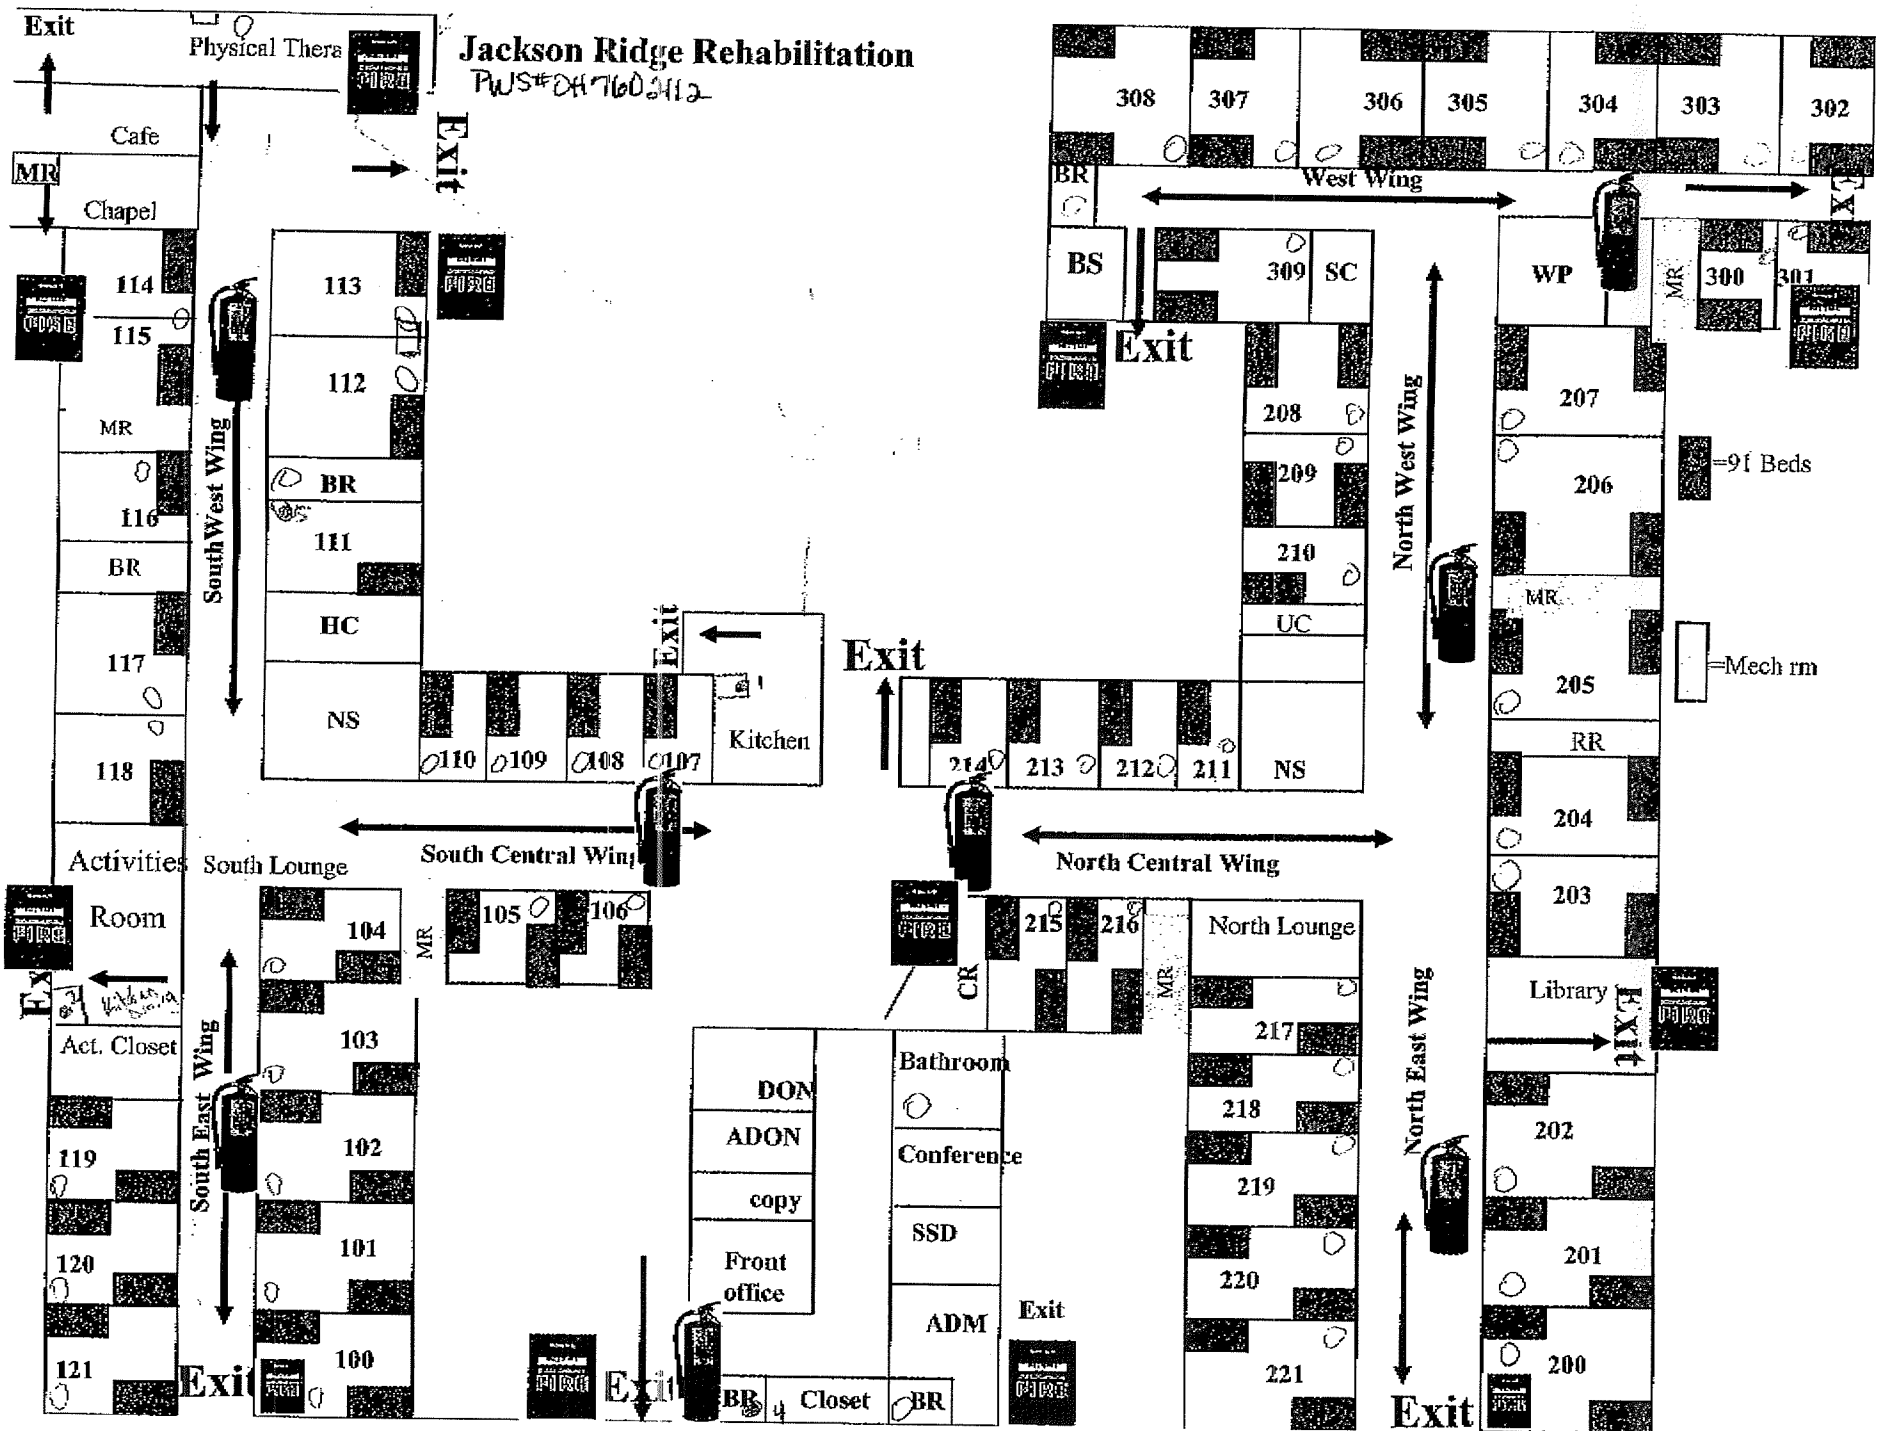

11.1.11.11.11