

Martin's Mennonite Church

PWS ID 8541812

14027 Church Rd. Orrville, OH 44667

Phone 330-683-1226

Lead Mapping

The Church's water system plumbing has no known lead pipes installed. No records have been found that show the use of lead piping. Looking at the building's water lines has not found any lead piping.

Long time building maintenance supervisor Curtis Plank has never seen any lead pipes, nor has Church trustee Kim Kornhause.

The pipe from the well connecting to the system is plastic. There is plastic pipe going from the Church building to the Fellowship Hall (Bldg. A). The buildings are all plumbed with copper.

The Church building was built about 1981 and used copper with lead solder. A Fellowship Hall Building (Bldg. A) was built in 1992 and may also have lead solder. There are no known records that show the exact age or type of material used in the solder, the faucets or fountains.

We must assume that most of the plumbing fixtures do not meet the current 0.25% lead standard.

I certify that this information is accurate to the best of my knowledge.

Mick Stebelton
Mick Stebelton
Operator of Record

P.O. Box 268
Fredericksburg, OH 44627
Cell 330-464-9876
e mail mickstebelton@hotmail.com

RECEIVED

MAR 08 2011


OHIO EPA NEDO

Entity: Martin's Mennonite Ch
Doc Type: Report
Doc Subtype:
Program: DPA&W
County: Wayne
Secondary ID: OH8541812

MARTINS MENNONITE CHURCH
14027 CHURCH Rd.
Drtville, OHIO 44667 PWS ID 8541812

NORTH ↑

1st Floor

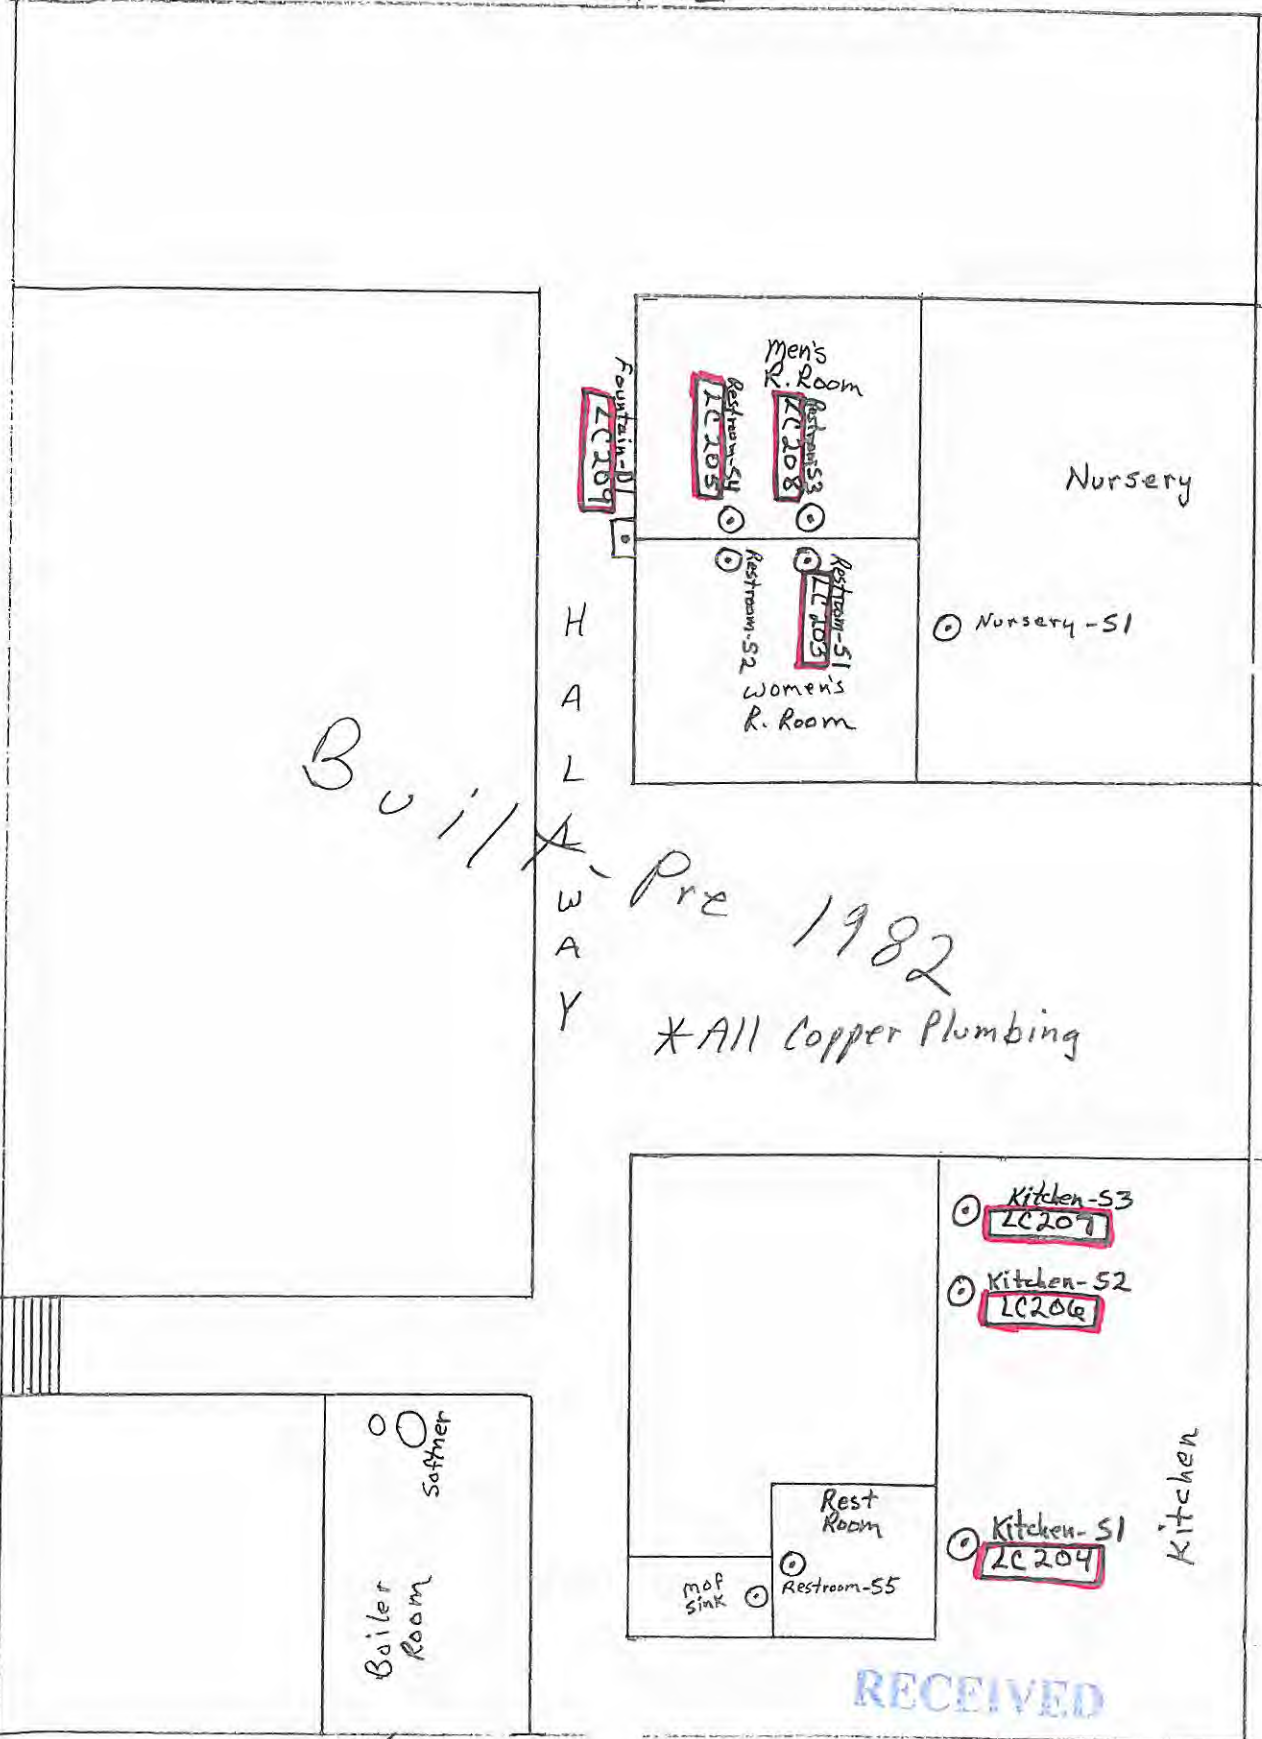

Build Pre 1982

*All Copper Plumbing

Plastic Pipe to Bldg. A Fellowship Hall

RECEIVED


FAR 10/18/2011

OHIO EPA NEDO

MARTINS MENNONITE CHURCH
14027 Church Rd.
Orville, OHIO 44667 PWS ID 8541812

NORTH ↑

Basement

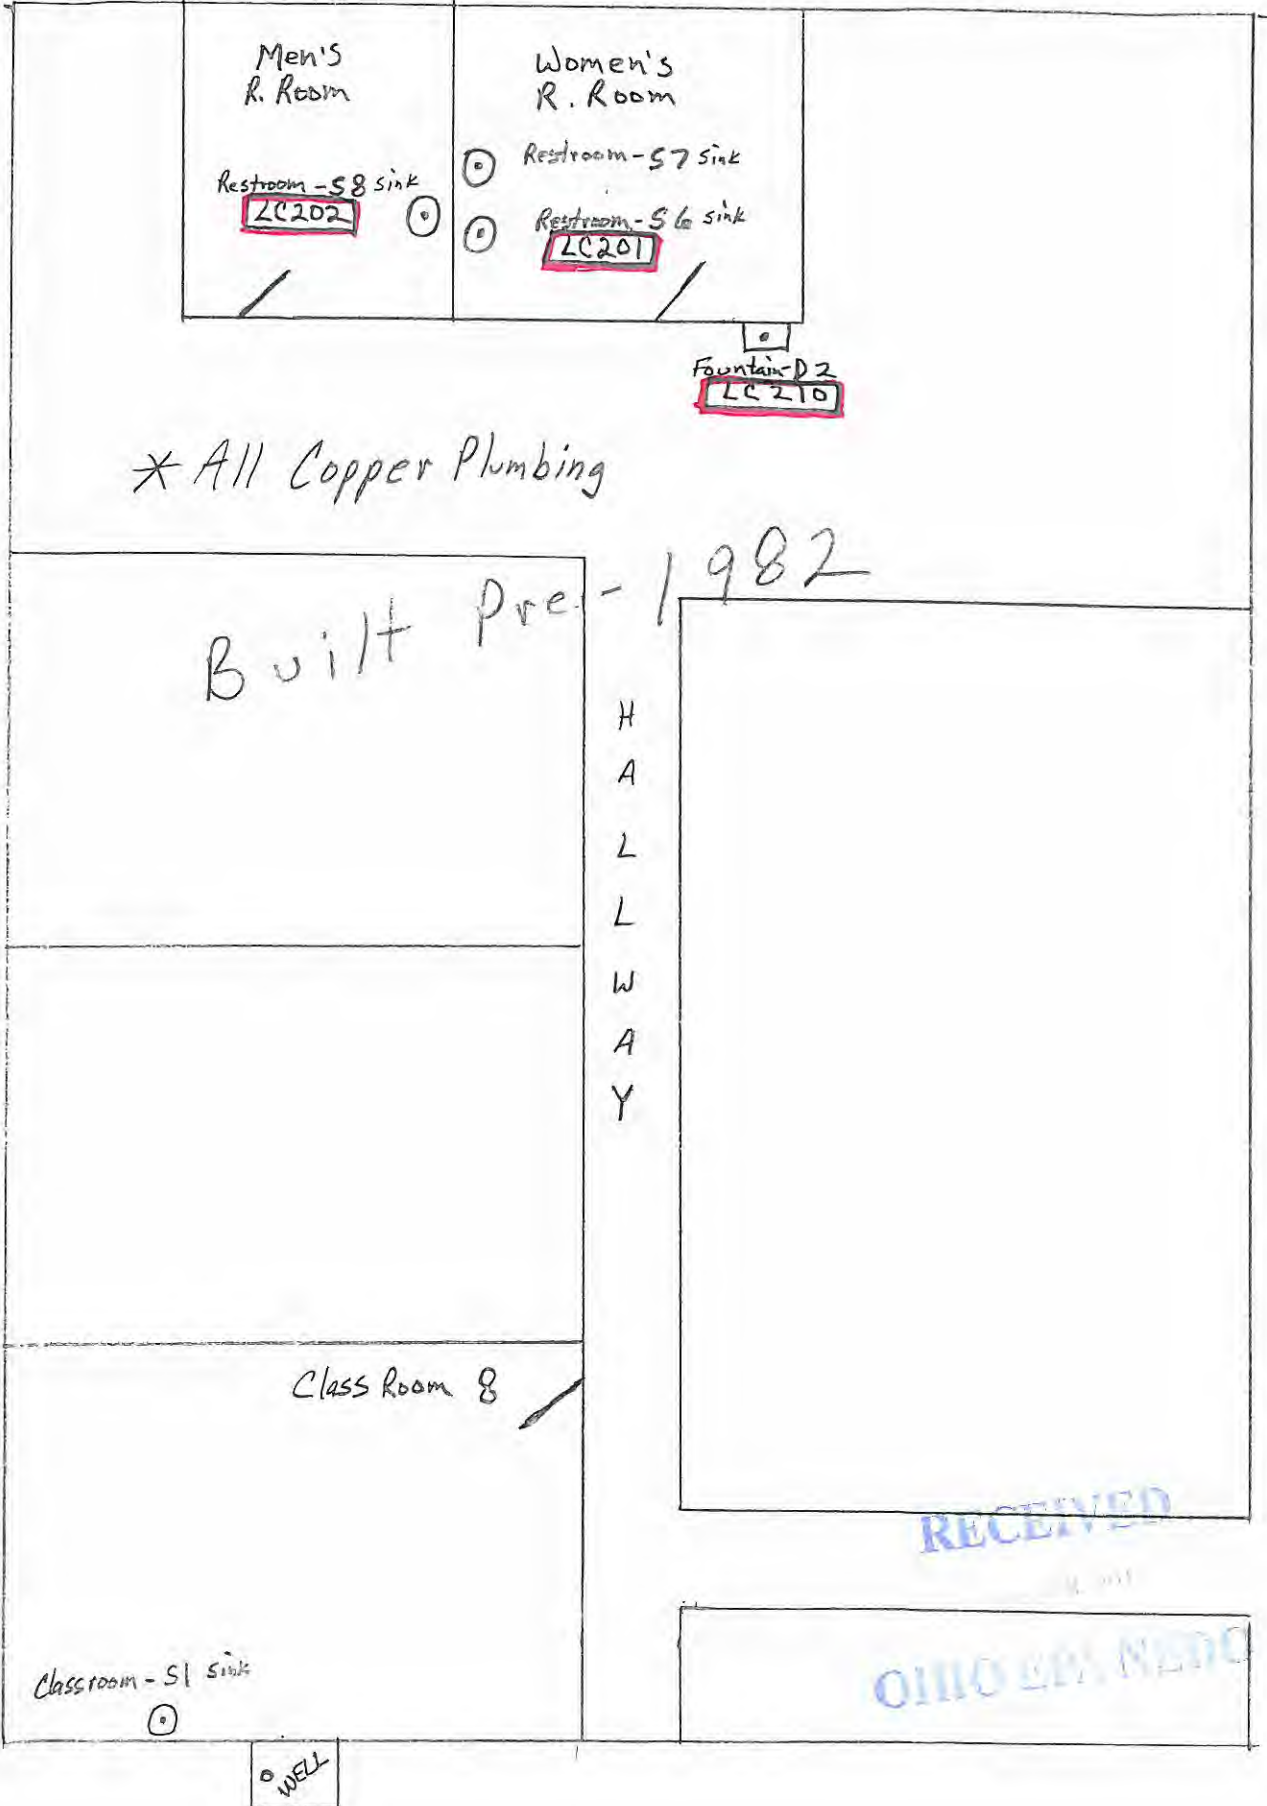

* All Copper Plumbing

Built Pre-1982

H
A
L
L
W
A
Y

Class Room 8

Classroom - S1 sink

WELL

RECEIVED

OHIO EM NEDC

MARTINS MENNONITE CHURCH
14027 CHURCH Rd.
Orrville, OHIO 44667
PWS ID 8541812

NORTH



FELLOWSHIP HALL
BUILDING

Bldg. A

Built 1992
* All Copper Plumbing

Kitchen - S4



Restroom - S9



Fountain - D3

OUTSIDE COVERED
PAVILLION

Plastic Pipe From Church

RECEIVED

OHIO EPA NEDO