



*water treatment, inc.*

South Main Centre is a multi-tenant retail space built in 1988 that is occupied by a wide variety of businesses. All plumbing is copper and is original to construction date with the exception of minor changes made by the tenant.




# SOUTH MAIN CENTRE LTD.

DWS # 7784412

WELL

CU WELL LINE

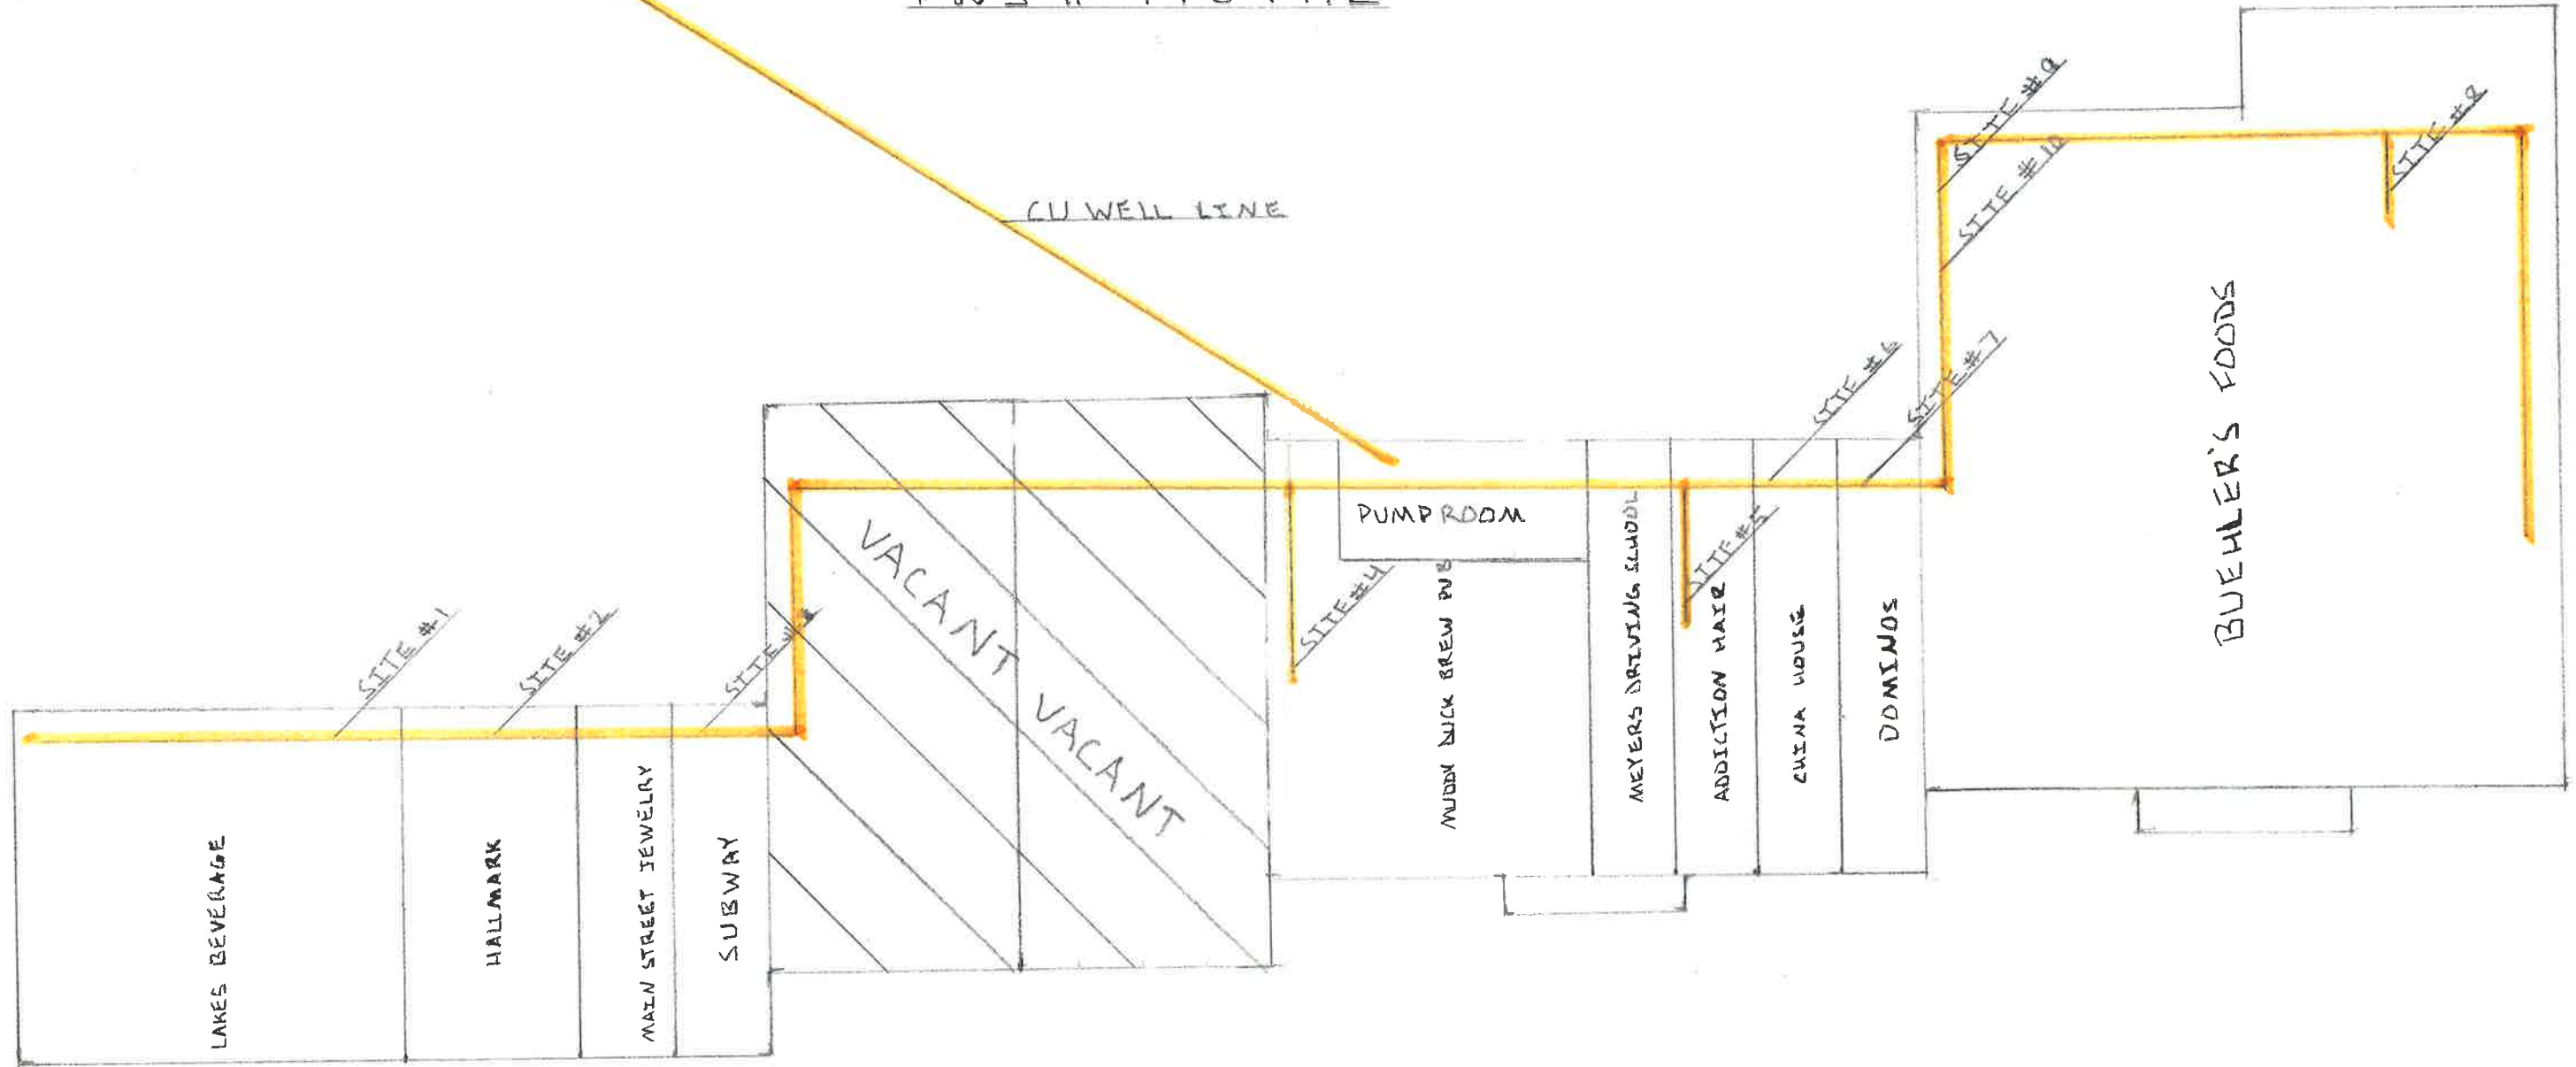

— CU PIPE INSTALLED IN '88