




water treatment, inc.

Ken Stewarts Lodge was originally built in 1956. In 2001 the building was purchased by the current owner who remodeled the building and replaced all plumbing with CPVC. In 2006 the building was added on to the south where Tre Belle now operates. All plumbing within the Tre Belle is also CPVC.

KEN STEWART'S LODGE PWS # 7753412

Created by Unlicensed Version

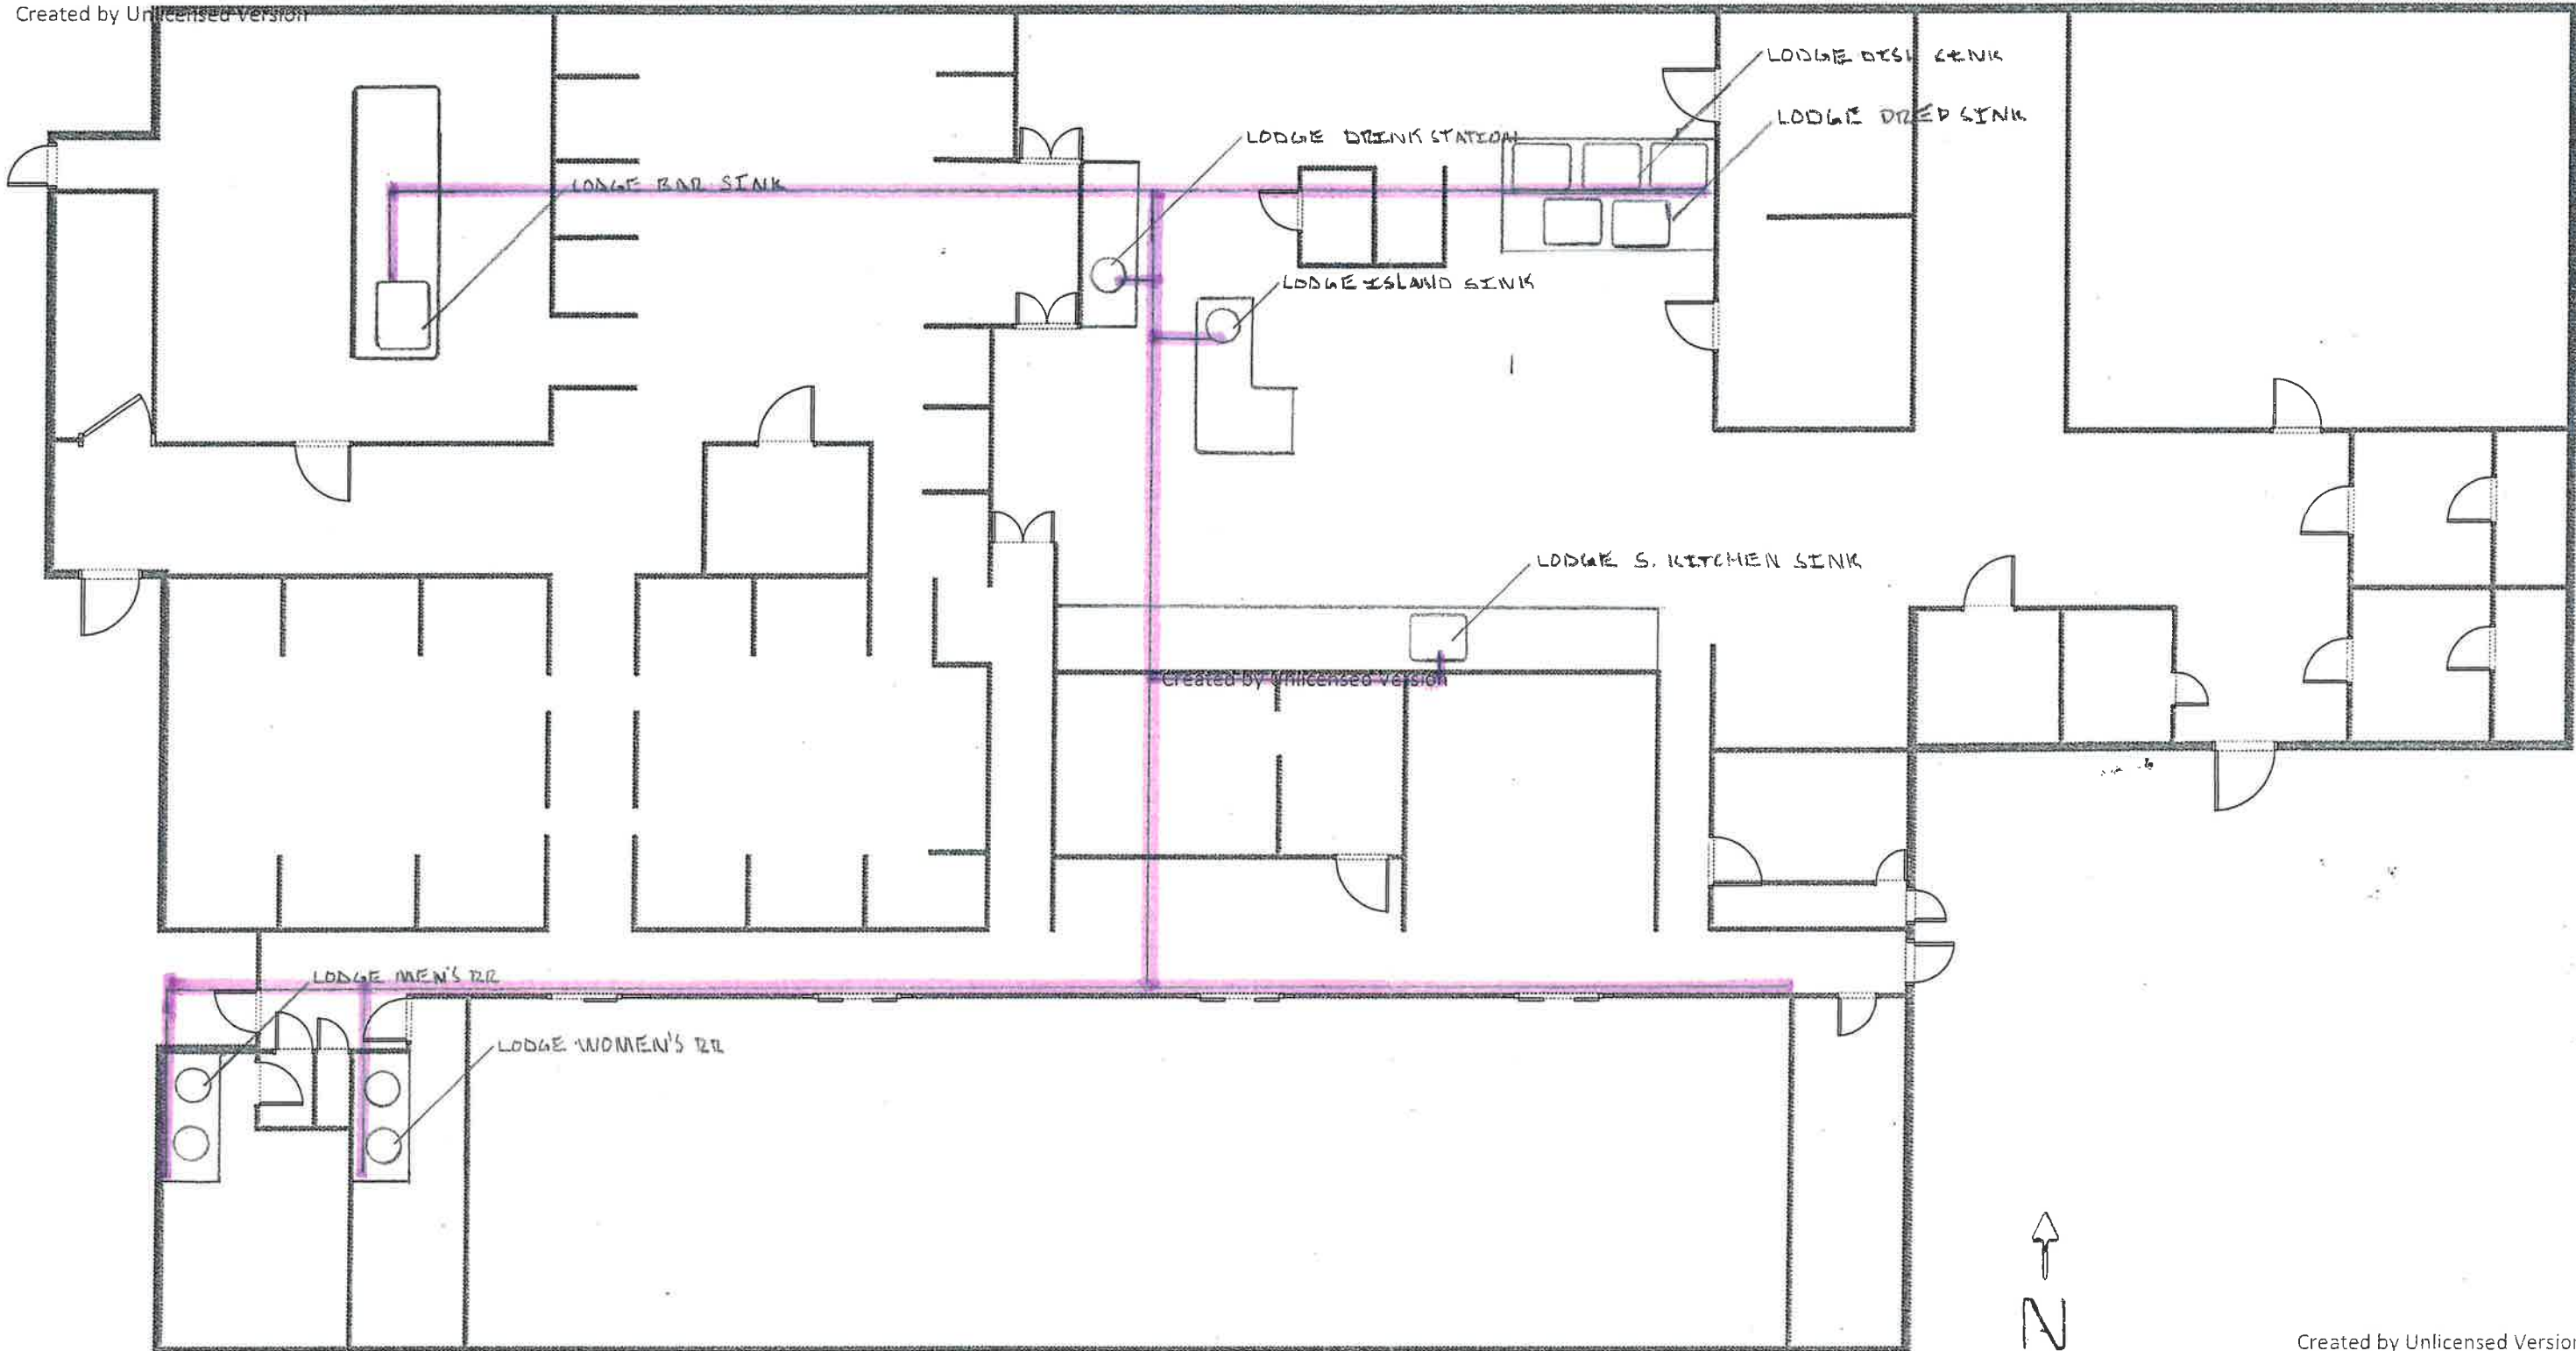

Created by Unlicensed Version

Created by Unlicensed Version



————— DENOTES PVC PIPE CIRCA 2001

KEN STEWART'S LODGE TRE BELLE

— DENOTES CPVC PIPE CIRIA 2006

