




*water treatment, inc.*

Granger Lake Condo #4 consists of 54 condos that were constructed in 2 phases. The first being in 1986 and the second being South Western portion installed in 2002. All distribution piping is plastic. However the older units have copper interior plumbing while the newer units have CPVC interior plumbing.





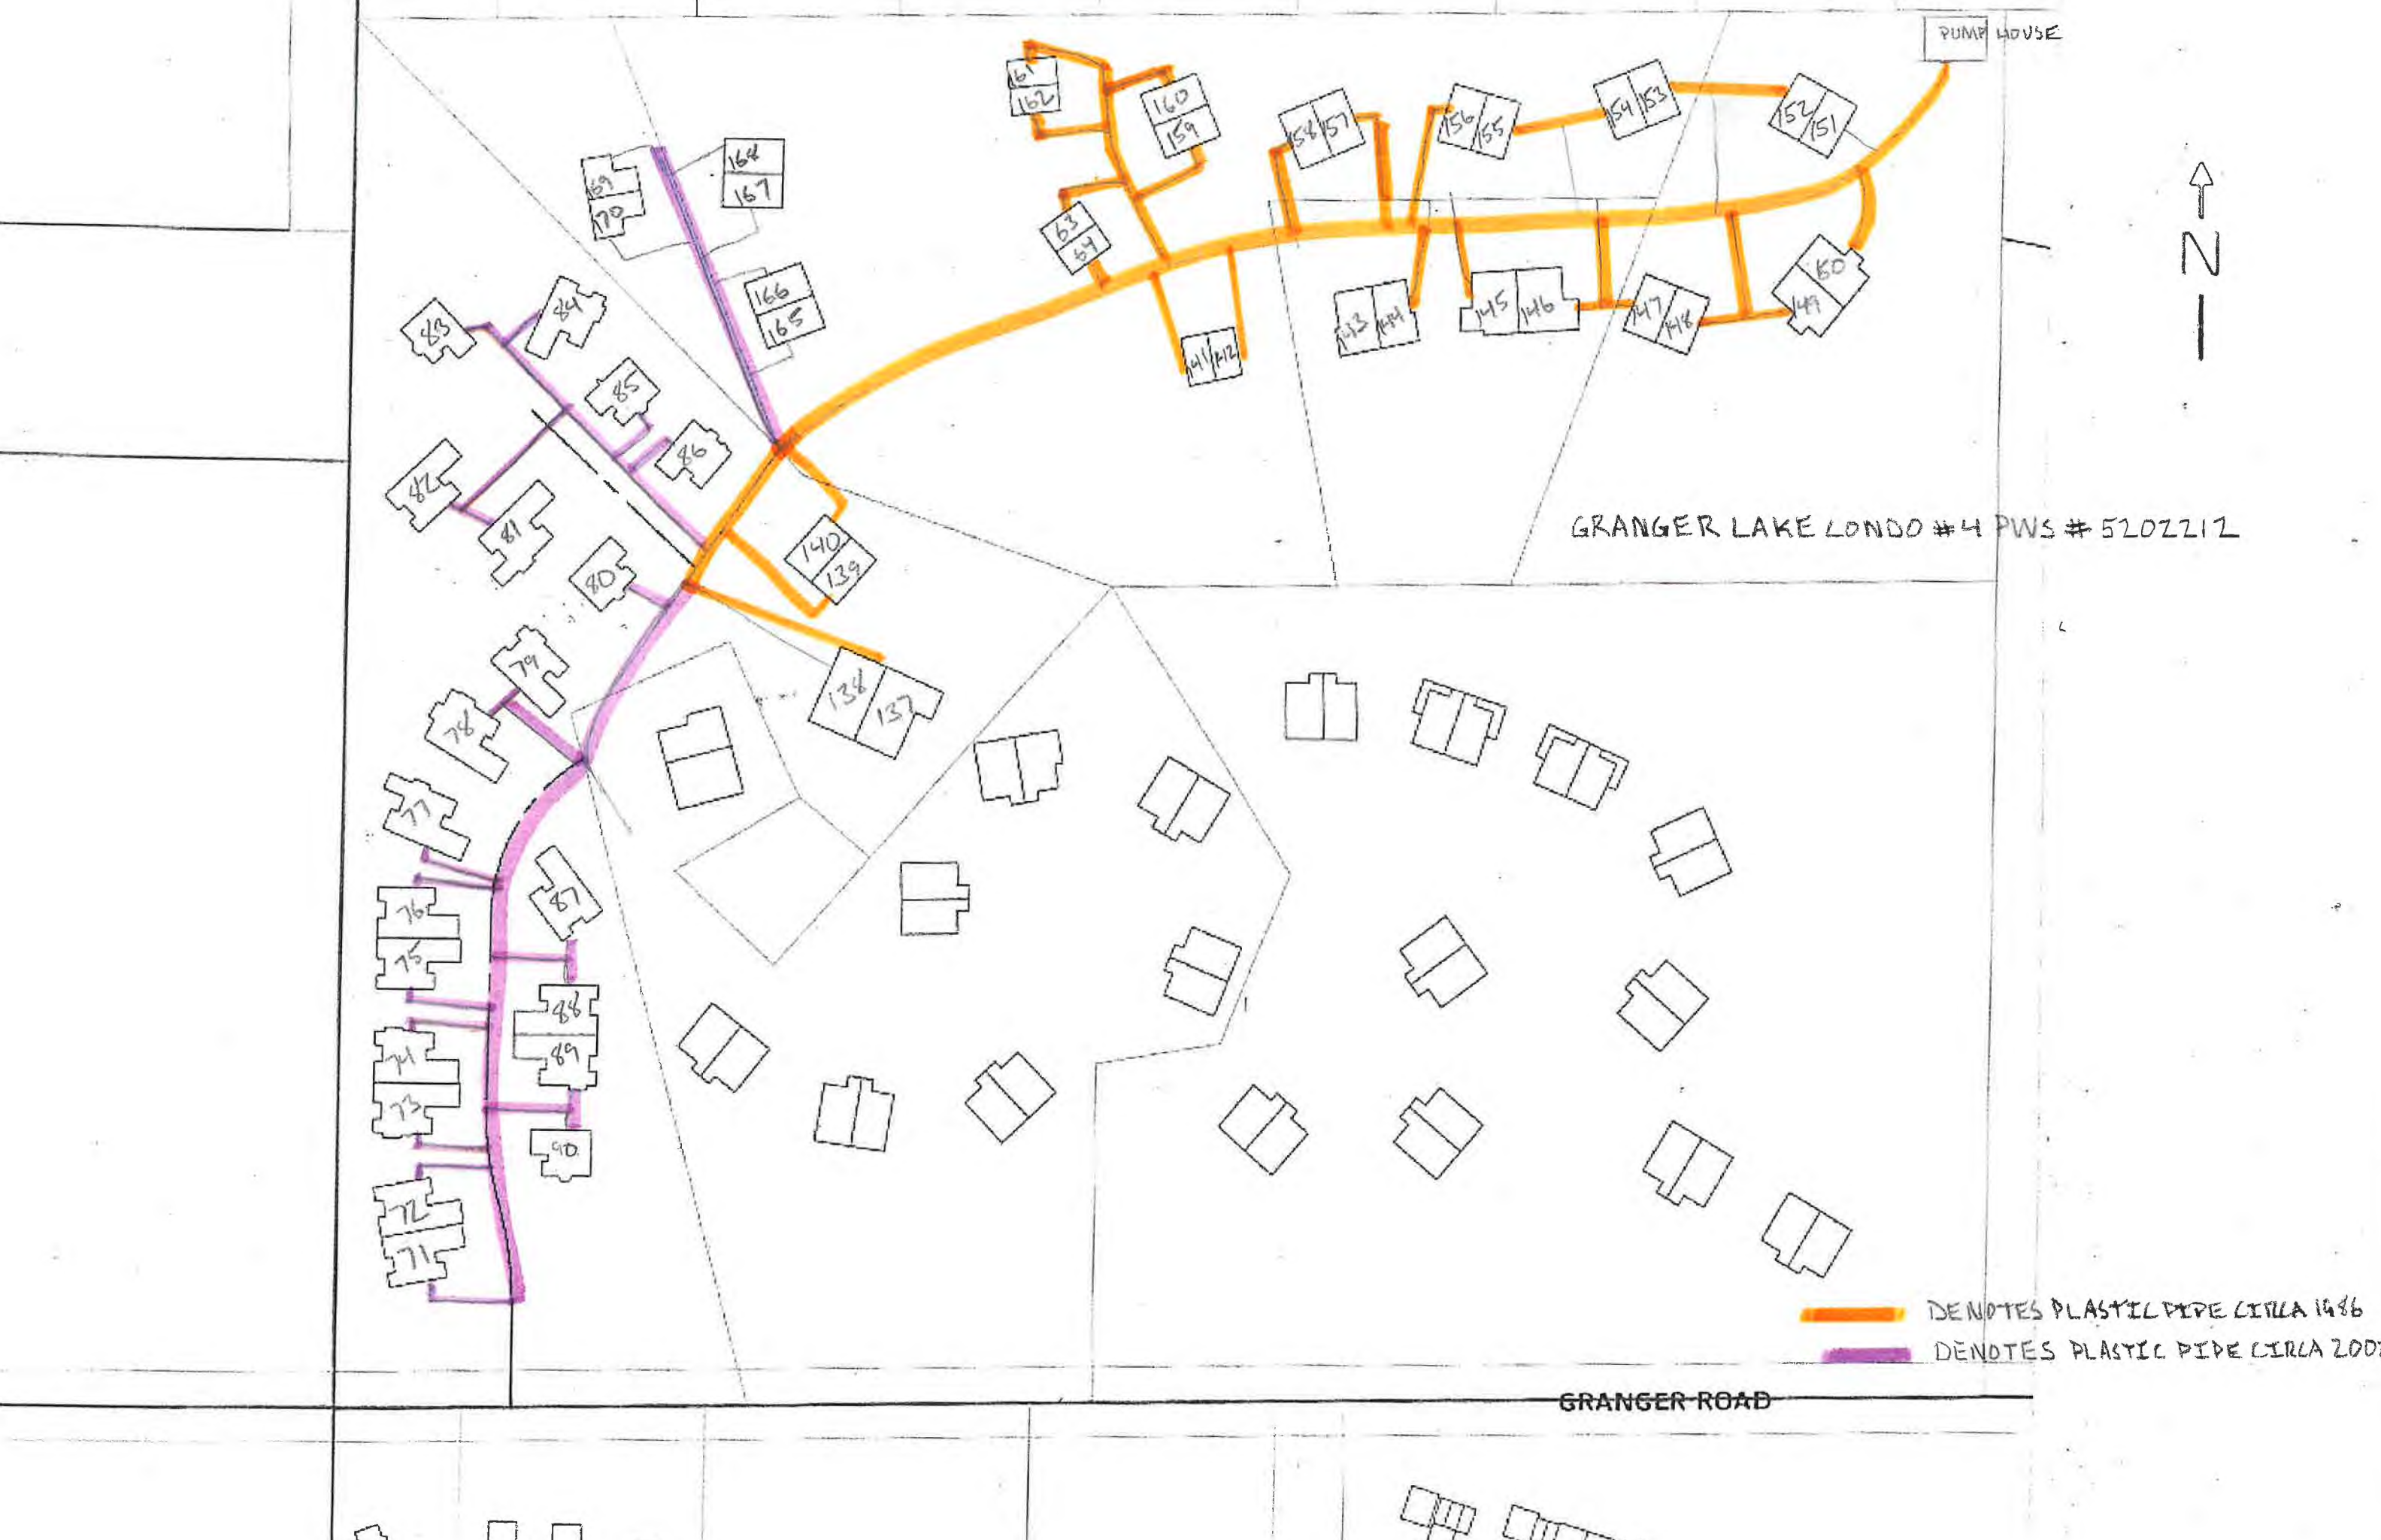

PUMP HOUSE



GRANGER LAKE LONDO #4 PWS # 5202212

— DENOTES PLASTIC PIPE CIRCA 1986  
— DENOTES PLASTIC PIPE CIRCA 2002

GRANGER ROAD

