



Granger Lake Condo #2&3 consists of 35 condos constructed in 1972. All distribution piping is plastic with the exception of a short piece of copper pipe supplying units 101-104 that was installed in 2014. In 2015 the main 4" water line running west of the pump house was replaced with Certalock plastic pipe due to repeated water main breaks in this section. All interior plumbing is copper.


**VERIFICATION FORM FOR COMMUNITY PUBLIC WATER SYSTEMS
CLAIMING NO LEAD SERVICE LINES**

The owner or operator of all community public water systems must identify and map areas of their distribution system that are known or are likely to contain lead service lines. Systems must submit a copy of the applicable map to the Ohio Department of Health and the Ohio Department of Job and Family Services. Systems must also submit a report to the director containing at least both of the following: (1) The applicable map with narrative, and (2) A list of sampling locations used to collect samples as required by Ohio Revised Code (ORC) Section 6109.121 and any rules adopted thereunder, including contact information for the owner and occupant of each sampling site.

Should a water system determine no lead service lines exist in their distribution system, they must provide information stating they reviewed, at the minimum, historical permit records and local ordinances, distribution maintenance records and information pertaining to installation dates or materials for all services lines. This information must be verified below.

I HEREBY CERTIFY THAT THE FOLLOWING METHOD(S) WERE USED TO DETERMINE NO LEAD SERVICE LINES EXIST IN THIS WATER SYSTEM'S DISTRIBUTION SYSTEM, AS REQUIRED BY ORC 6109.121(F):

LEAD SERVICE LINE VERIFICATION
<p>This PWS states they have no lead service lines and has reviewed the following information (select one or more of the following):</p> <ul style="list-style-type: none"><input type="checkbox"/> Historical permit records and/or local ordinances<input type="checkbox"/> Distribution maintenance records (i.e. meter replacement, waterline break repairs)<input type="checkbox"/> Information pertaining to installation dates for all service lines (i.e. after 1986 when lead services lines were banned)<input checked="" type="checkbox"/> Service line material of all service lines is known (i.e. all service lines are known to be PVC)

 03-06-2017
Signature of Responsible Person Date


Scott Robinson
Printed Name and Title of Responsible Person

PWS NAME: Granger Condo 2+3
PWS ID: OH 5202312
COUNTY: Medina

<p>For Ohio EPA use only:</p> <p>Date Verification Rec'd: _____</p>
--

GRANGER LAKE CONDO 2 & 3 WATER SYSTEM

PWS ID # 5202312

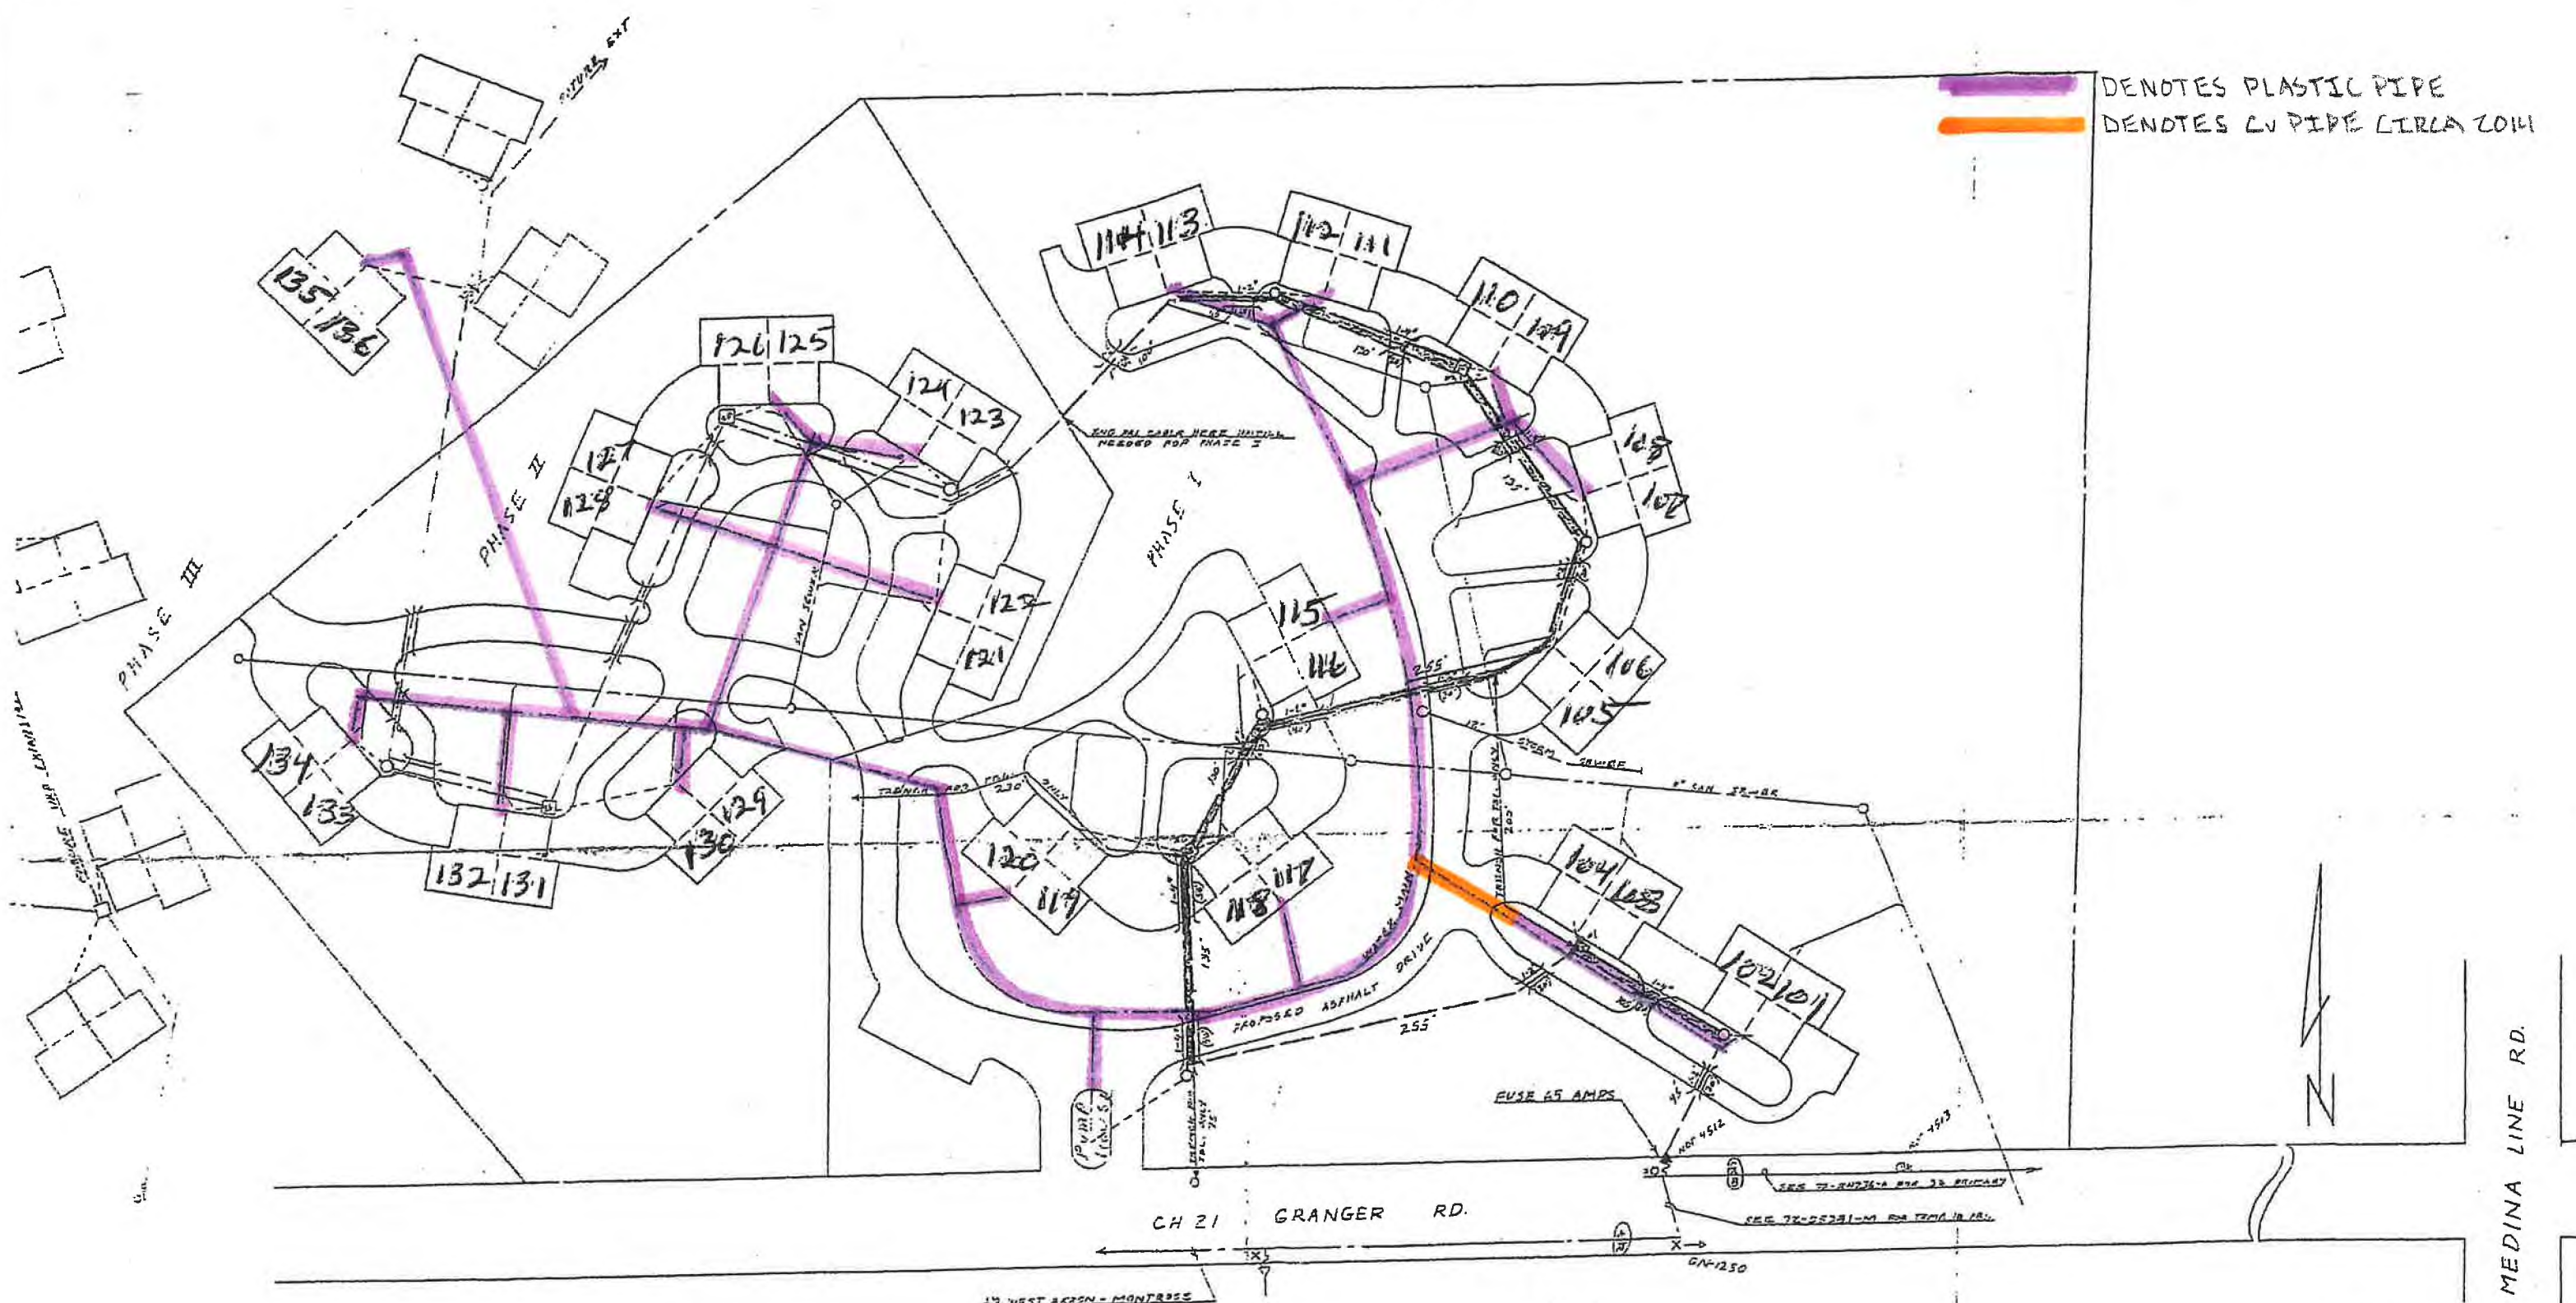

DENOTES PLASTIC PIPE
 DENOTES CU PIPE (CIRLA 2014)

LEGEND

- 1/2" x 2 1/2" 15KV URD PRIMARY CABLE
- 2 1/2" x 1 1/4" AL TRIPLEX 600 VOLT SECONDARY CABLE
- MINI TYPE PADMOUNT TRANSFORMER & CONCRETE PAD
- UNDG SERVICE HANDHOLE
- - - UNDG SERVICE (CUSTOMER OWNED)
- TYPE II PLASTIC CONDUIT 2" x 4" AS SPECIFIED
- JOINT TRENCH FOR POWER & TEL

NOTES

1. SEE EST 72-05381-M FOR ASSOCIATED OVERHEAD WORK
2. CHARGE ALL TIME TO INSTALL TRANSFORMERS TO FUNCTION # 12
3. TRENCHING & BACKFILLING TO BE PROVIDED BY OHIO Edison