


## Canton South Vocational Annex

The Vocational Annex was built in 1970. The Annex has all copper piping throughout the building with the exception of the Animal Science area which has some pex piping installed to some of the sinks in the summer of 2016. All drinking fountains were also replaced in 2016. The well that supplies the building is outside the animal science area and the storage tank is located downstairs in the Northwest corner of the bus garage. We had every sink tested this past fall and any that did not pass or had an elevated level we put in a new faucet and replaced the shut-off valves.

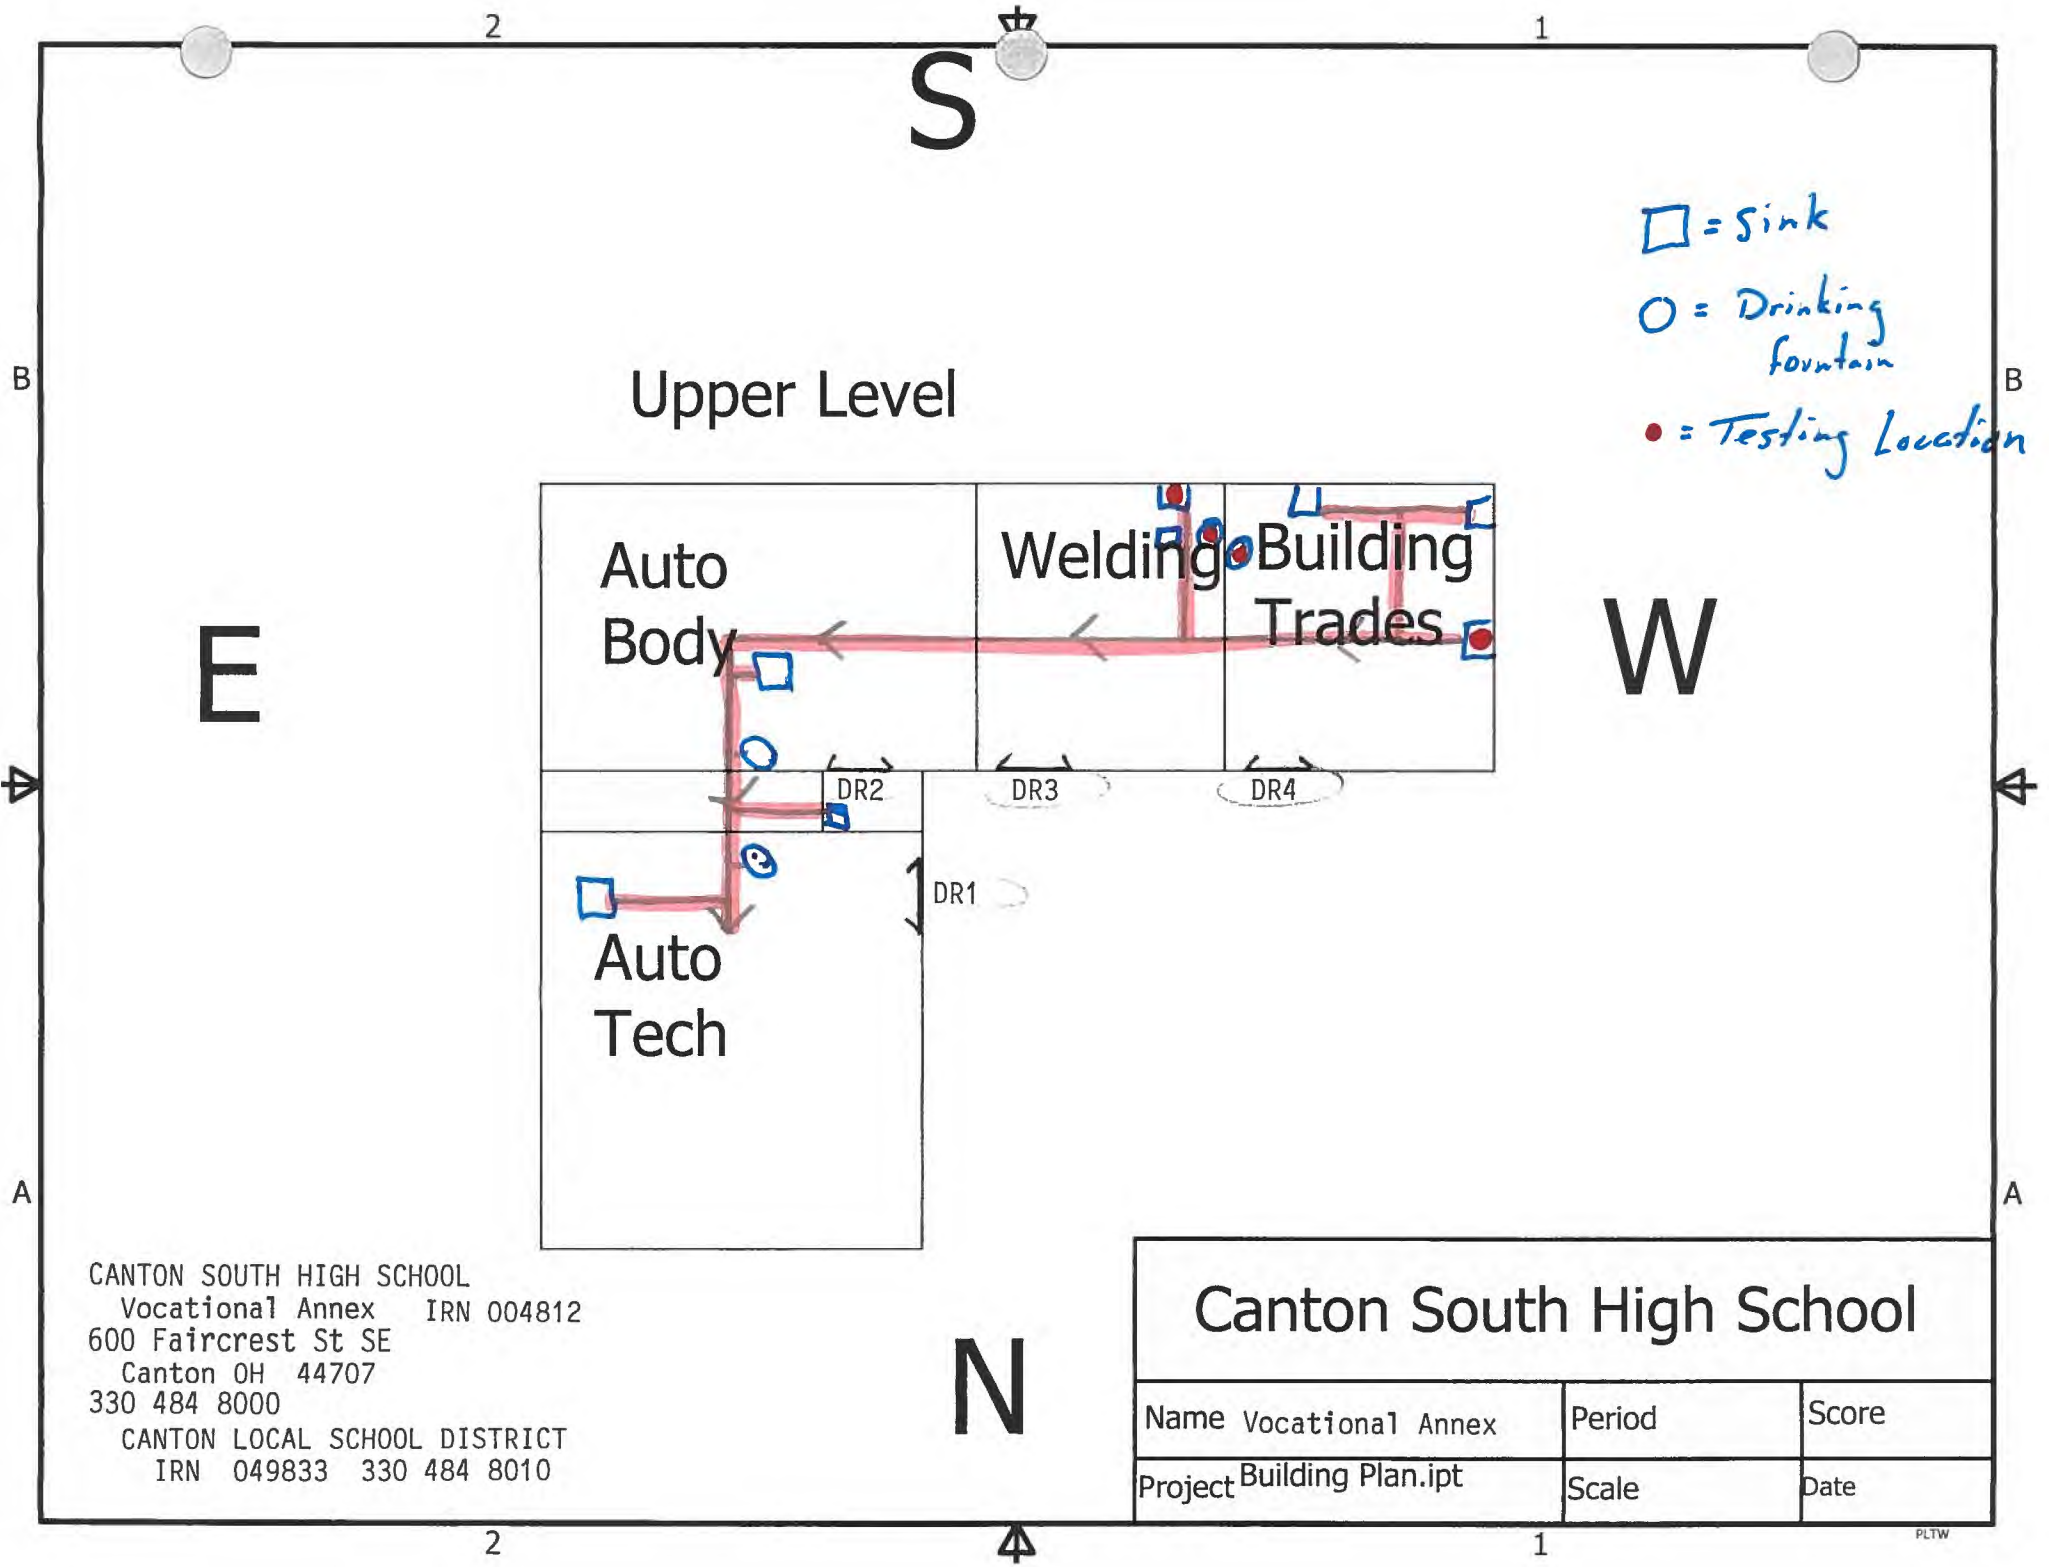

CANTON SOUTH HIGH SCHOOL  
 Vocational Annex    IRN 004812  
 600 Faircrest St SE  
 Canton OH 44707  
 330 484 8000  
 CANTON LOCAL SCHOOL DISTRICT  
 IRN 049833    330 484 8010

<b>Canton South High School</b>		
Name Vocational Annex	Period	Score
Project Building Plan.ipt	Scale	Date

2

1

S

□ = sink  
 ○ = Drinking fountain  
 ● = Testing Location

### Lower Level

B

B




E

W

N

A

A

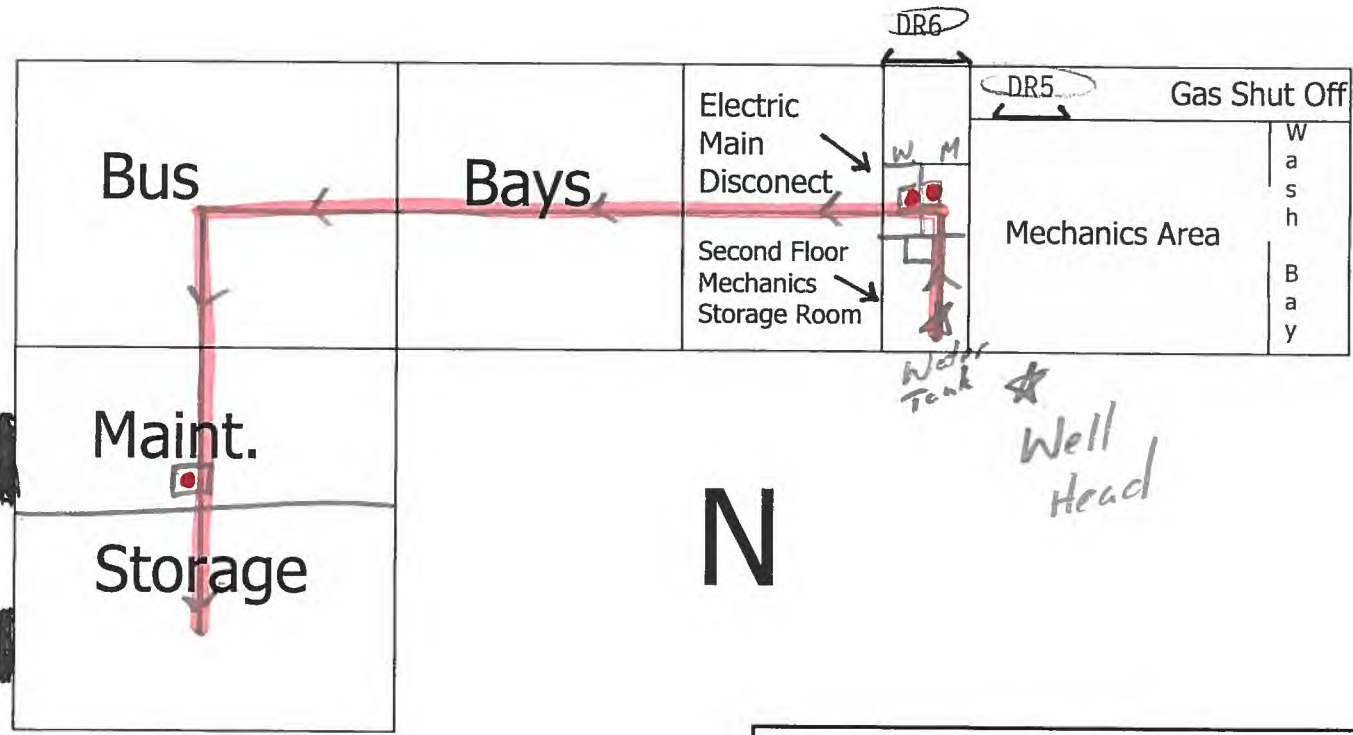

CANTON SOUTH HIGH SCHOOL  
 Vocational Annex IRN 004812  
 600 Faircrest St SE  
 Canton OH 44707  
 330 484 8010  
 CANTON LOCAL SCHOOL DISTRICT  
 IRN 049833 330 484 8010

## Canton South High School

Name	Vocational Annex	Period	Score
Project	bus g.ipt	Scale	Date

2



1

PLTW