



SECOND FLOOR

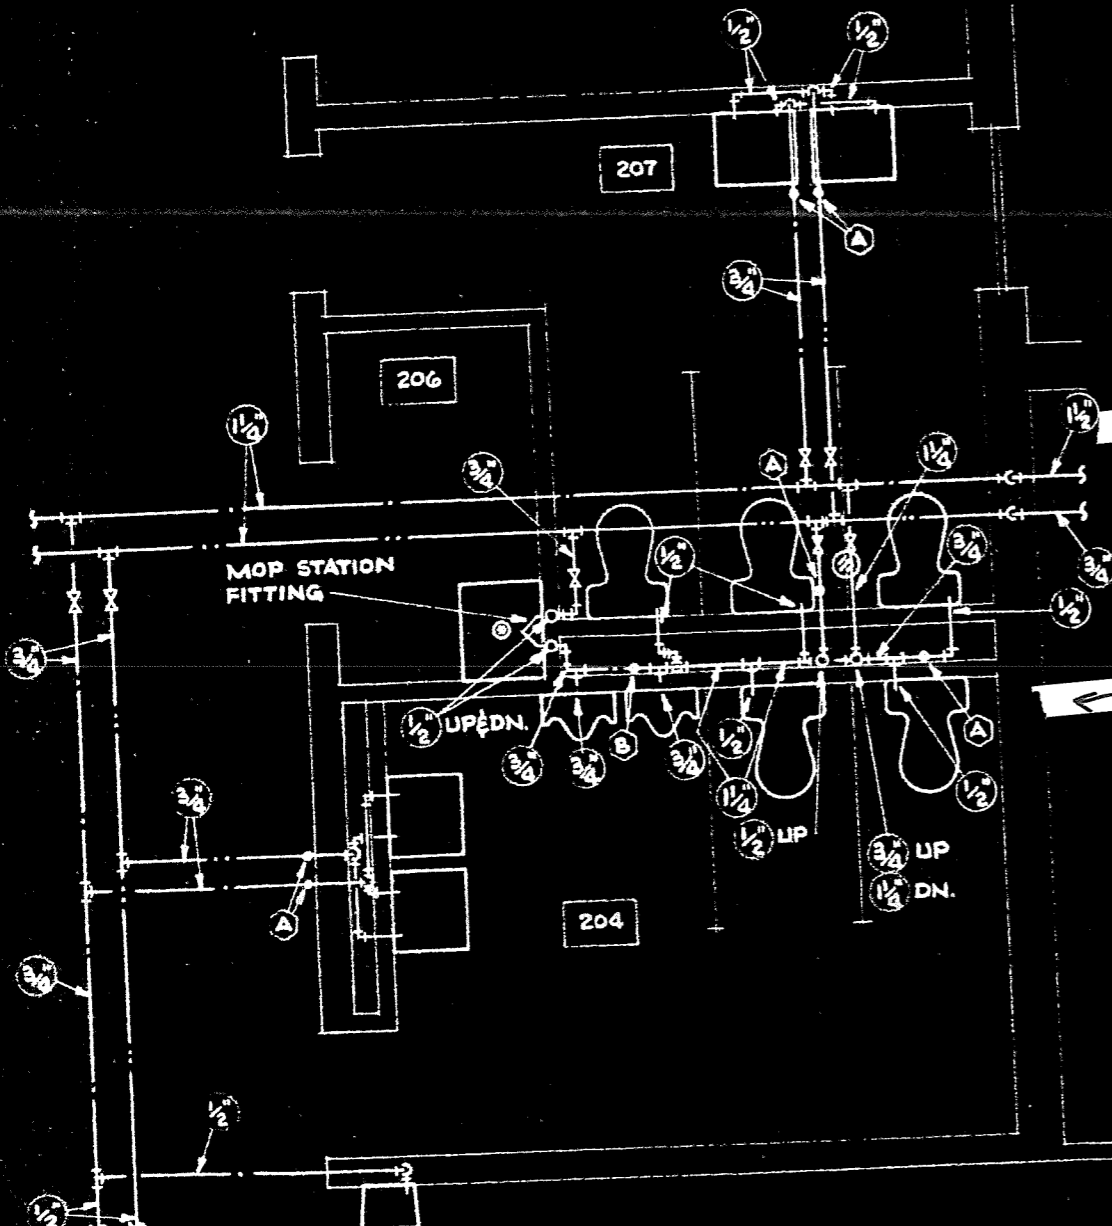

FIRST FLOOR

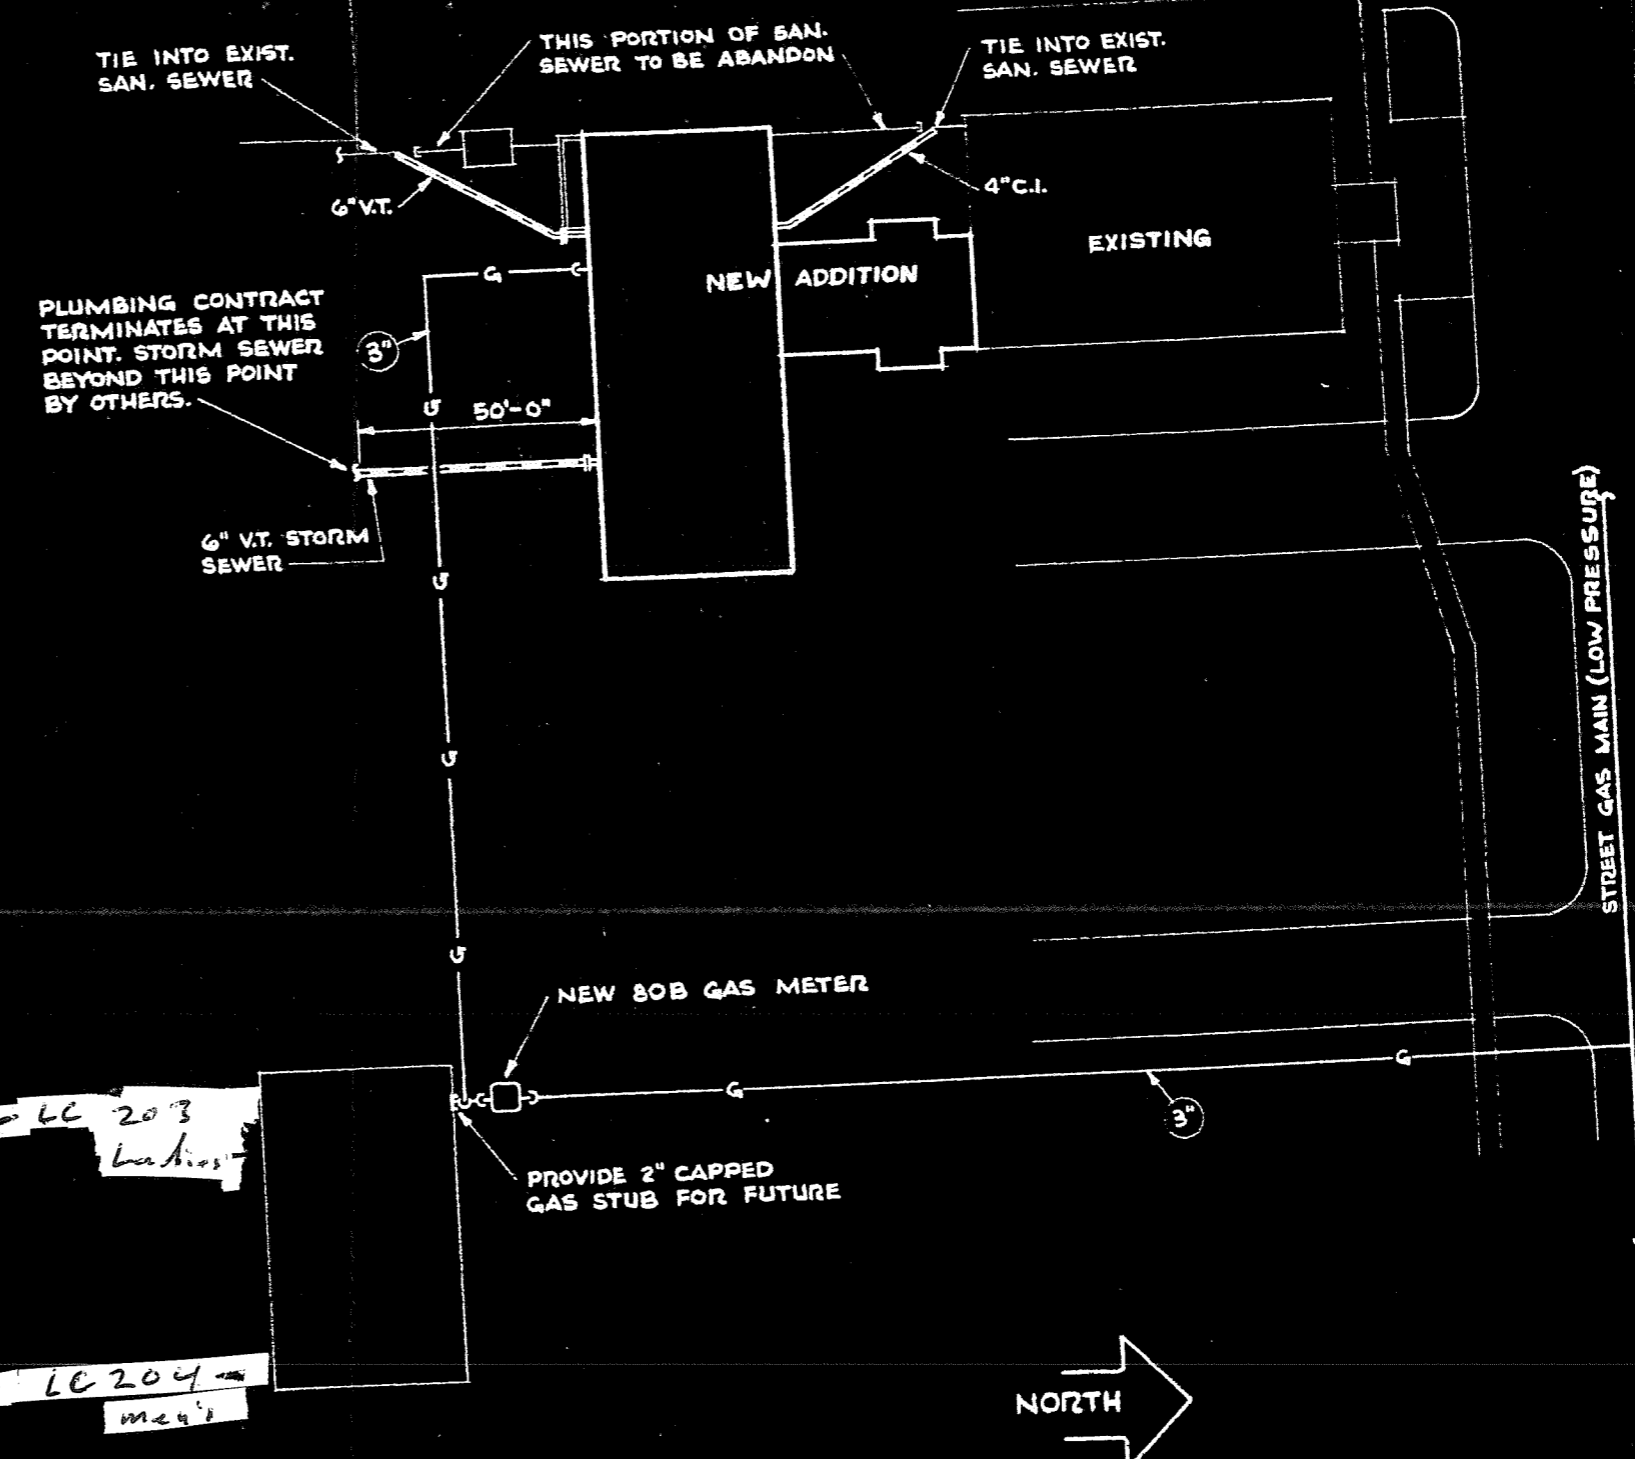


PLUMBING CONTRACT
TERMINATES AT THIS
POINT. STORM SEWER
BEYOND THIS POINT
BY OTHERS.

LC 203
leakies

LC 204
men's

NORTH

PLOT PLAN
1" = 40'-0"

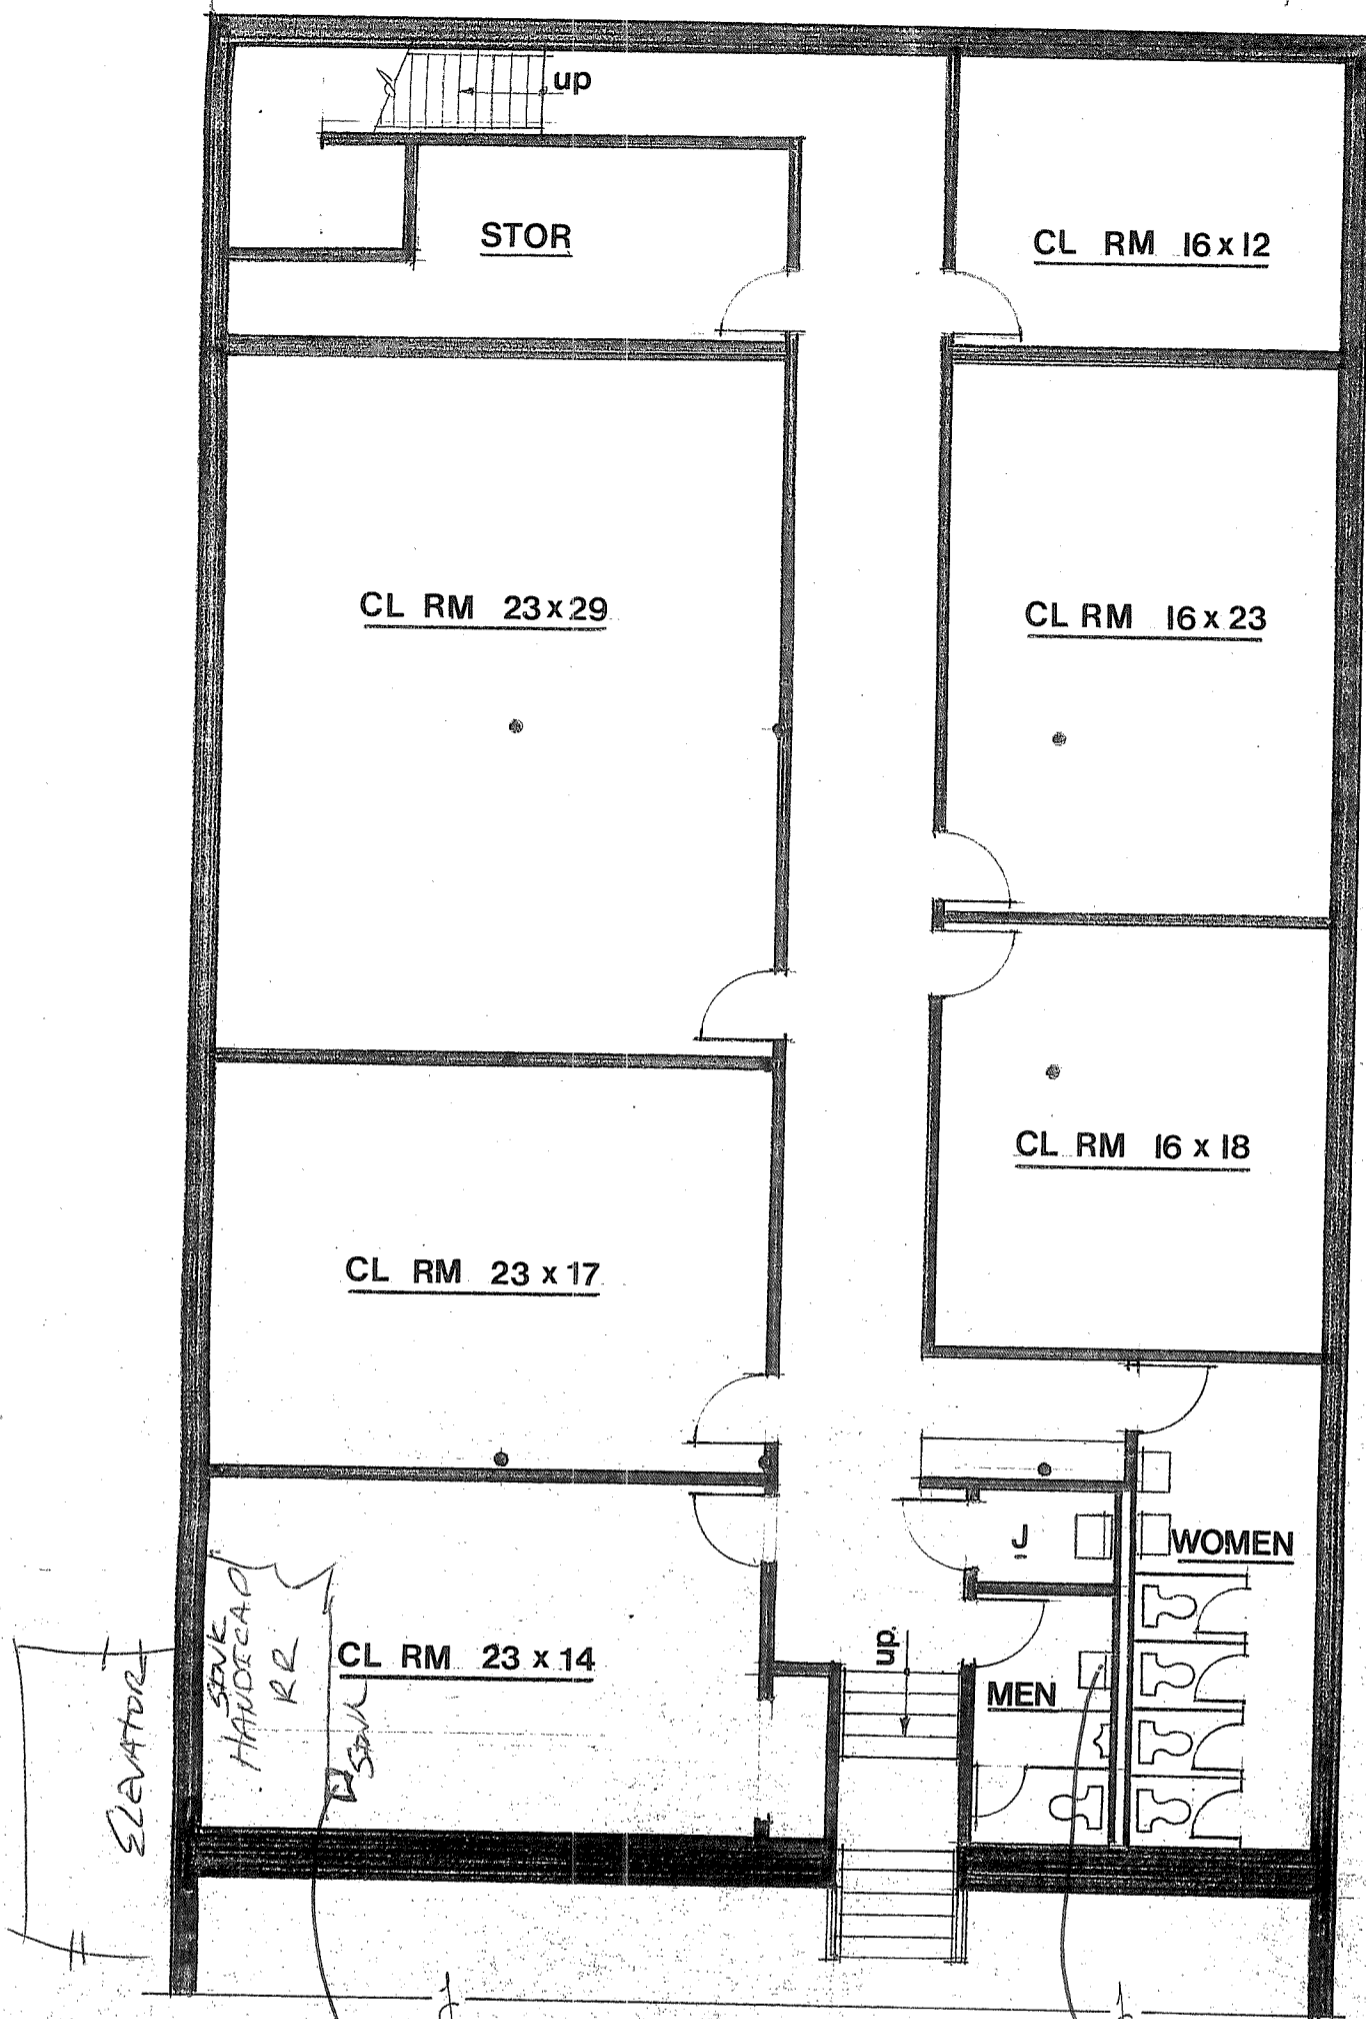


RECEIVED

MAR 11 1980

OHIO EPA NEDO

Kenneth L I

2830 Copley rd. Akron
A. I. R.

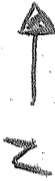

ELEVATOR

HANDICAPED RR

CL RM 23 x 14

MEN

WOMEN

J

LOWER LEVEL


BEZON
SANCTUARY

OAK GROVE

MENNONITE

CHURCH

MARCH 1980

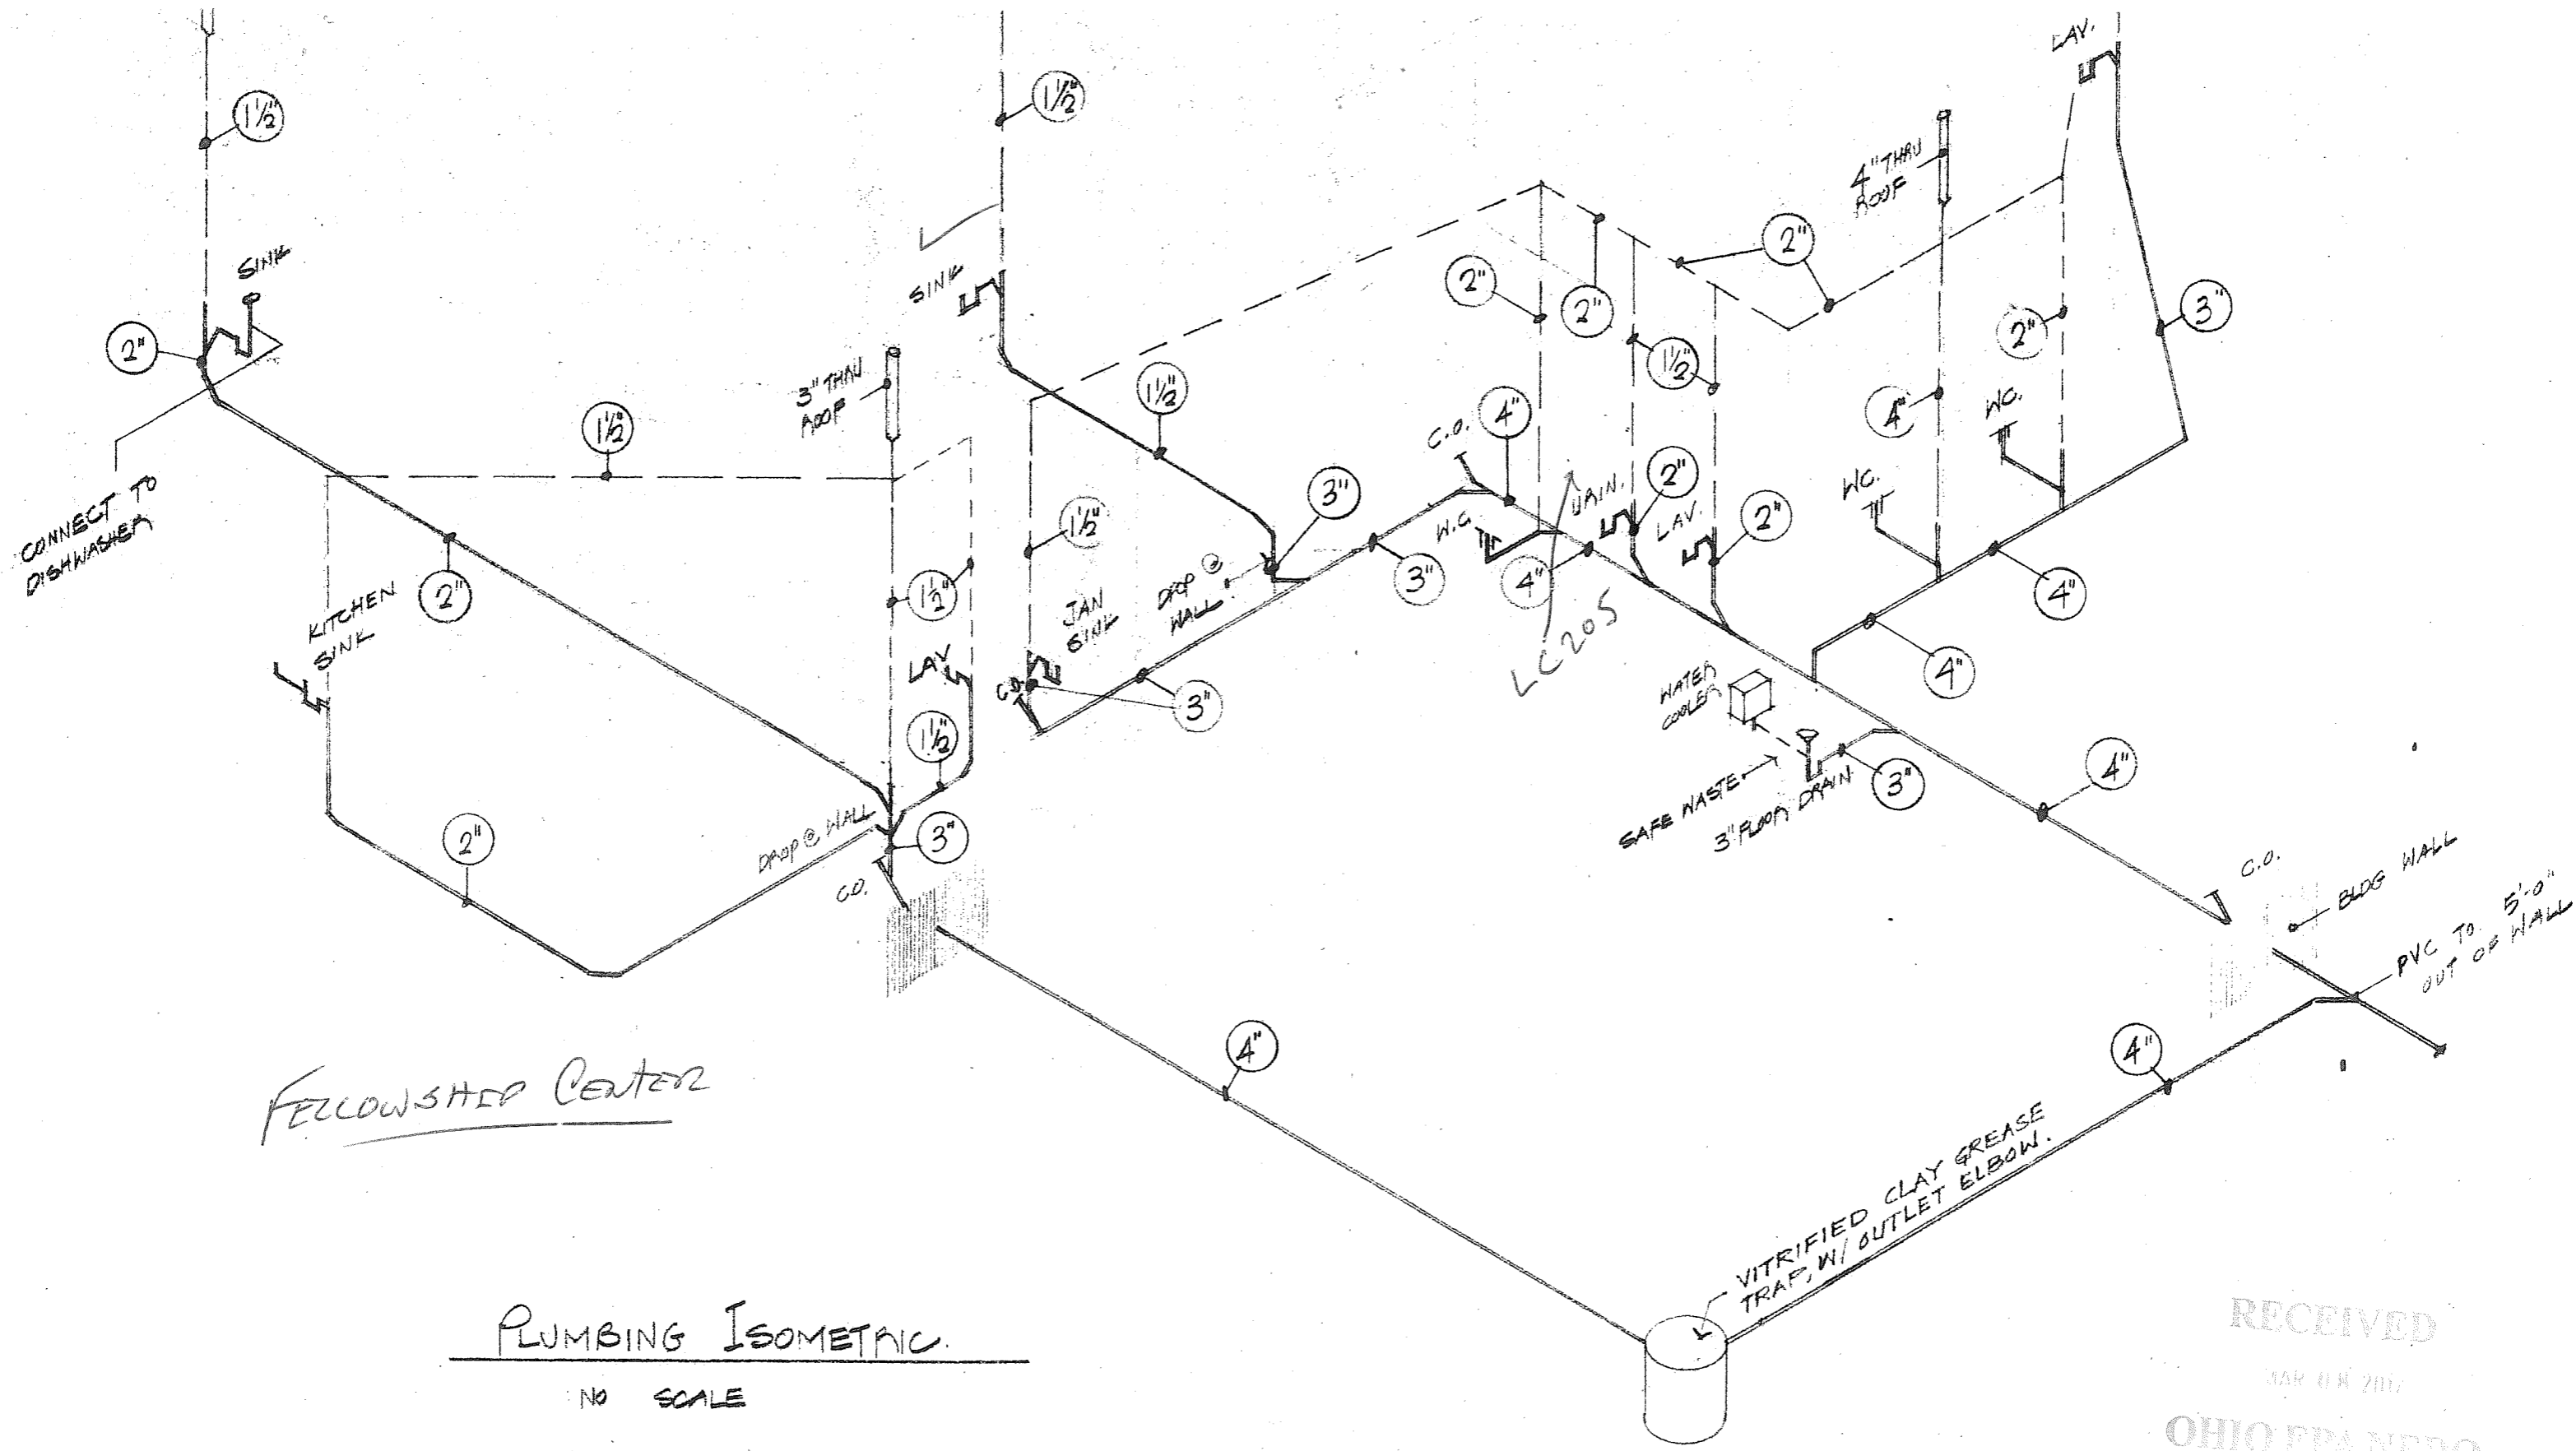


FELLOWSHIP CENTER

PLUMBING ISOMETRIC

NO SCALE

RECEIVED
MAR 04 2014
OHIO EPA NEDD





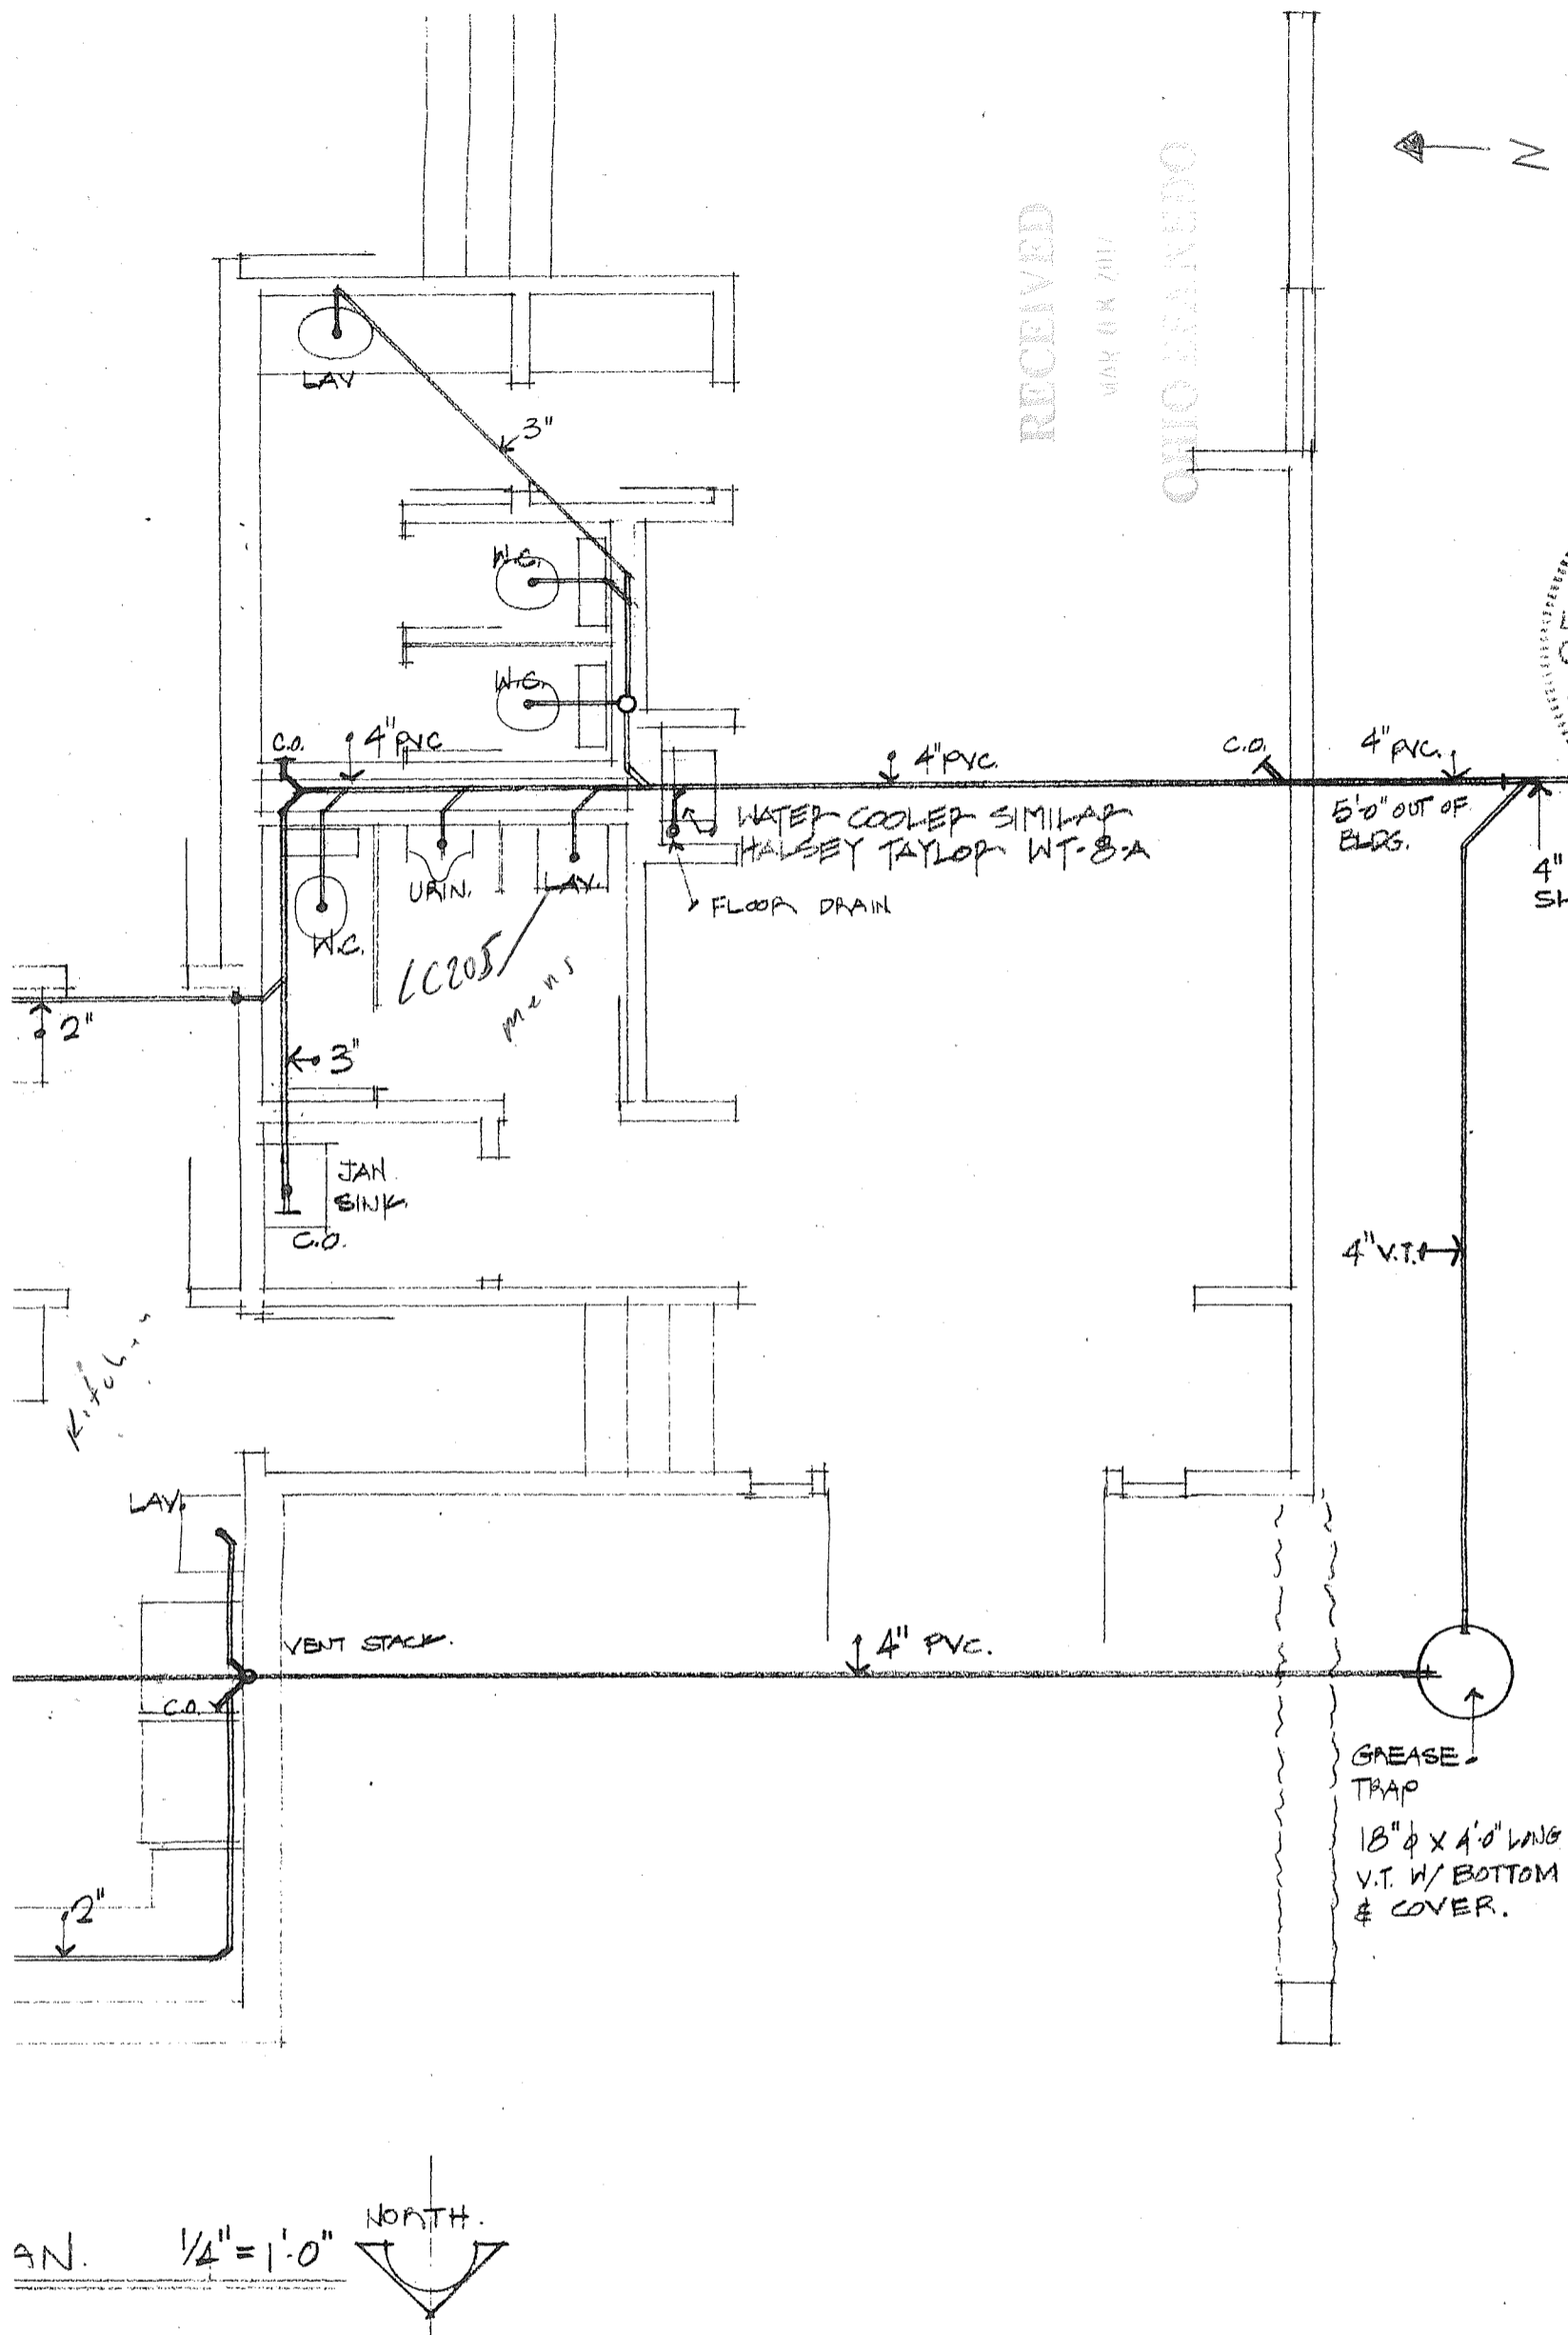

RECEIVED

MAR 18 2017

OHIO DEANEDO

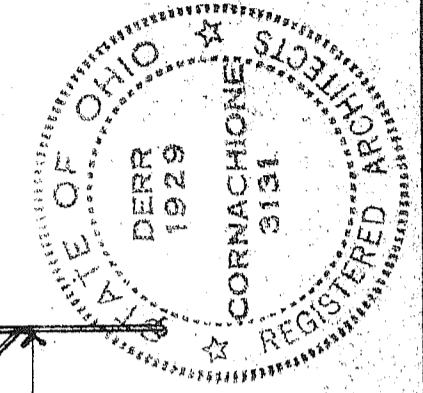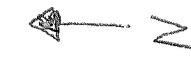

Derr & Cor
2830 COPLEY RD. A

OAK GROVE - FELLOWSHIP HALL
SNYDER ROAD SMITHVILLE
WAYNE COUNTY OHIO.

SEPT. 9, 1975
PHIL & RAY E.
PLUMBING

70
7512

AN. 1/4" = 1'-0" NORTH.