

New Adventures Mantua
11767 Timber Point Trail
Mantua, Ohio 44255
PWS 6782112

Ohio EPA
2110 East Aurora Rd
Twinsburg, Ohio 44087

RE: Guidelines for Mapping Lead Plumbing and Fixtures for Individual Buildings

To whom it may concern:

Upon visual inspection by our well monitoring agent and our maintenance staff, all lines in our facility are lead free. These observations are reinforced by the fact that our facility was built in 1997 and after, so the use of lead products would have been prohibited per the 1996 SDWA amendment, and inspected for by local and county building inspectors.

Should you have any questions, please contact me directly.

Tom


Thomas Lane
Managing Partner
New Adventures LTD.
tlane@naearlylearning.com
216-409-1580

Entity: New Adventures Early Learning
Doc Type: Report
Doc Subtype: _____
Program: DDA/WR
County: Portage
Secondary ID: OH6782112
EDOC in Color

RECEIVED


JAN 25 2017

OHIO EPA NEDO

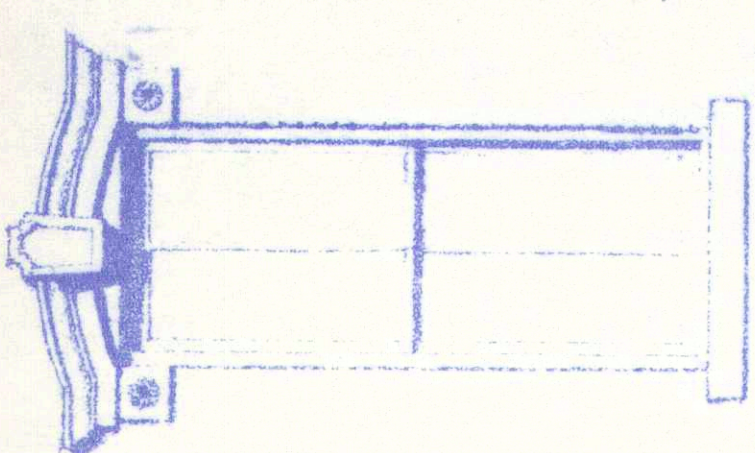

FULLER
DESIGN
GROUP

architects • designers • planners
The Link Building
133 East Main Street
Kent, Ohio 44240
(330) 673-4818

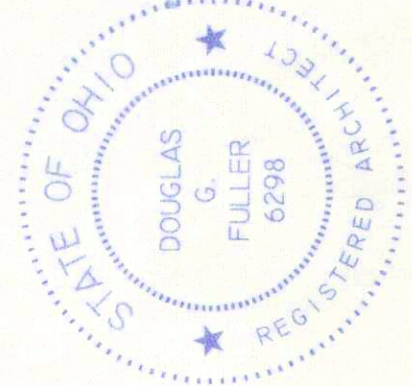


REVISIONS

TIGER TECH
DAY CARE
11767 TIMBER POINTE TRAIL
MANTUA, OHIO

CONTENTS
FLOOR PLAN

PROJECT #
DATE
7/18/05 06:41

A2
PRESENTATION
© Fuller Design Group

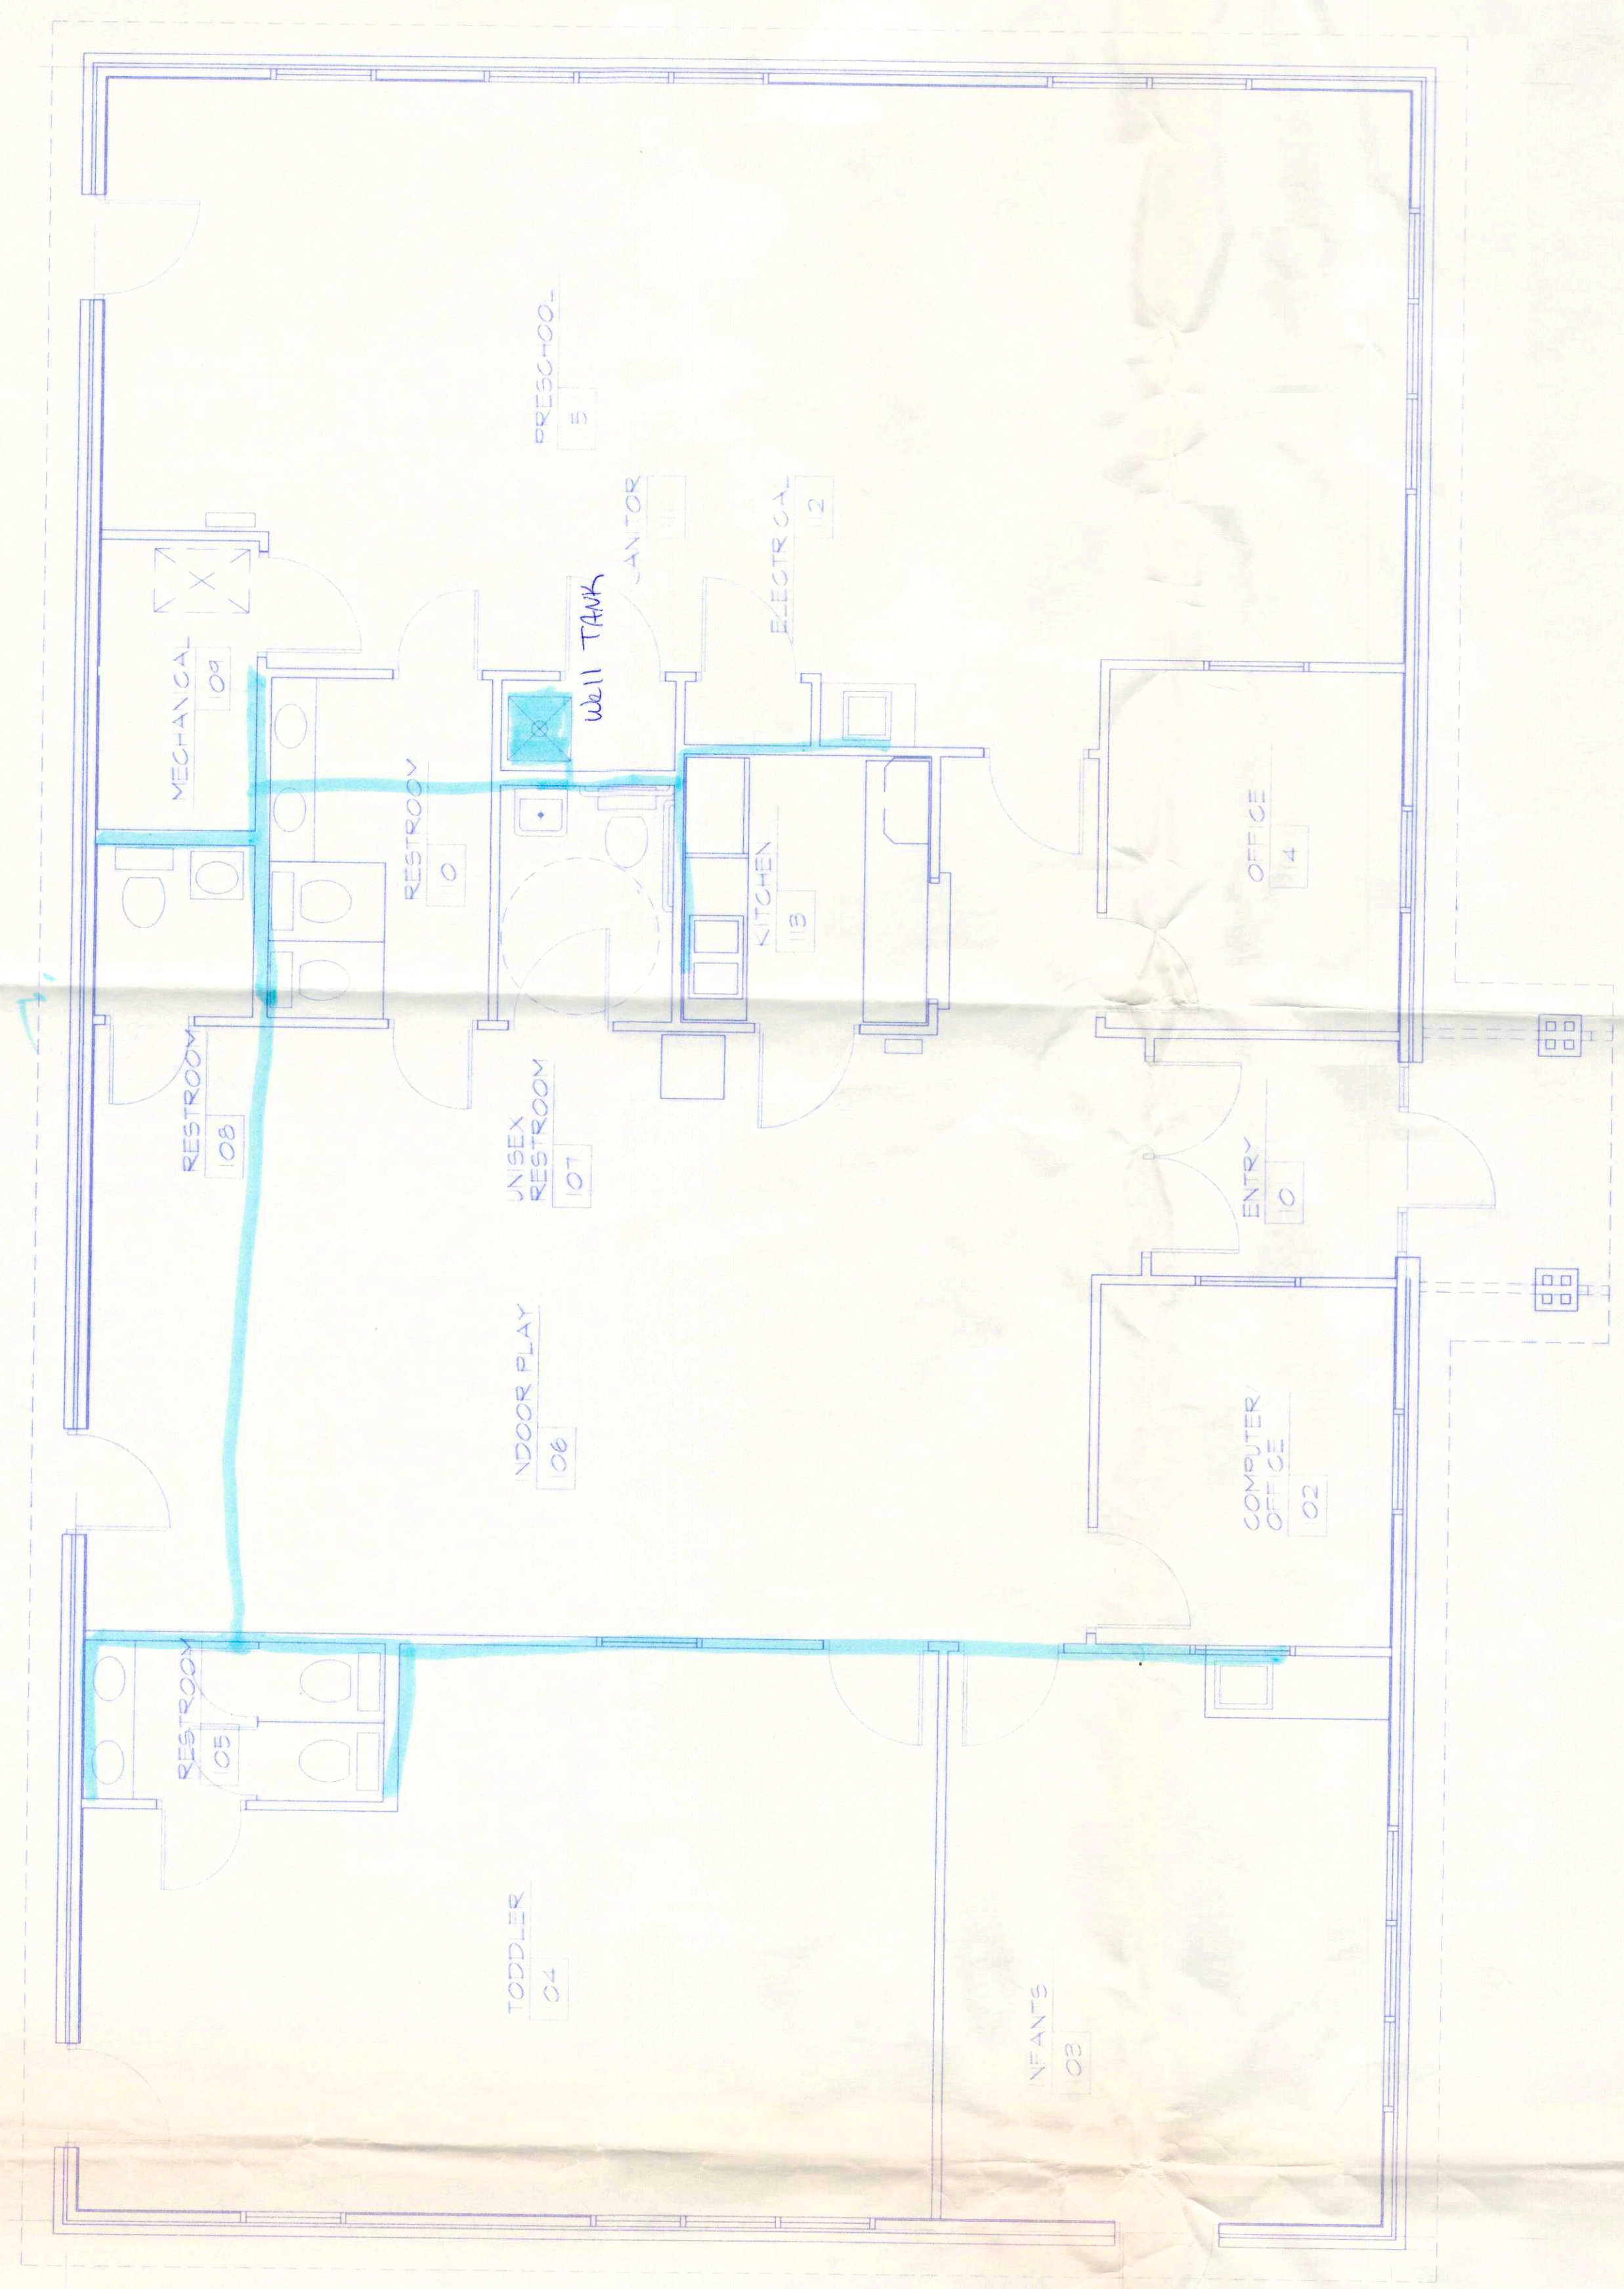

FIRST FLOOR PLAN
1/4" = 1'-0"

PWS 6782112
New Adventures Mantua
11767 Timber Point Trail
Mantua OH 44255
Contact: Thomas Lane
216 409 1580

ALL LINES COPPER
AND NON-LEAD SOLDER