



INDUSTRIAL FLUID MANAGEMENT, INC.

MCCLURE OH | ATLANTIC, IA | HILLIARD OH

March 8, 2017

Dan Osterfeld

Ohio EPA, Central District Office
Division of Drinking and Ground Water
50 West Town Street
Columbus, Ohio 43215

Re: Pilot Travel Center 285
PWS ID: ~~OH4555645~~ OH4556412
Hebron, Ohio
Licking County

Mr. Osterfeld,

Enclosed you will find, as per House Bill 512, lead mapping and SMP ID for Pilot 285 in Hebron, Ohio.



From Pilot records, we could ascertain the facilities were developed in 1998. We are assuming these are the original wells, and have verified the lines from the well to the facility are plastic. All piping in the water treatment system is schedule 80 PVC, all lines in the facility are soldered copper. Information on the piping was obtained from a contracted plumber's visual inspection. We did include the disclaimer on the maps.

We are assuming most of the copper is original and the fixtures would be 1998 or newer. The men's and women's restrooms were remodeled between 2012 and 2013, so these would be newer fixtures.

Along with submitting to the Ohio EPA, I have also submitted a copy of this packet to the Ohio Department of Health and Jobs and Family Services.

Regards,

Ann Scott

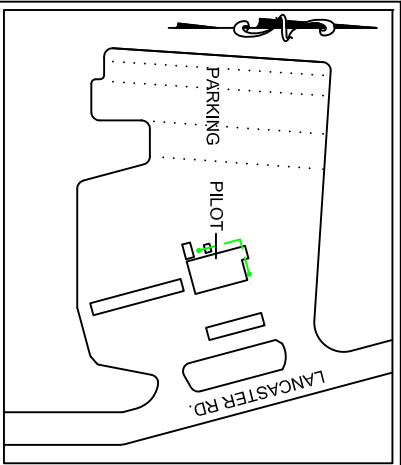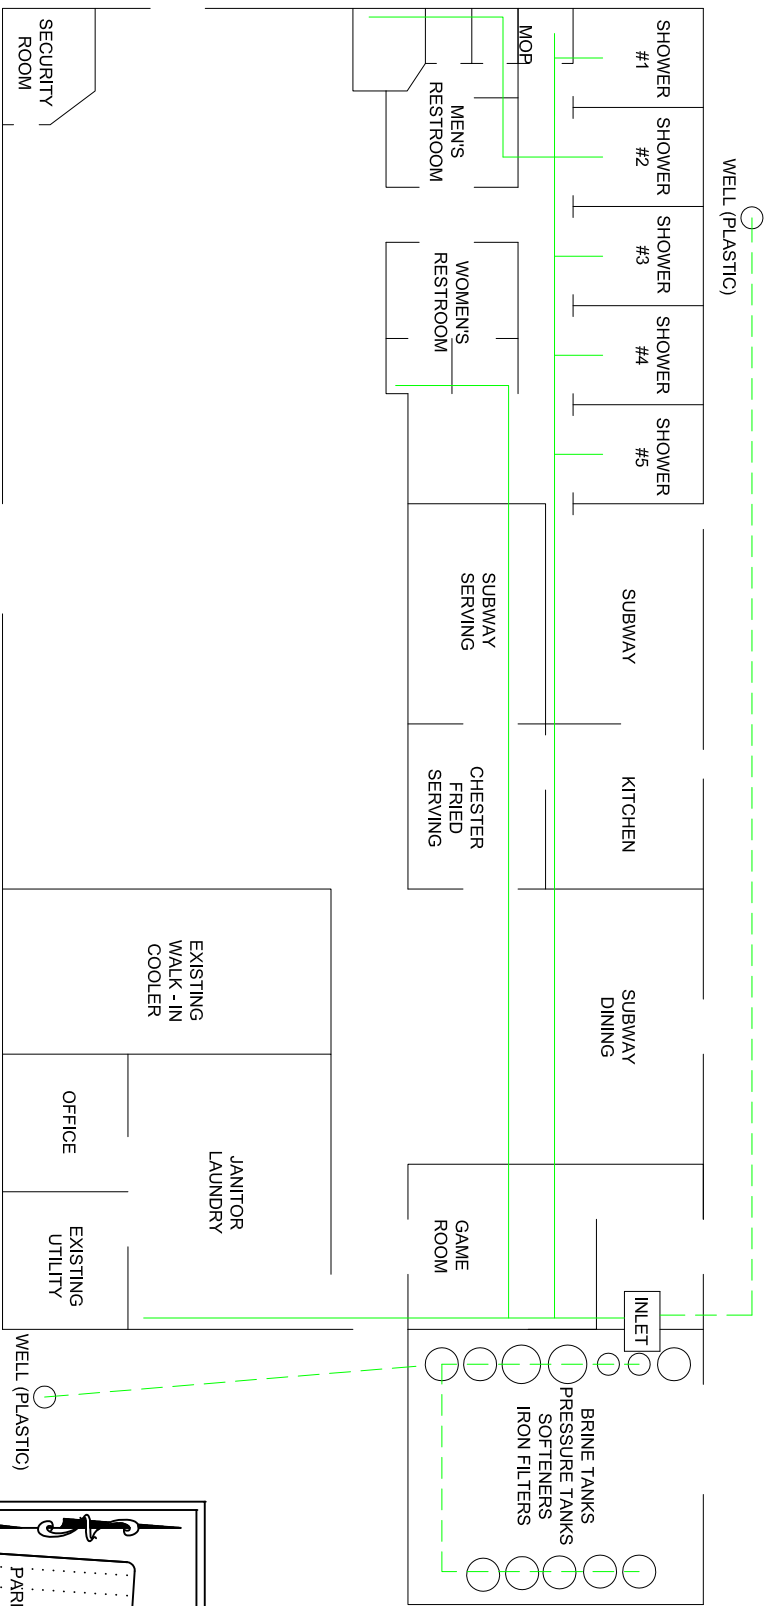

THE FACILITY WAS BUILT IN 1998
 LINE FROM WELLS TO BUILDING ARE PLASTIC
 ALL PIPING IN WATER TREATMENT SYSTEM IS PVC (VISUAL)
 ALL PIPING INSIDE THE FACILITY IS SOLDERED COPPER (VISUAL)
 RESTROOMS REMODELED IN 2012-2013

DRAWING IS REPRESENTATION OF WATER AND SEWER LINES. DO NOT USE FOR
 BUILDING OR DIGGING. DRAWING IS REFERENCE ONLY.

Buildings in Ohio built prior to 1998 or that use plumbing material or solder manufactured before 1998 may have materials with greater than 8% lead and are at a higher risk of contributing lead to the drinking water than materials manufactured after 1998. In addition, buildings built and plumbing materials manufactured after 2014 were required to have less than 0.25% lead by weight and have the lowest risk for contributing lead to the drinking water. It should be noted however that, although prohibited, some use of leaded solder or leaded components may have occurred after the prohibitions became effective.

LEGEND:

PVC / PLASTIC		PILOT OIL COMPANY - HEBRON 285
SOLDERED COPPER		10258 LANCASTER RD HEBRON, OH 43025

PWS ID: OH456412