


* SCHOOL WAS BUILT IN 1999
 WITH COPPER PIPING USING LEAD
 FREE SOLDER.


RECEIVED
 MAR 06 2017
 OHIO EPA NEDO

Entity: West Holmes HS
 Doc Type: Report
 Doc Subtype: _____
 Program: PDAW
 County: Holmes
 Secondary ID: 0N3847812
 * PDA in color

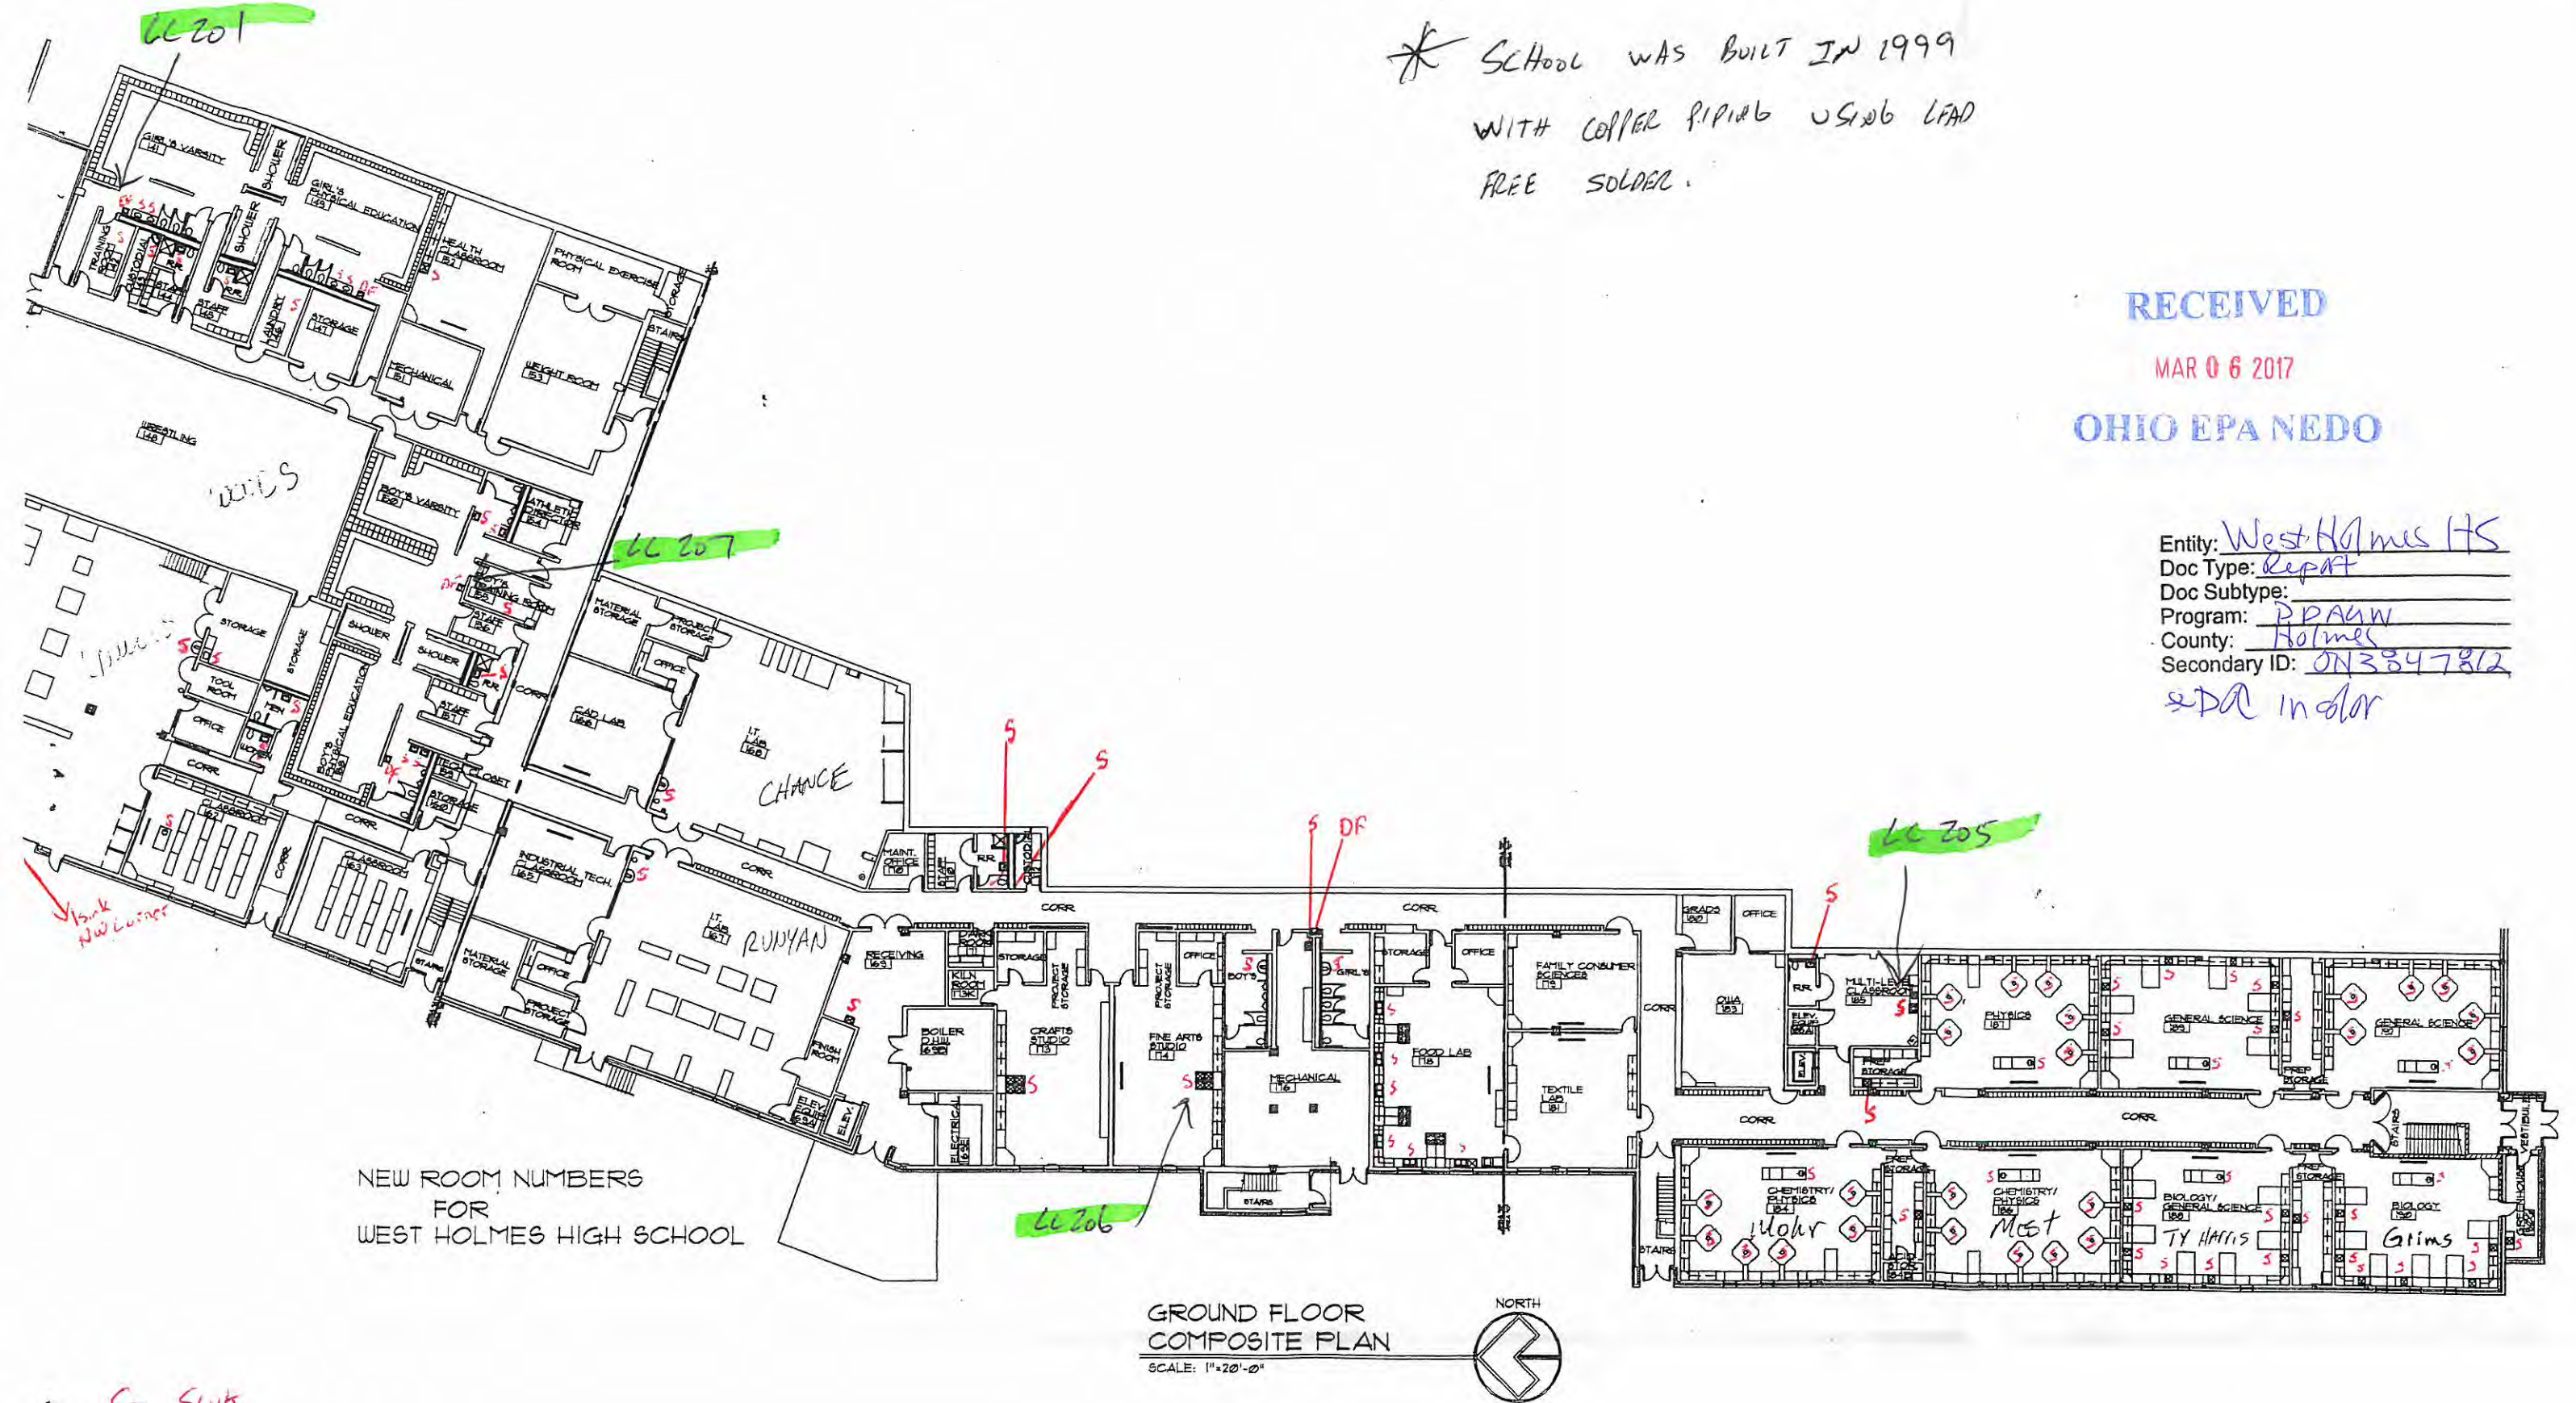


NEW ROOM NUMBERS
 FOR
 WEST HOLMES HIGH SCHOOL



GROUND FLOOR
 COMPOSITE PLAN
 SCALE: 1"=20'-0"

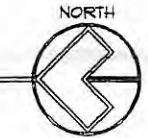

S- SINK
 DF- DRINKING FOUNTAIN

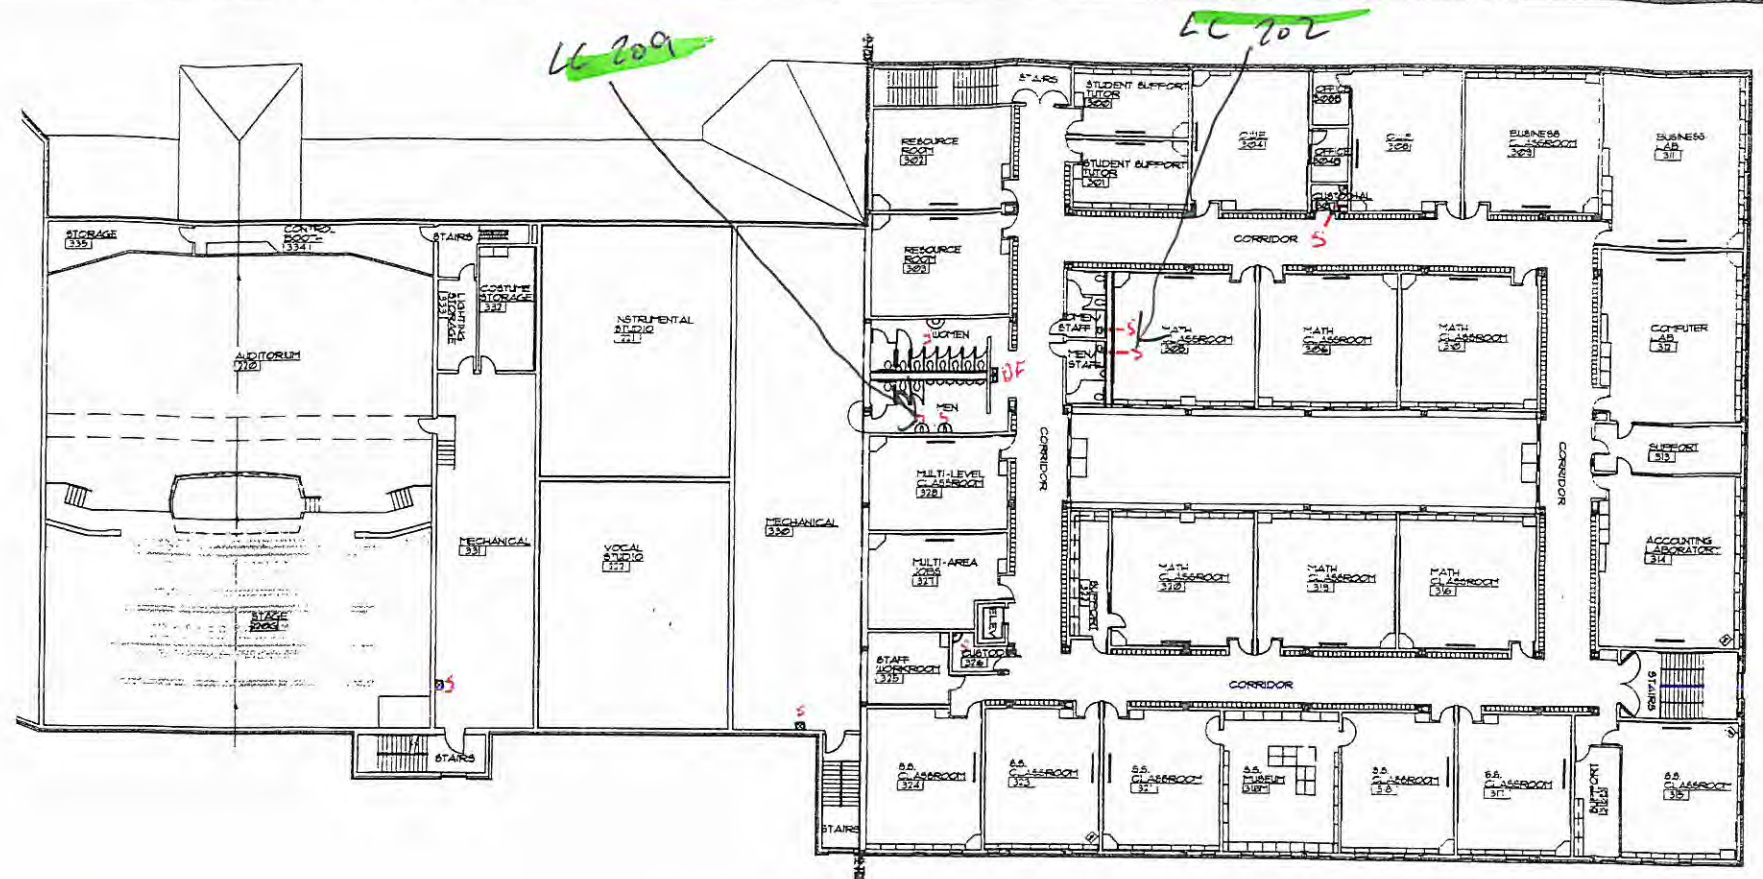

SECOND FLOOR
COMPOSITE PLAN
SCALE: 1"=20'-0"

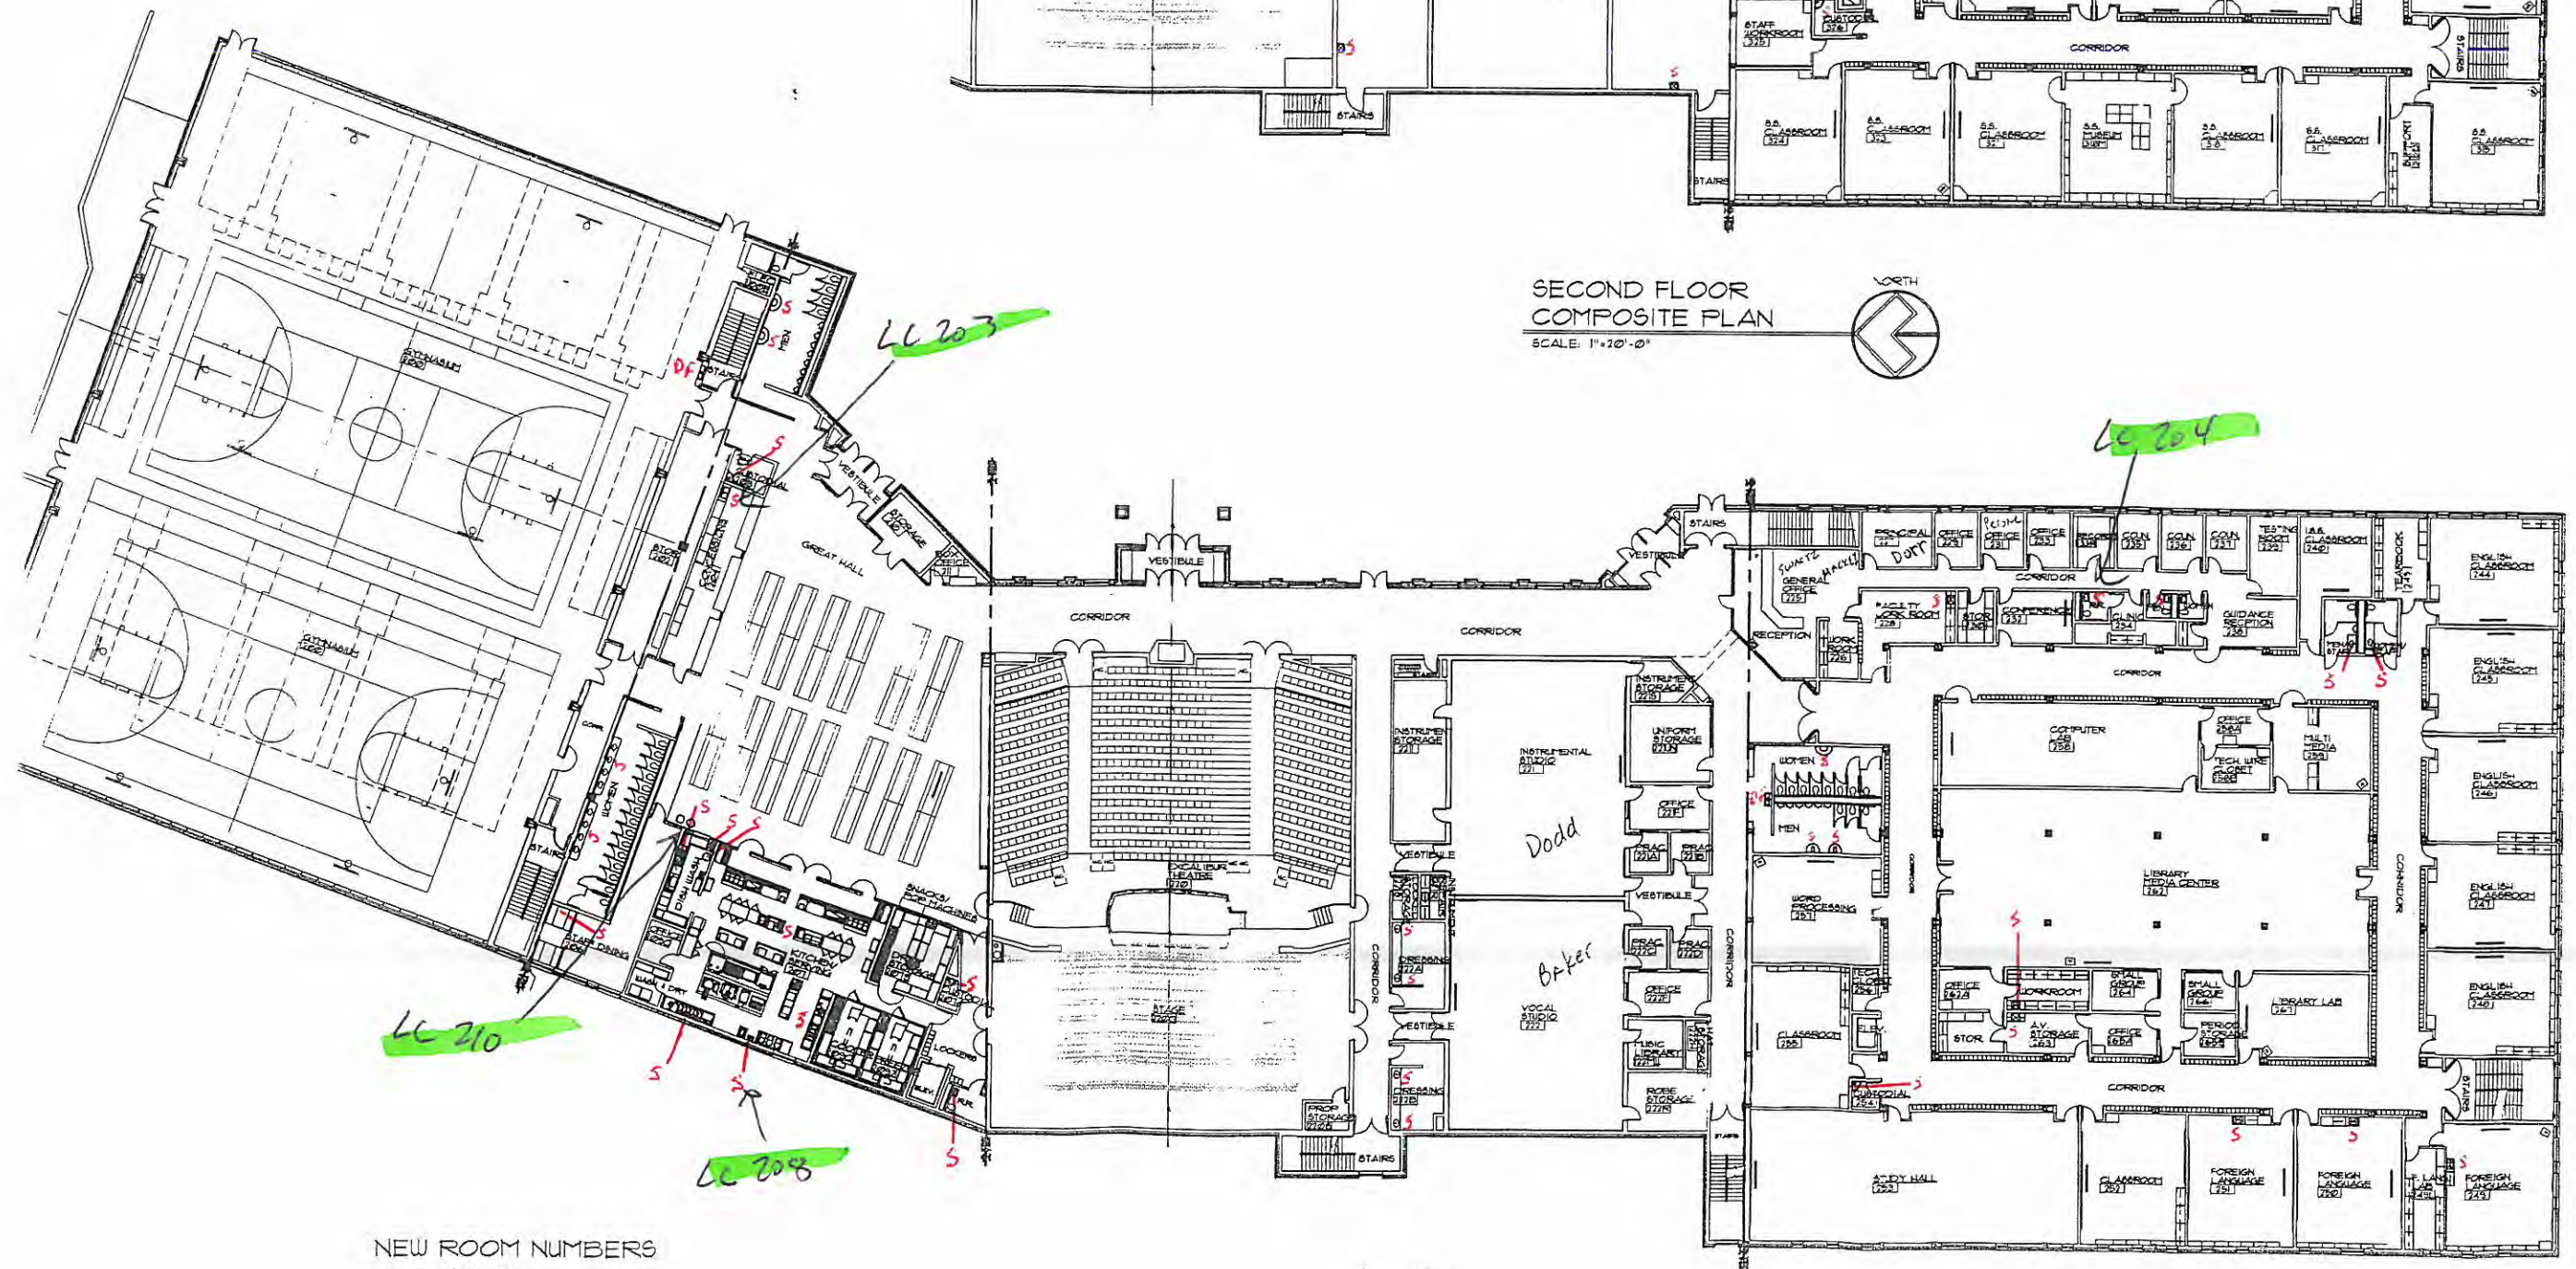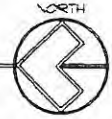

NEW ROOM NUMBERS