


Ductile pipe
No lead fixtures or solder

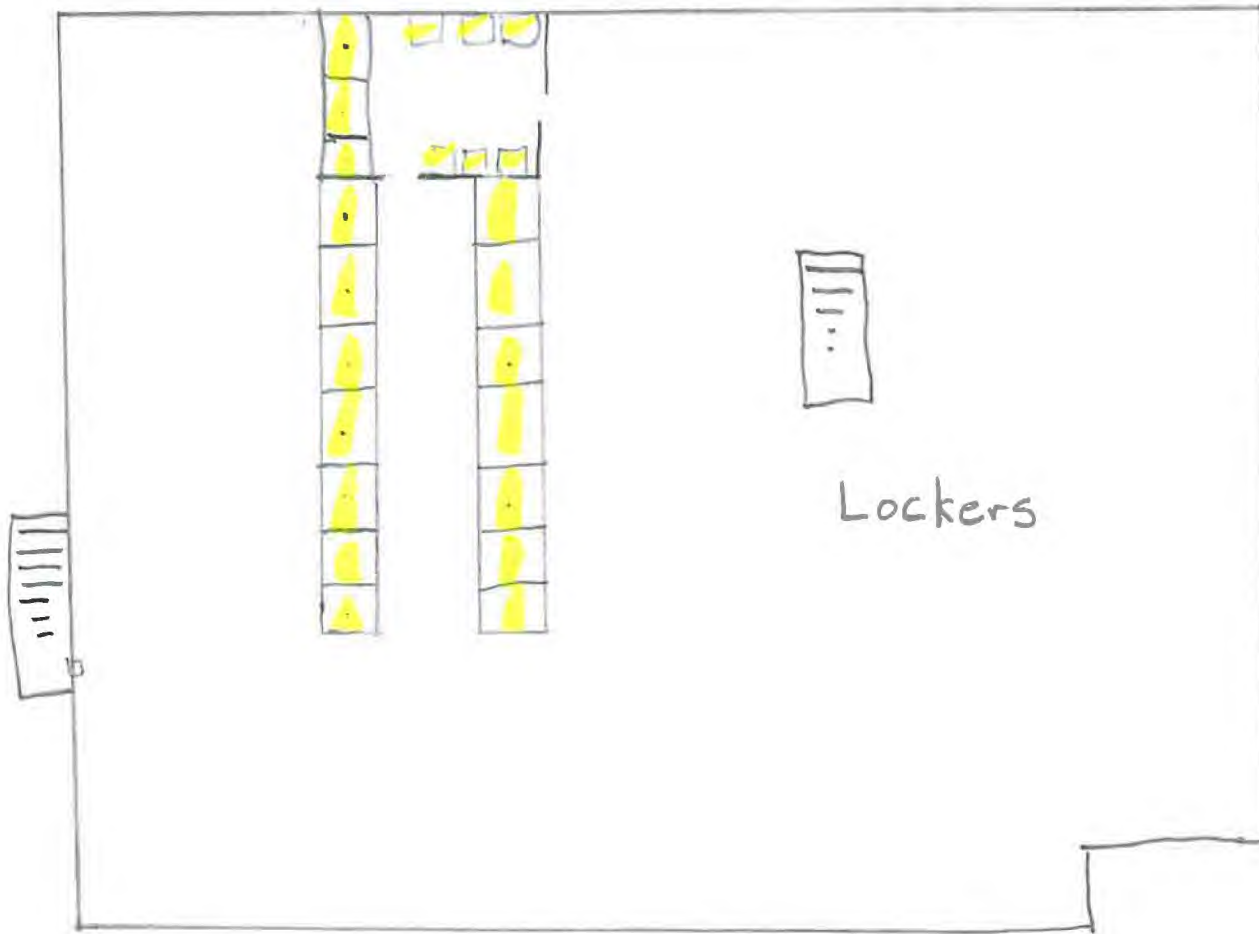


Basement level

18 showers

6 sinks

Ductile pipe

No lead fixtures or solder

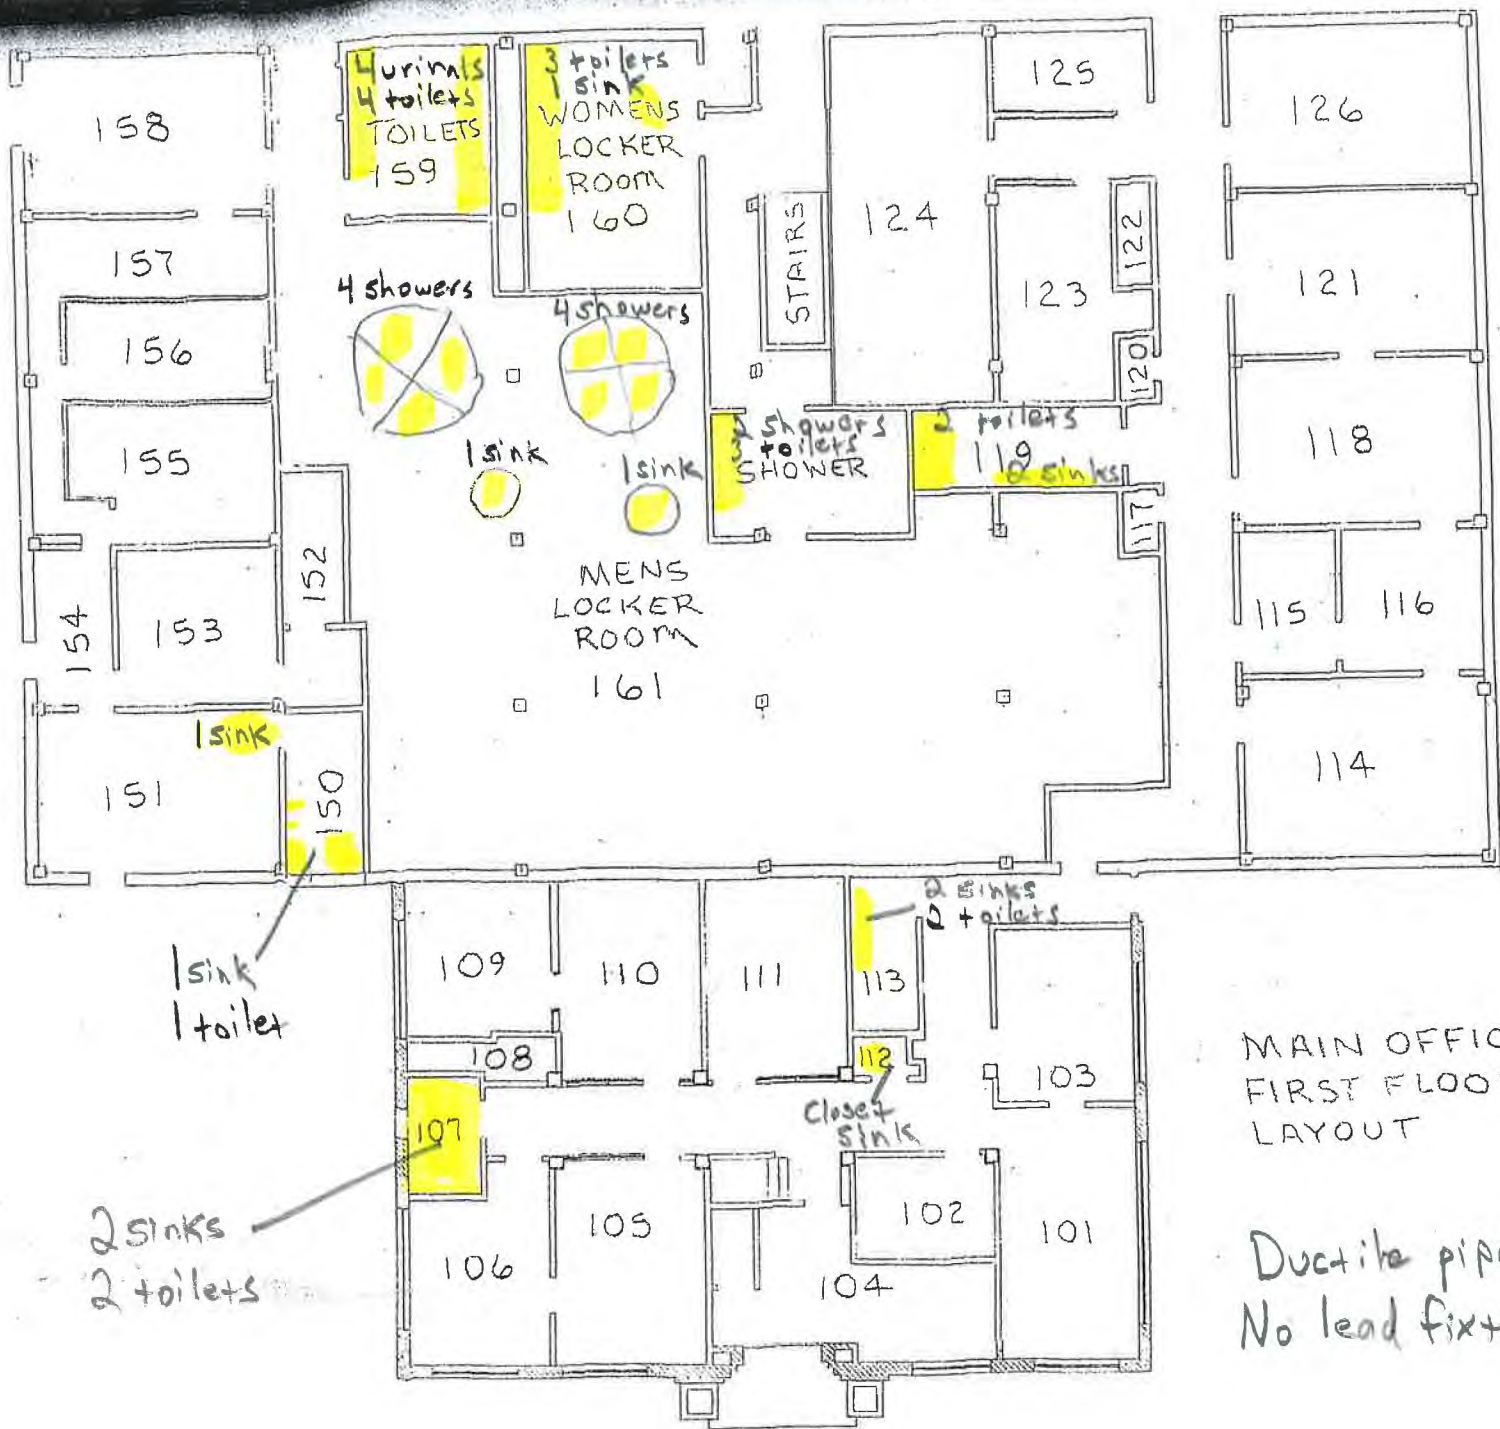


MAIN OFFICE
FIRST FLOOR
LAYOUT

Ductile pipe
No lead fixtures or solder

Canton Drop Forge
 4575 Southway Street SW
 Canton OH, 44706
 Facility ID# 7660602

— = Lead pipe
— = Ductile Iron
— = Galvanized

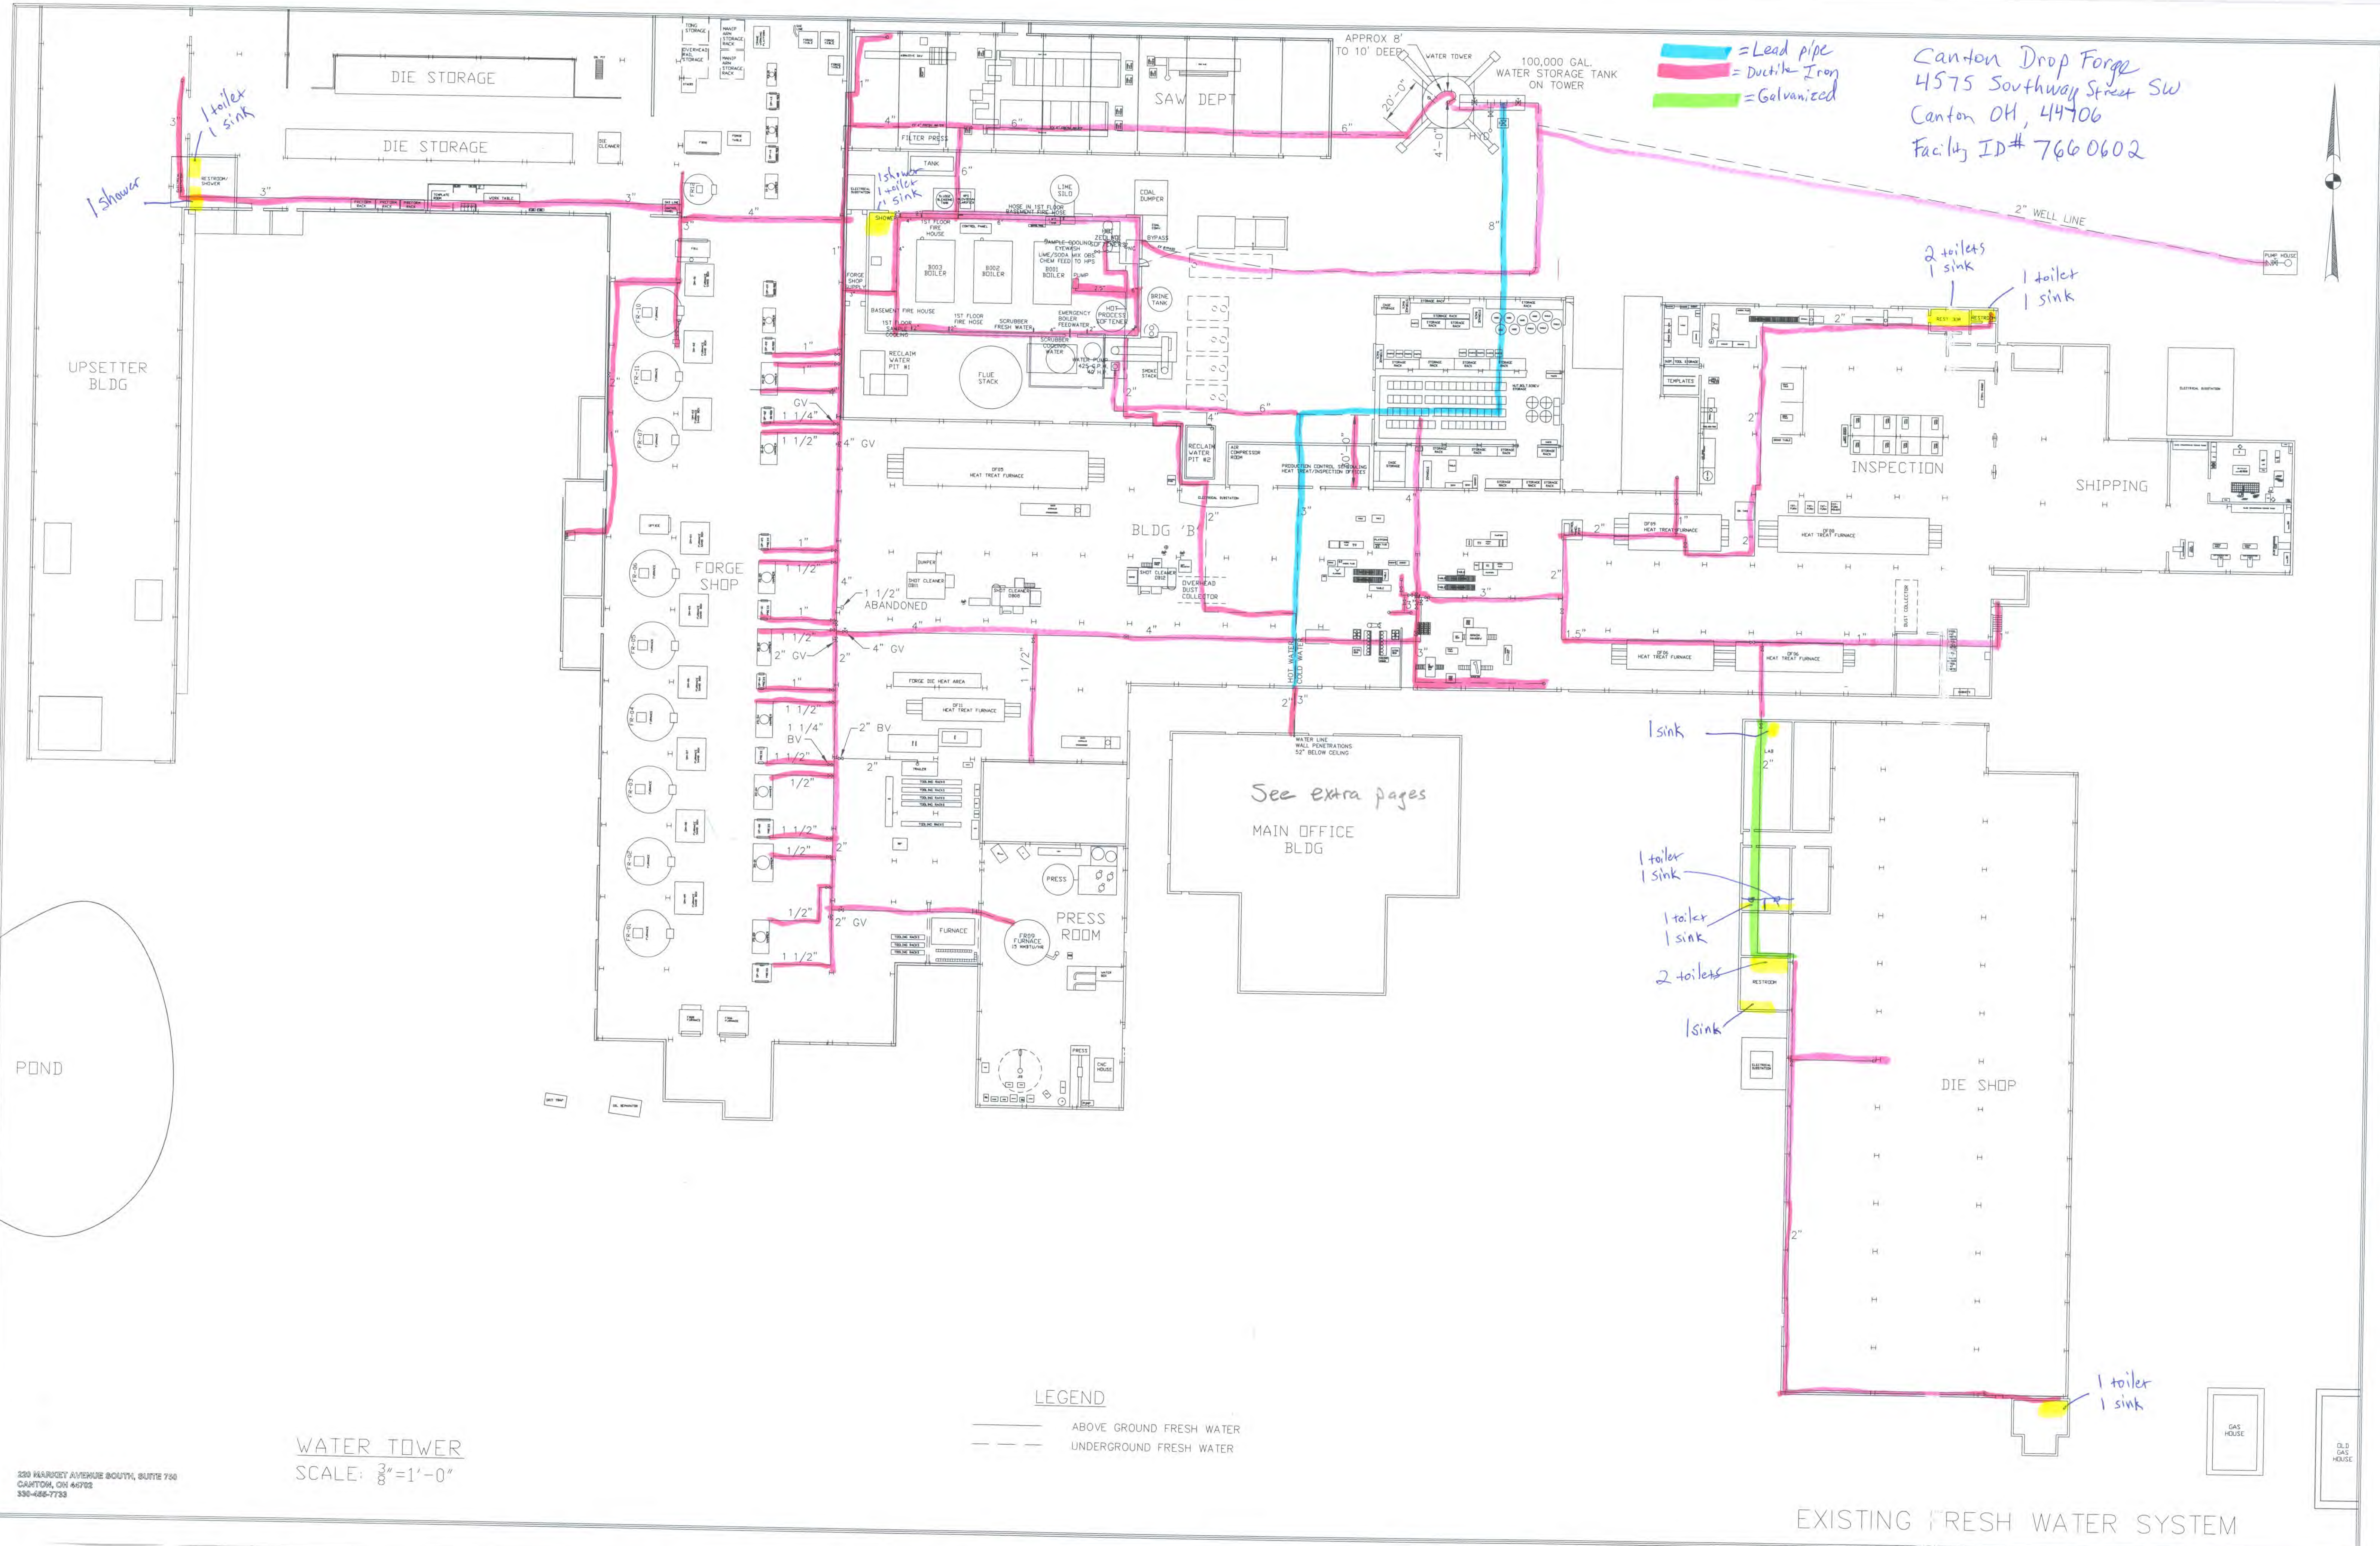

LEGEND
 ——— ABOVE GROUND FRESH WATER
 - - - UNDERGROUND FRESH WATER

WATER TOWER
 SCALE: 3/8" = 1'-0"

330 MARSHLET AVENUE SOUTHWAY, SUITE 750
 CANTON, OH 44702
 330-486-7733

EXISTING FRESH WATER SYSTEM