


# Leroy Elementary

13613 Painesville-Warren Road  
Painesville, OH 44077

## Fixture Key

- U** = Utility Sink
- WF** = Water Fountain
- S** = Hand Washing Sink
- D** = Dishwasher
- HW** = Hot Water Tank
- HWB** = Hot Water Booster
- = Cold Water Line
- = Hot Water Line
- = Building Addition Breaks

No known major plumbing updates have been performed since 1994. We have made minor repairs and replaced water fountains, but cannot confirm all materials used are post 2014.

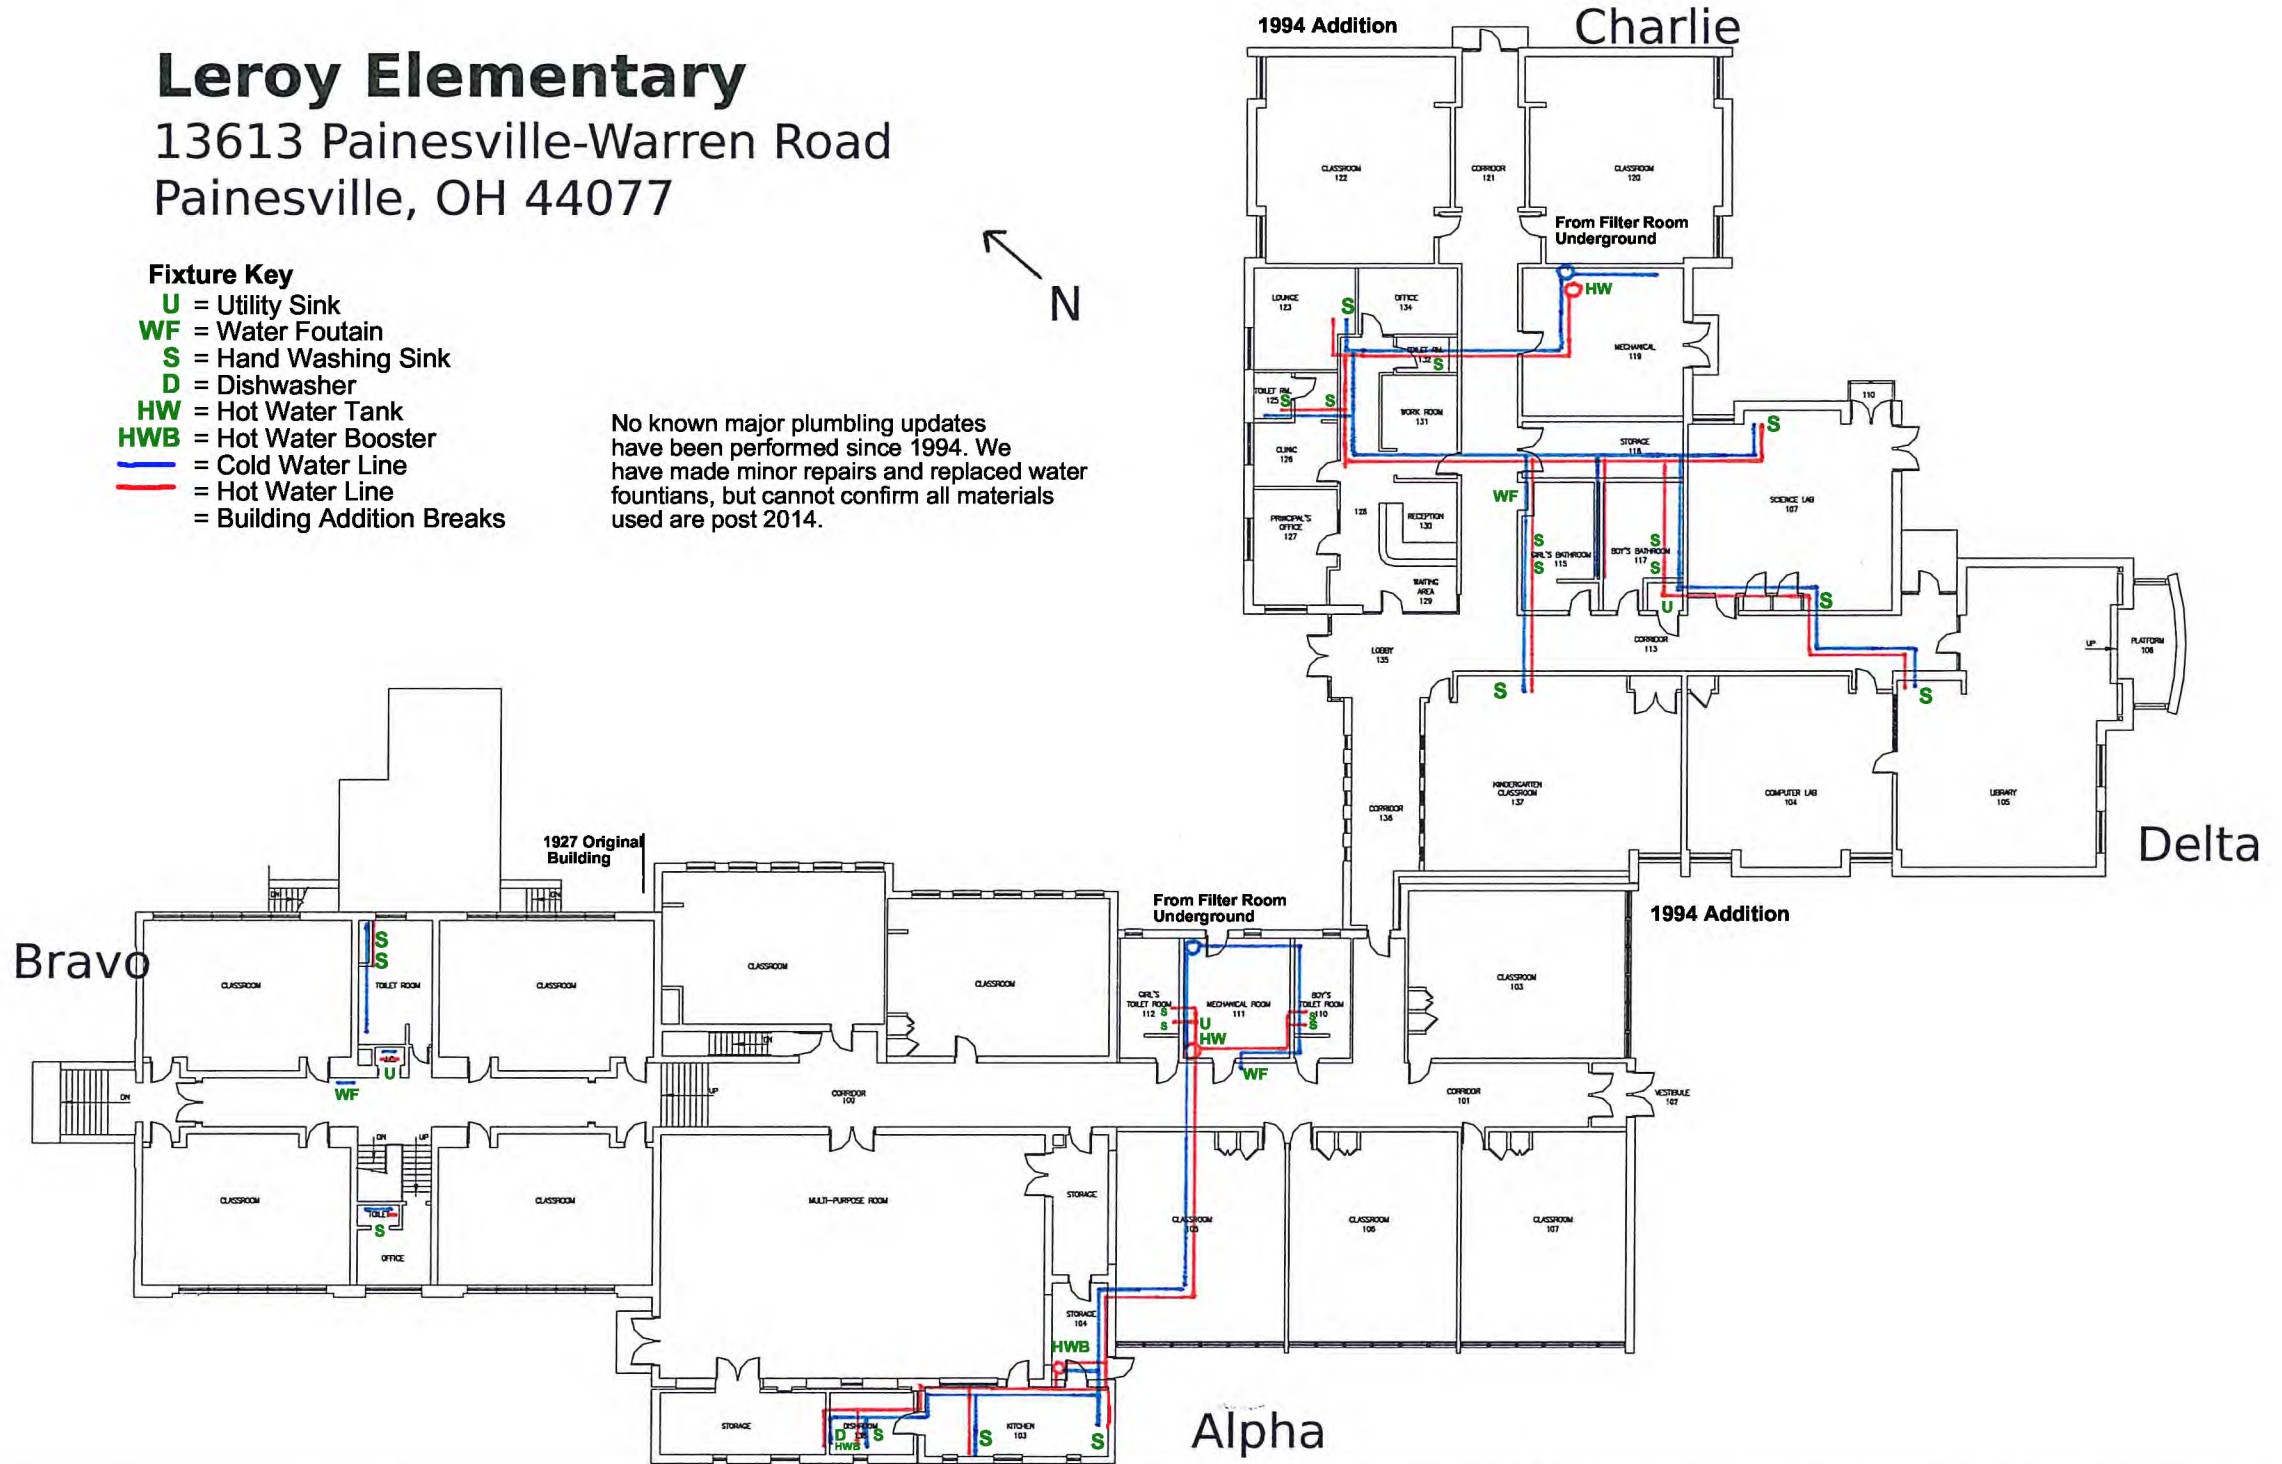

# Leroy Elementary

## Basement

