


PWS ID: 048560612

Lehman's Hardware
4779 Kidron Rd
Kidron, Ohio 44636

330 857 5757

3/6/2017

MEETING LOCATION

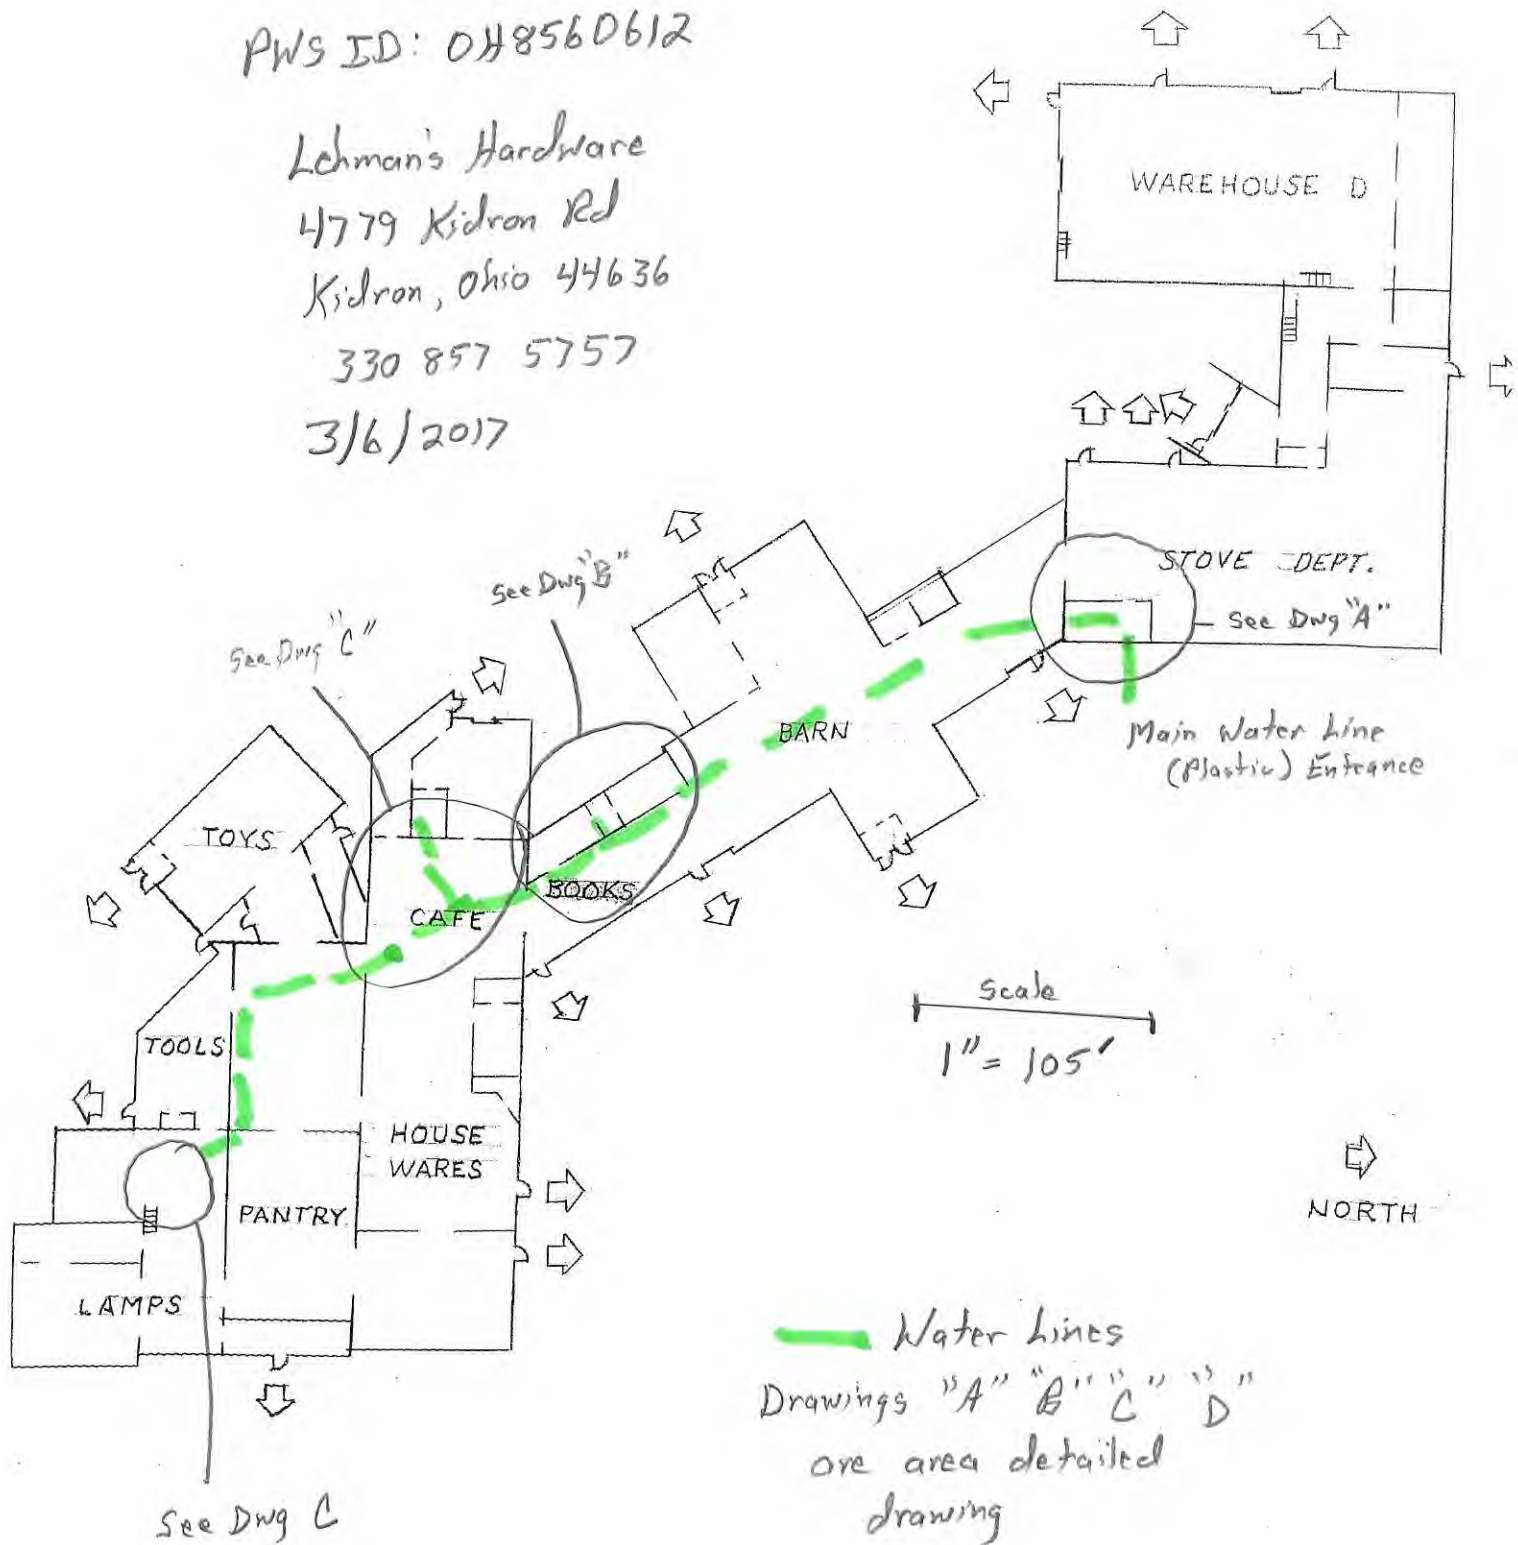

Water Lines
Drawings "A" "B" "C" "D"
are area detailed
drawing

KIDRON STORE
5-3-11

W


(A)

Water Softener

Room

Plastic

Hall

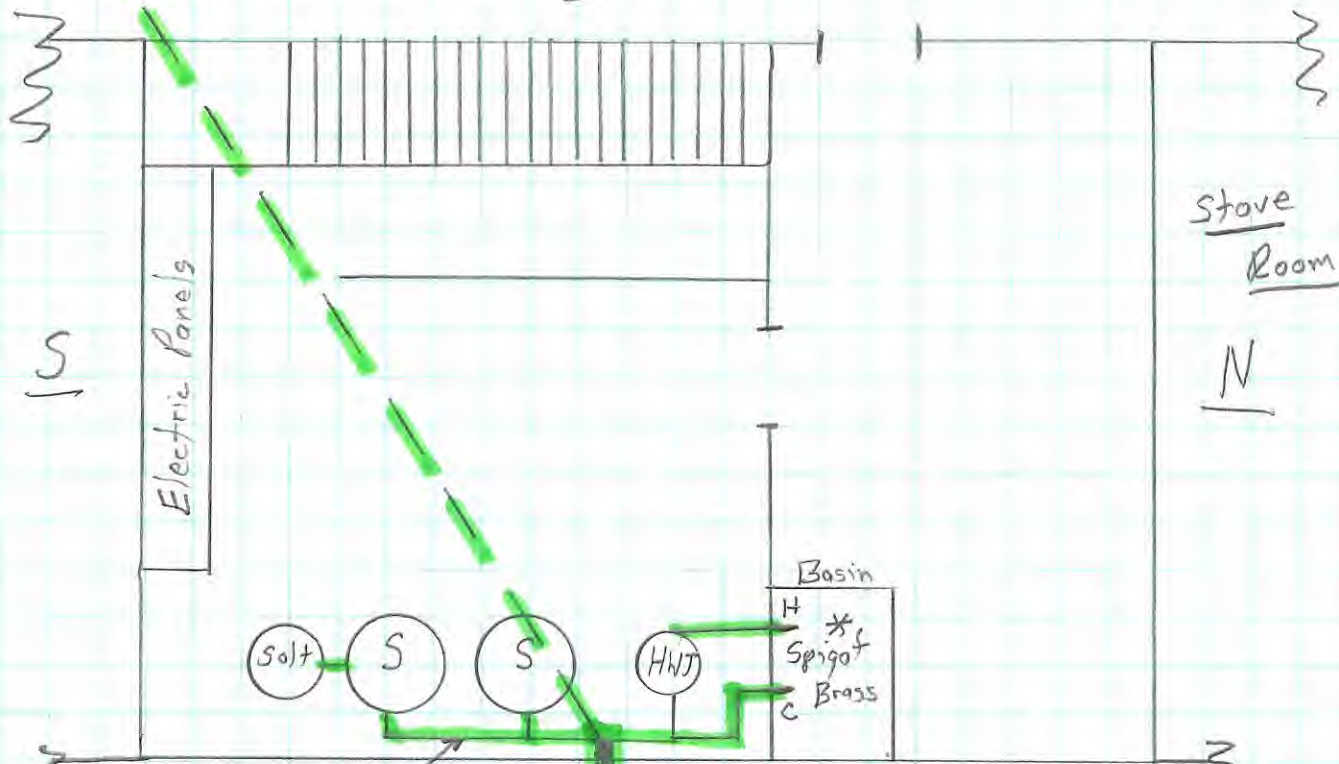

Stove
Room

S

Electric Panels

N

Basin

Salt

S

S

HNT

H
*
Spigot
C
Brass

Wavy line symbol

Plastic

Main Water Line


Entrance

(Plastic)

E

(B)

W

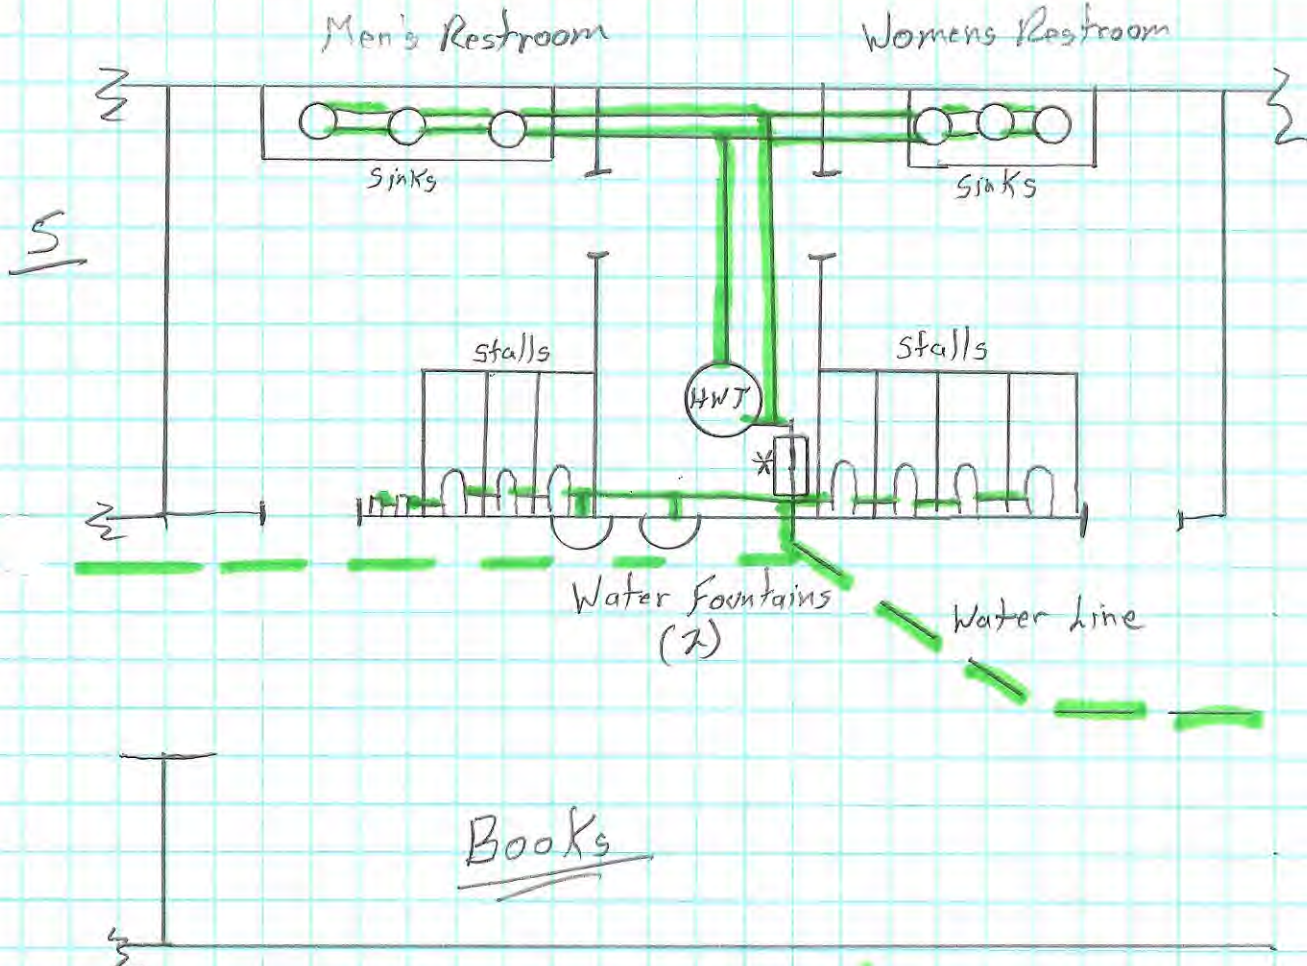


- Fixtures for sinks
and water fountain
are brass

* Copper/solder water lines
by Hot Water Tank.
Other water lines plastic.

E

(C)

W Parking Lot

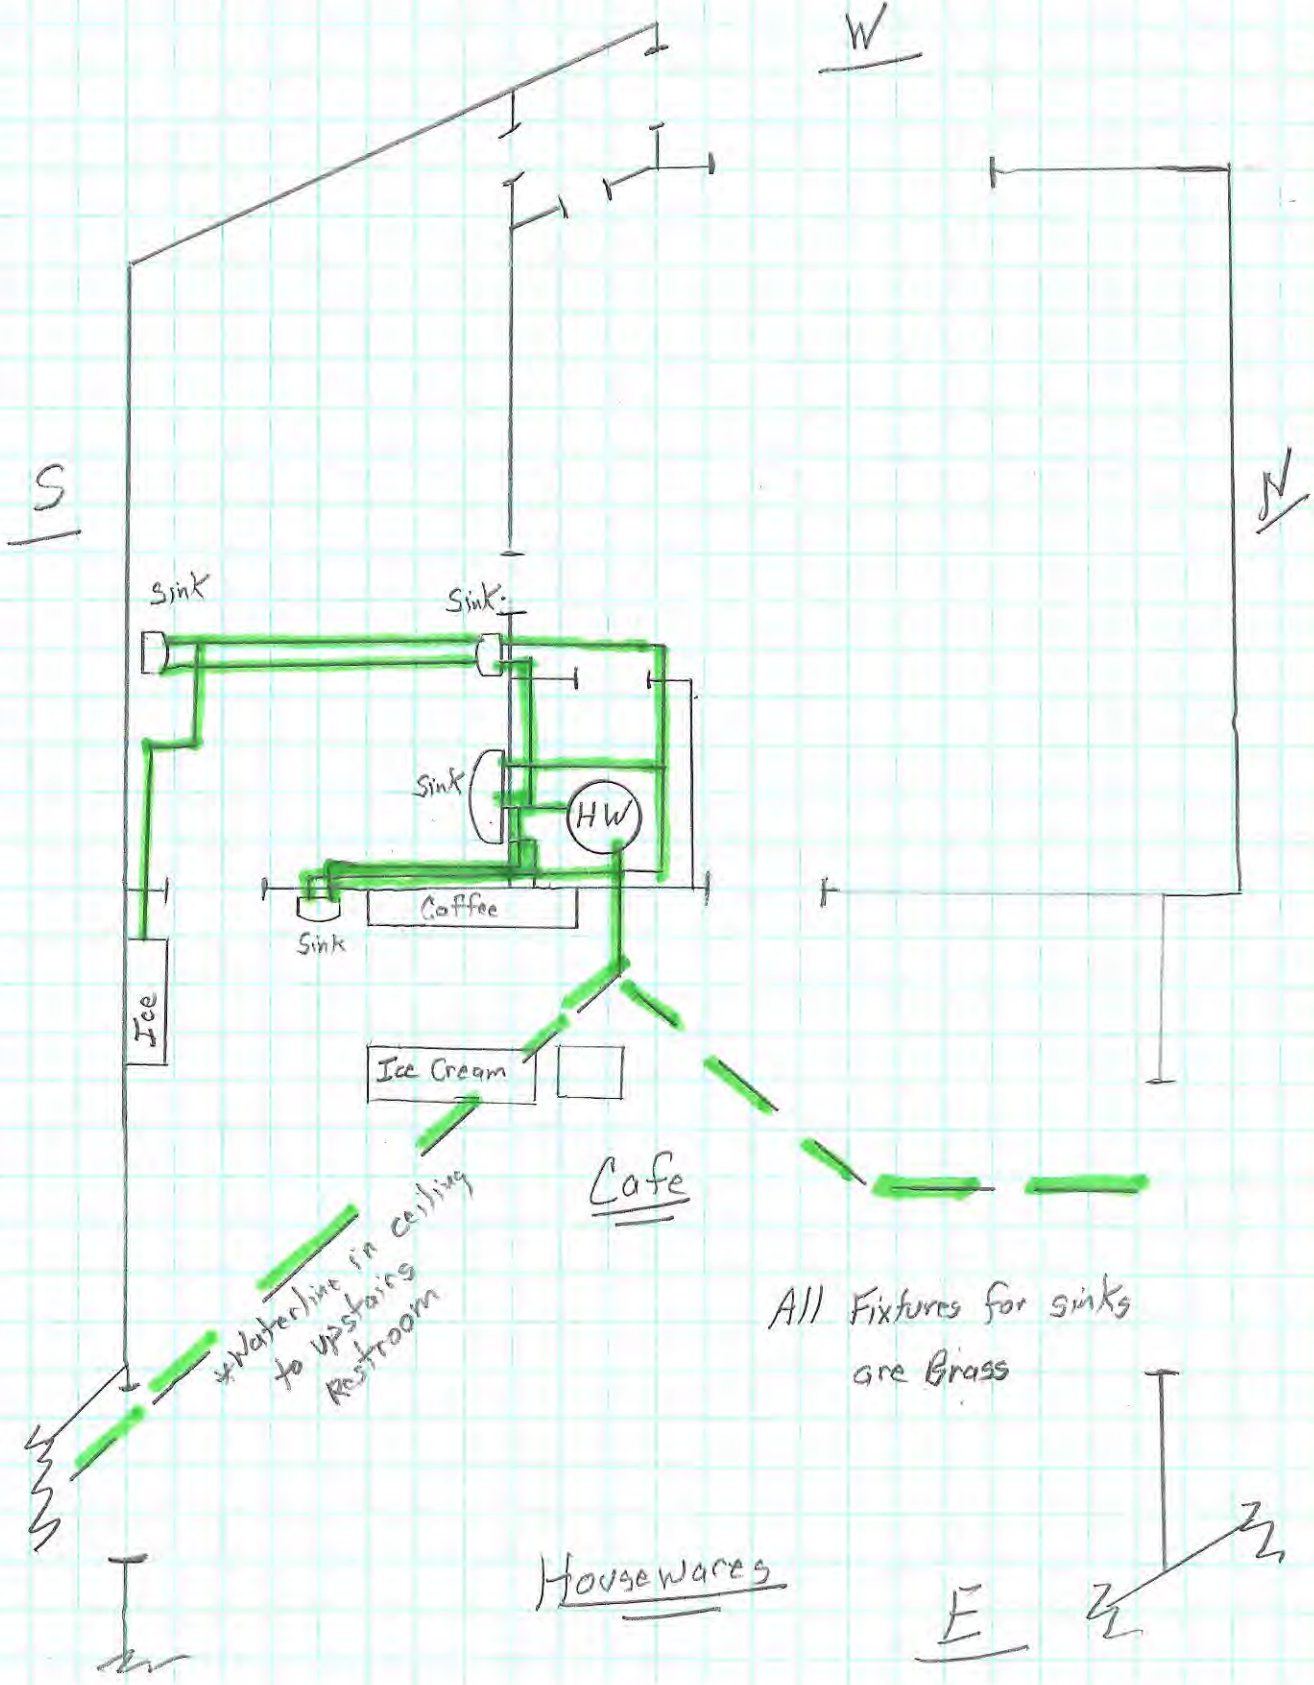

S

W

N

Sink

Sink

Sink

HW

Coffee

Sink

Ice

Ice Cream

Cafe

*Waterline in ceiling to upstairs Restroom

All Fixtures for sinks are Brass

Housewares


E



(D)

W

Upstairs Restroom

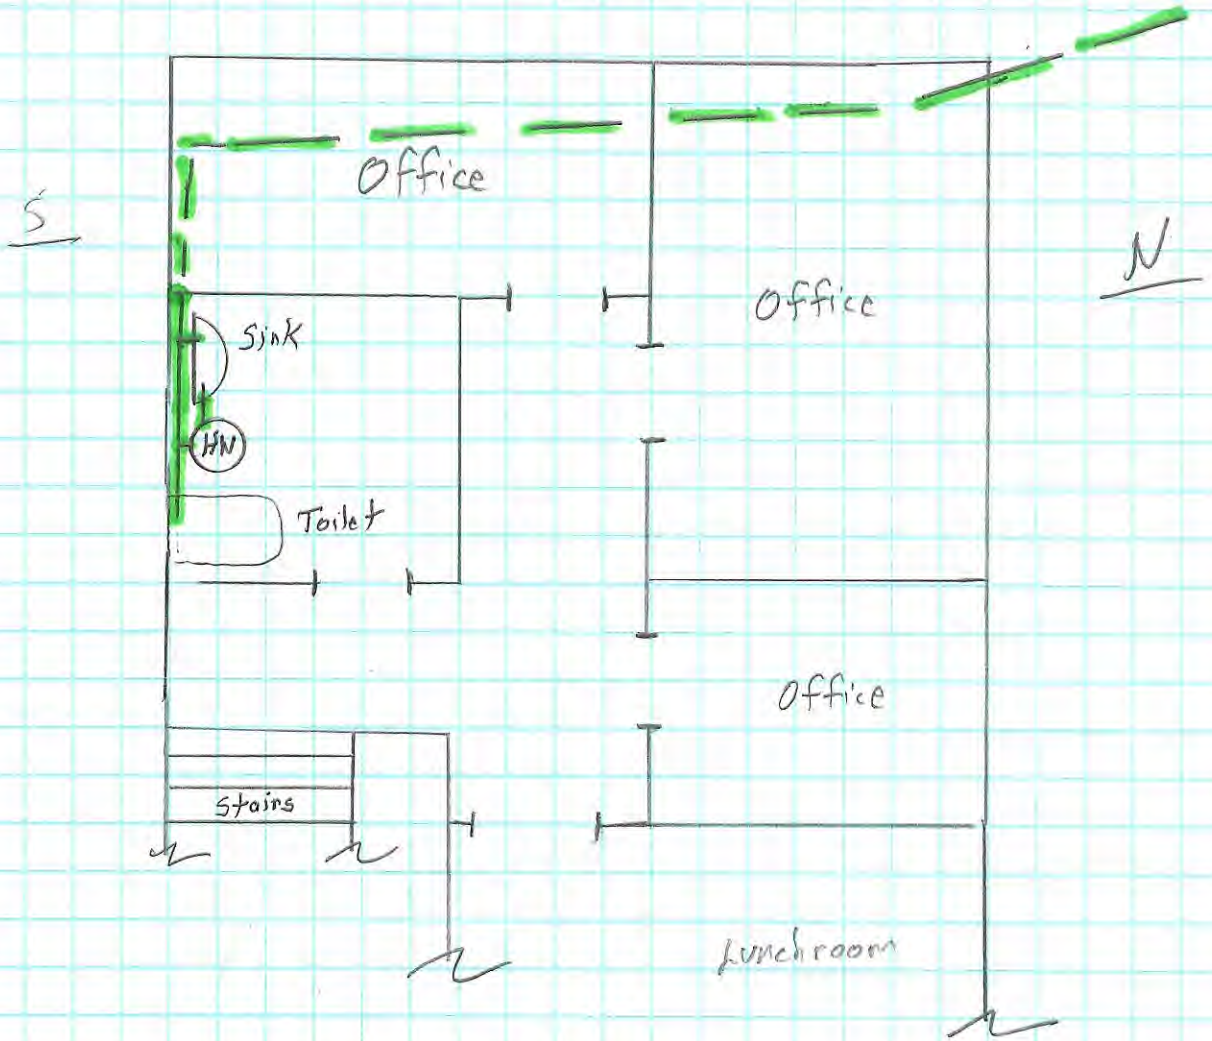

*Sink fixture

is brass

E