

Hab / School / Front Office

Built 1975

OH 3833312


North

Holmes County Training Center

8001 Twp 574

Holmesville, Ohio 44633

330-694-8045

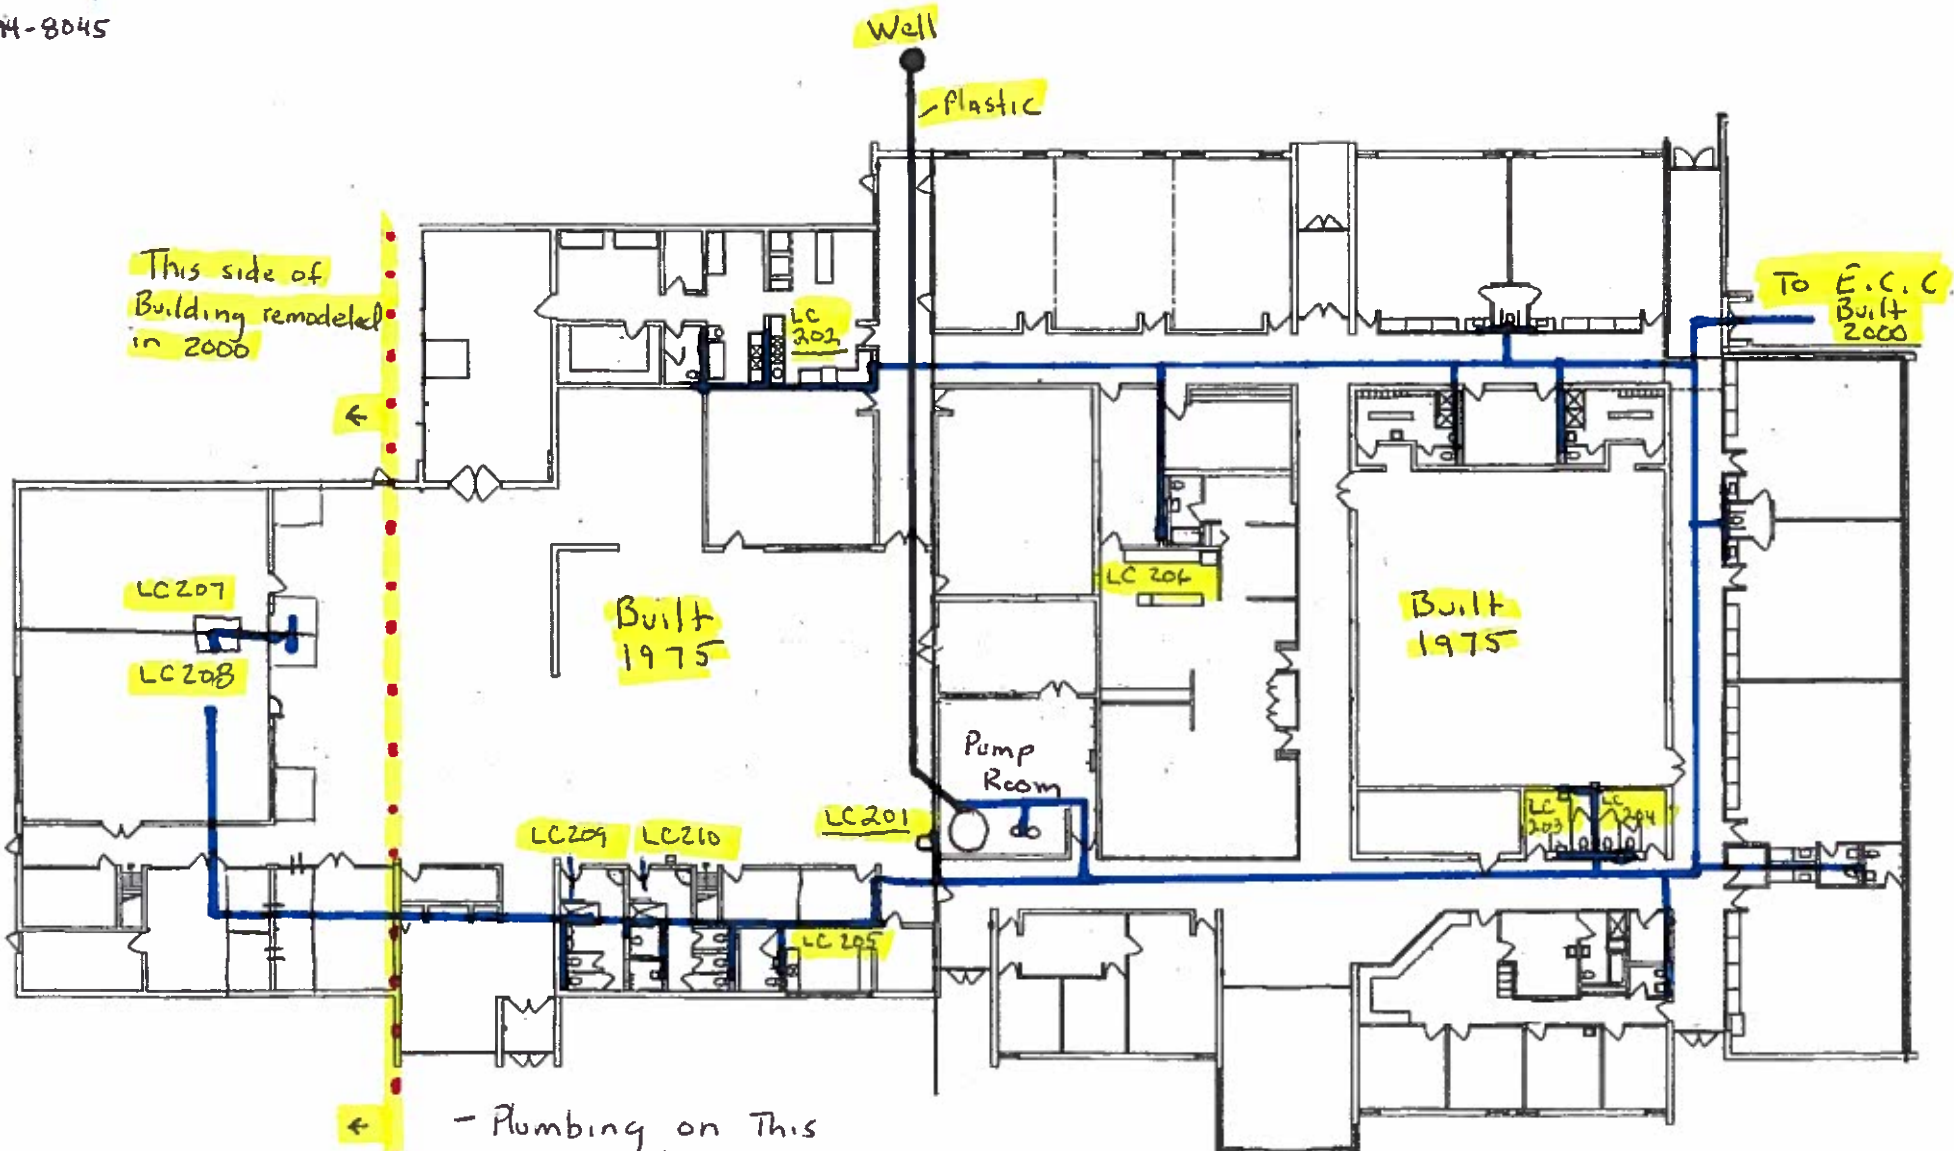

- Plumbing on This Side was installed in 1975
- All Plumbing is copper
- Fixtures unknown

E.C.C. Built 2000


OH 3833312

8001 TWP 574

Holmesville, Ohio 44633

330-674-8045

North

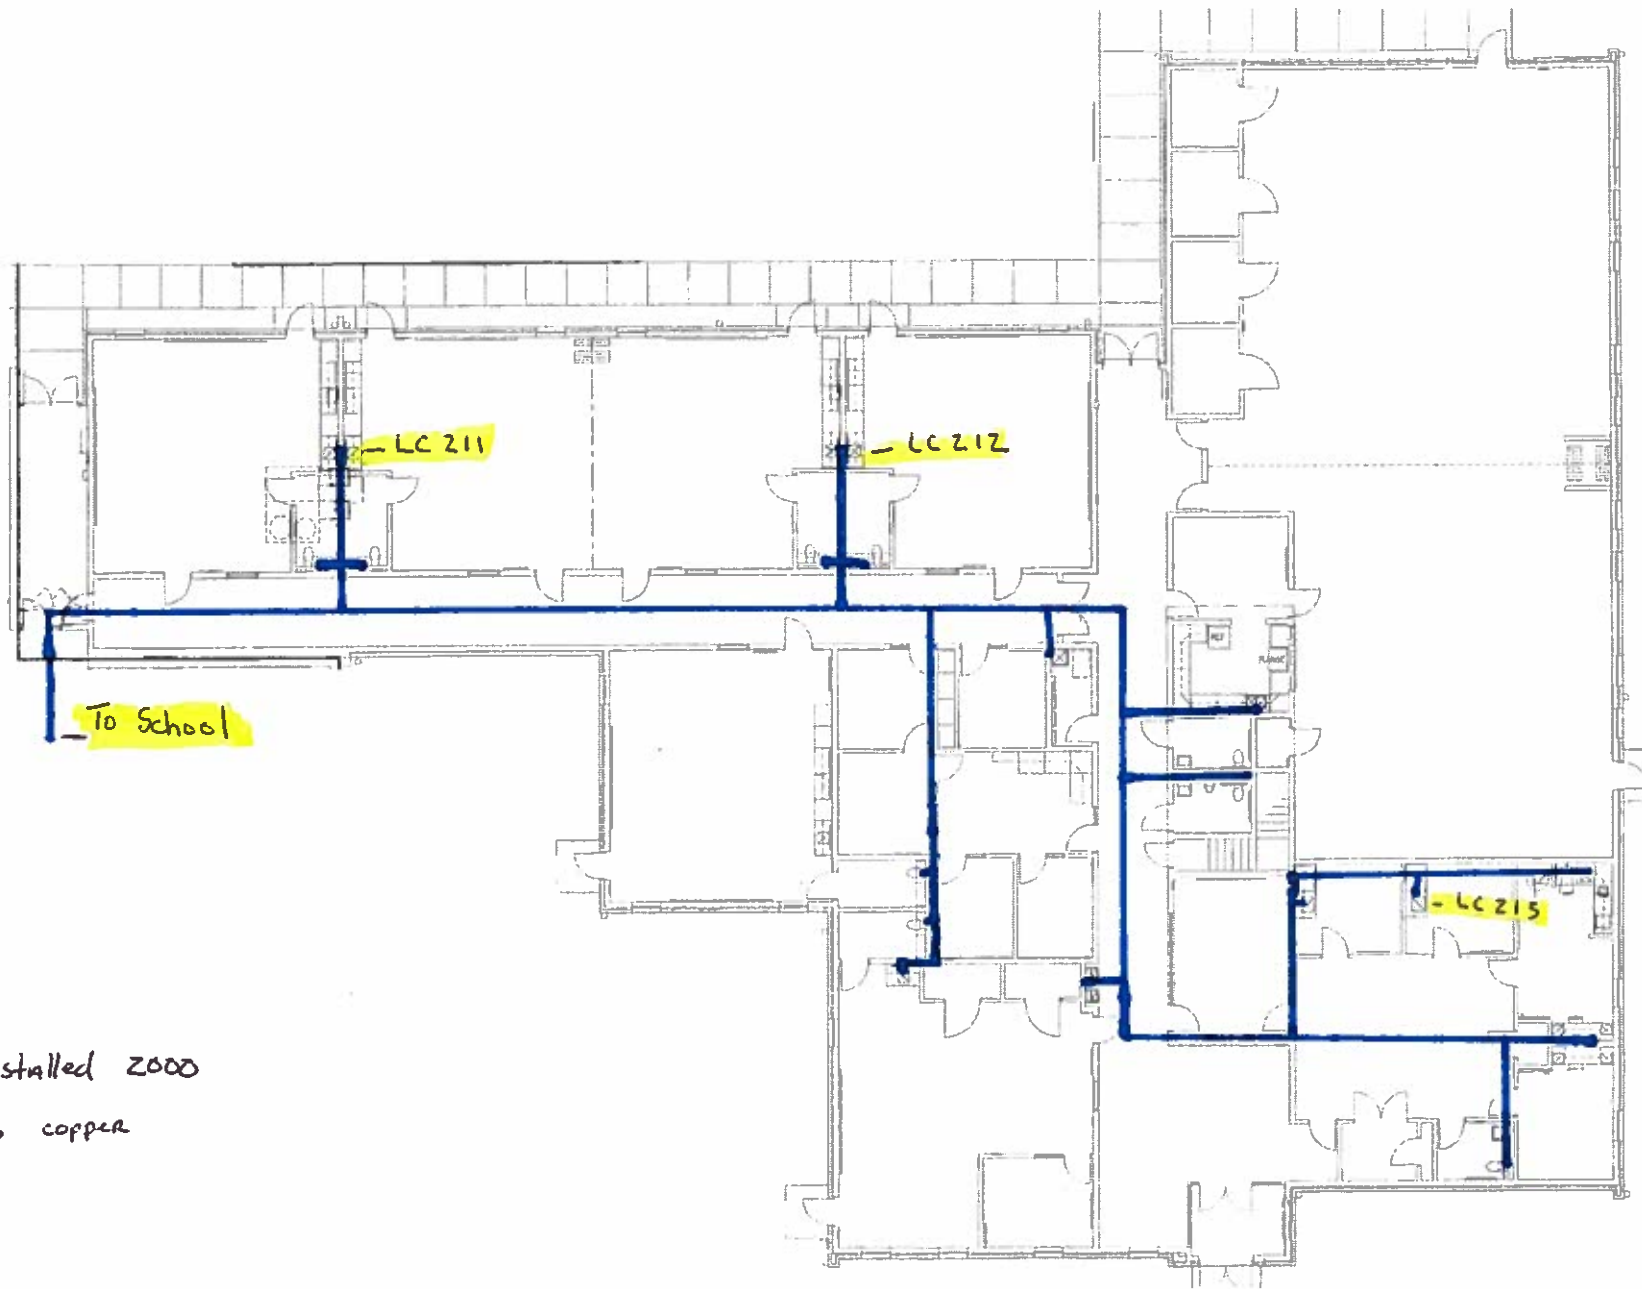

- ALL Plumbing installed 2000

- ALL Plumbing is copper