

LHI


Lynn Hope Ind.

OH3847712

8001 Twp 574
Holmesville, Ohio
44633
330-674-8045

Built 2000

North

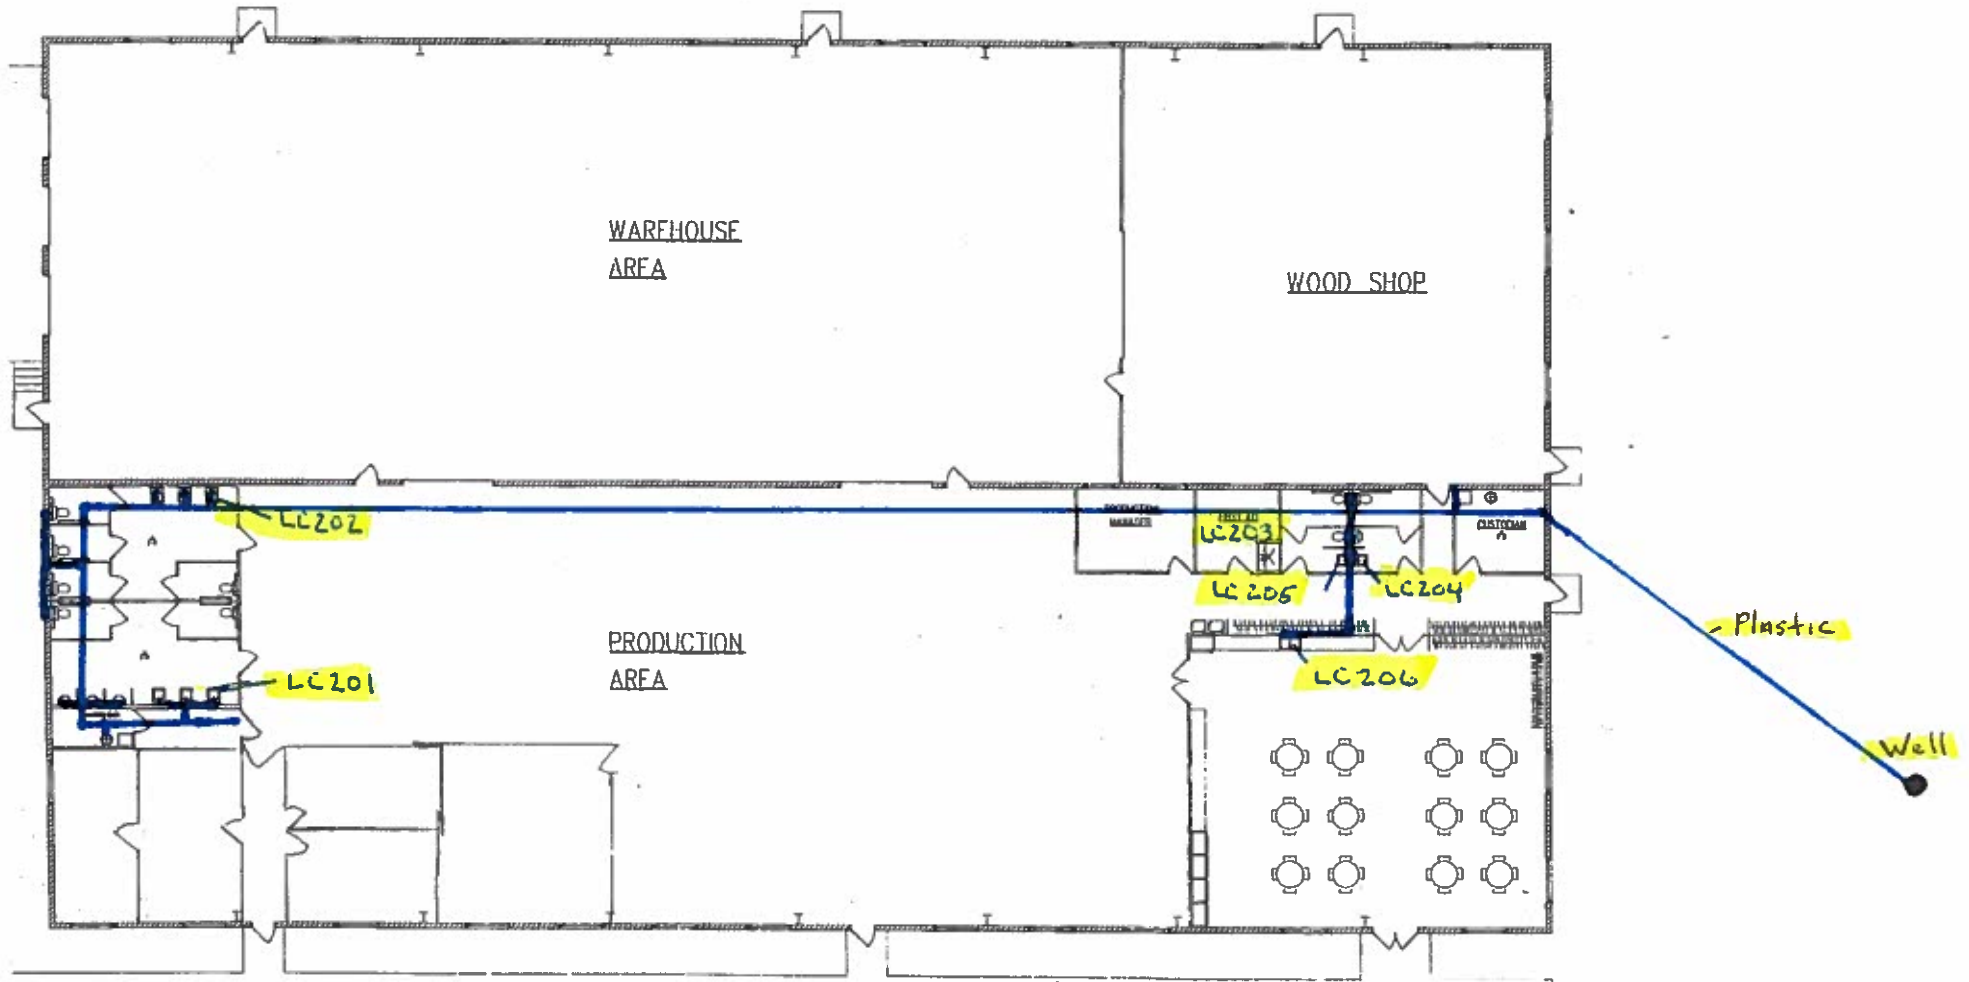

- Plastic Service line from well
- Plastic lines to each room underground.
- Copper lines to each fixture
- All Plumbing installed 2000
- All low lead fixtures