


\*Well

- Well to treatment all copper lines.

A = PRESS TAPLES  
B = IRON FILTER  
C = SOFTENER - DI  
D = UV MEER  
E = HOT WATER TANK  
F = BRINE TANK

West

Page 1

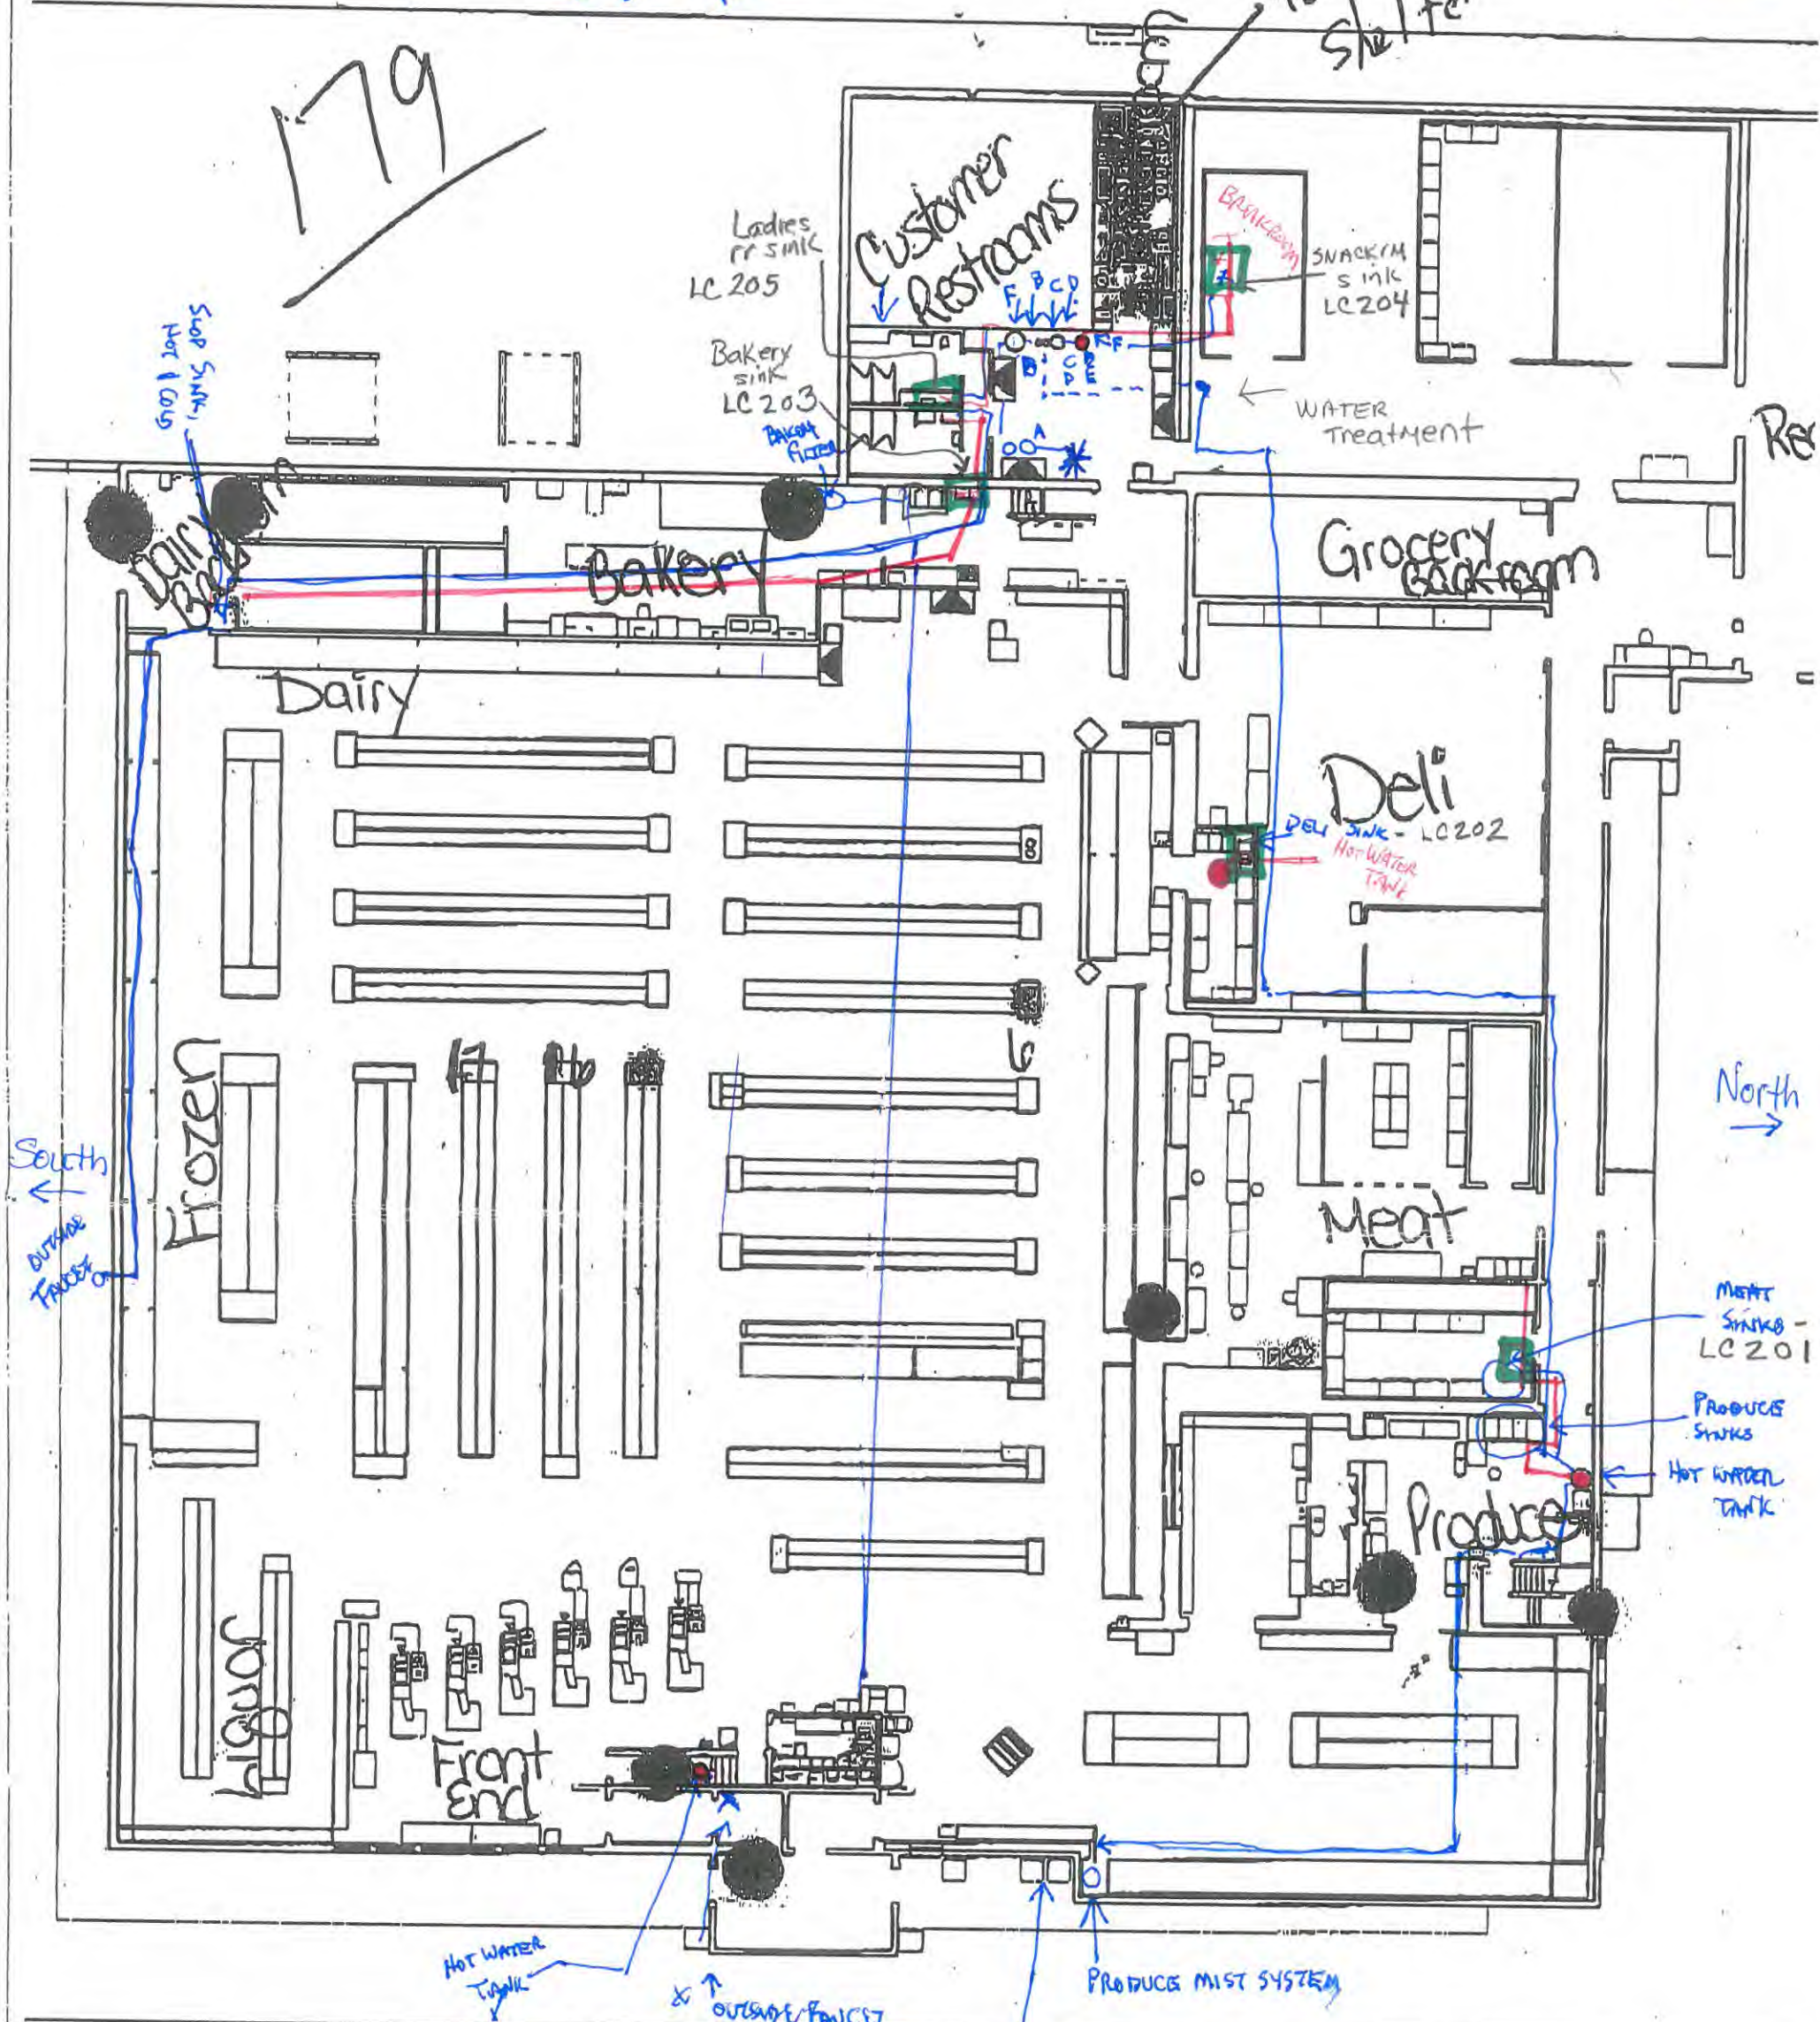

Broadview Rd.

To the best of our knowledge all lines in the building that are copper were installed prior to 1986 and faucet fixtures are prior to 1999. The building was built prior to 1982.

Fire Extinguisher  
Emergency Ex  
Tornado Shelter  
Wet Floor Cone


Giant Eagle #0179 Richfield  
4428 Broadview Road  
West Richfield, OH 44286  
(330) 659-6134  
PWS ID: OH 7759212

- X - Sinks that are tested
- Hot H<sub>2</sub>O Tank
- Hot water line
- cold water line

East



002

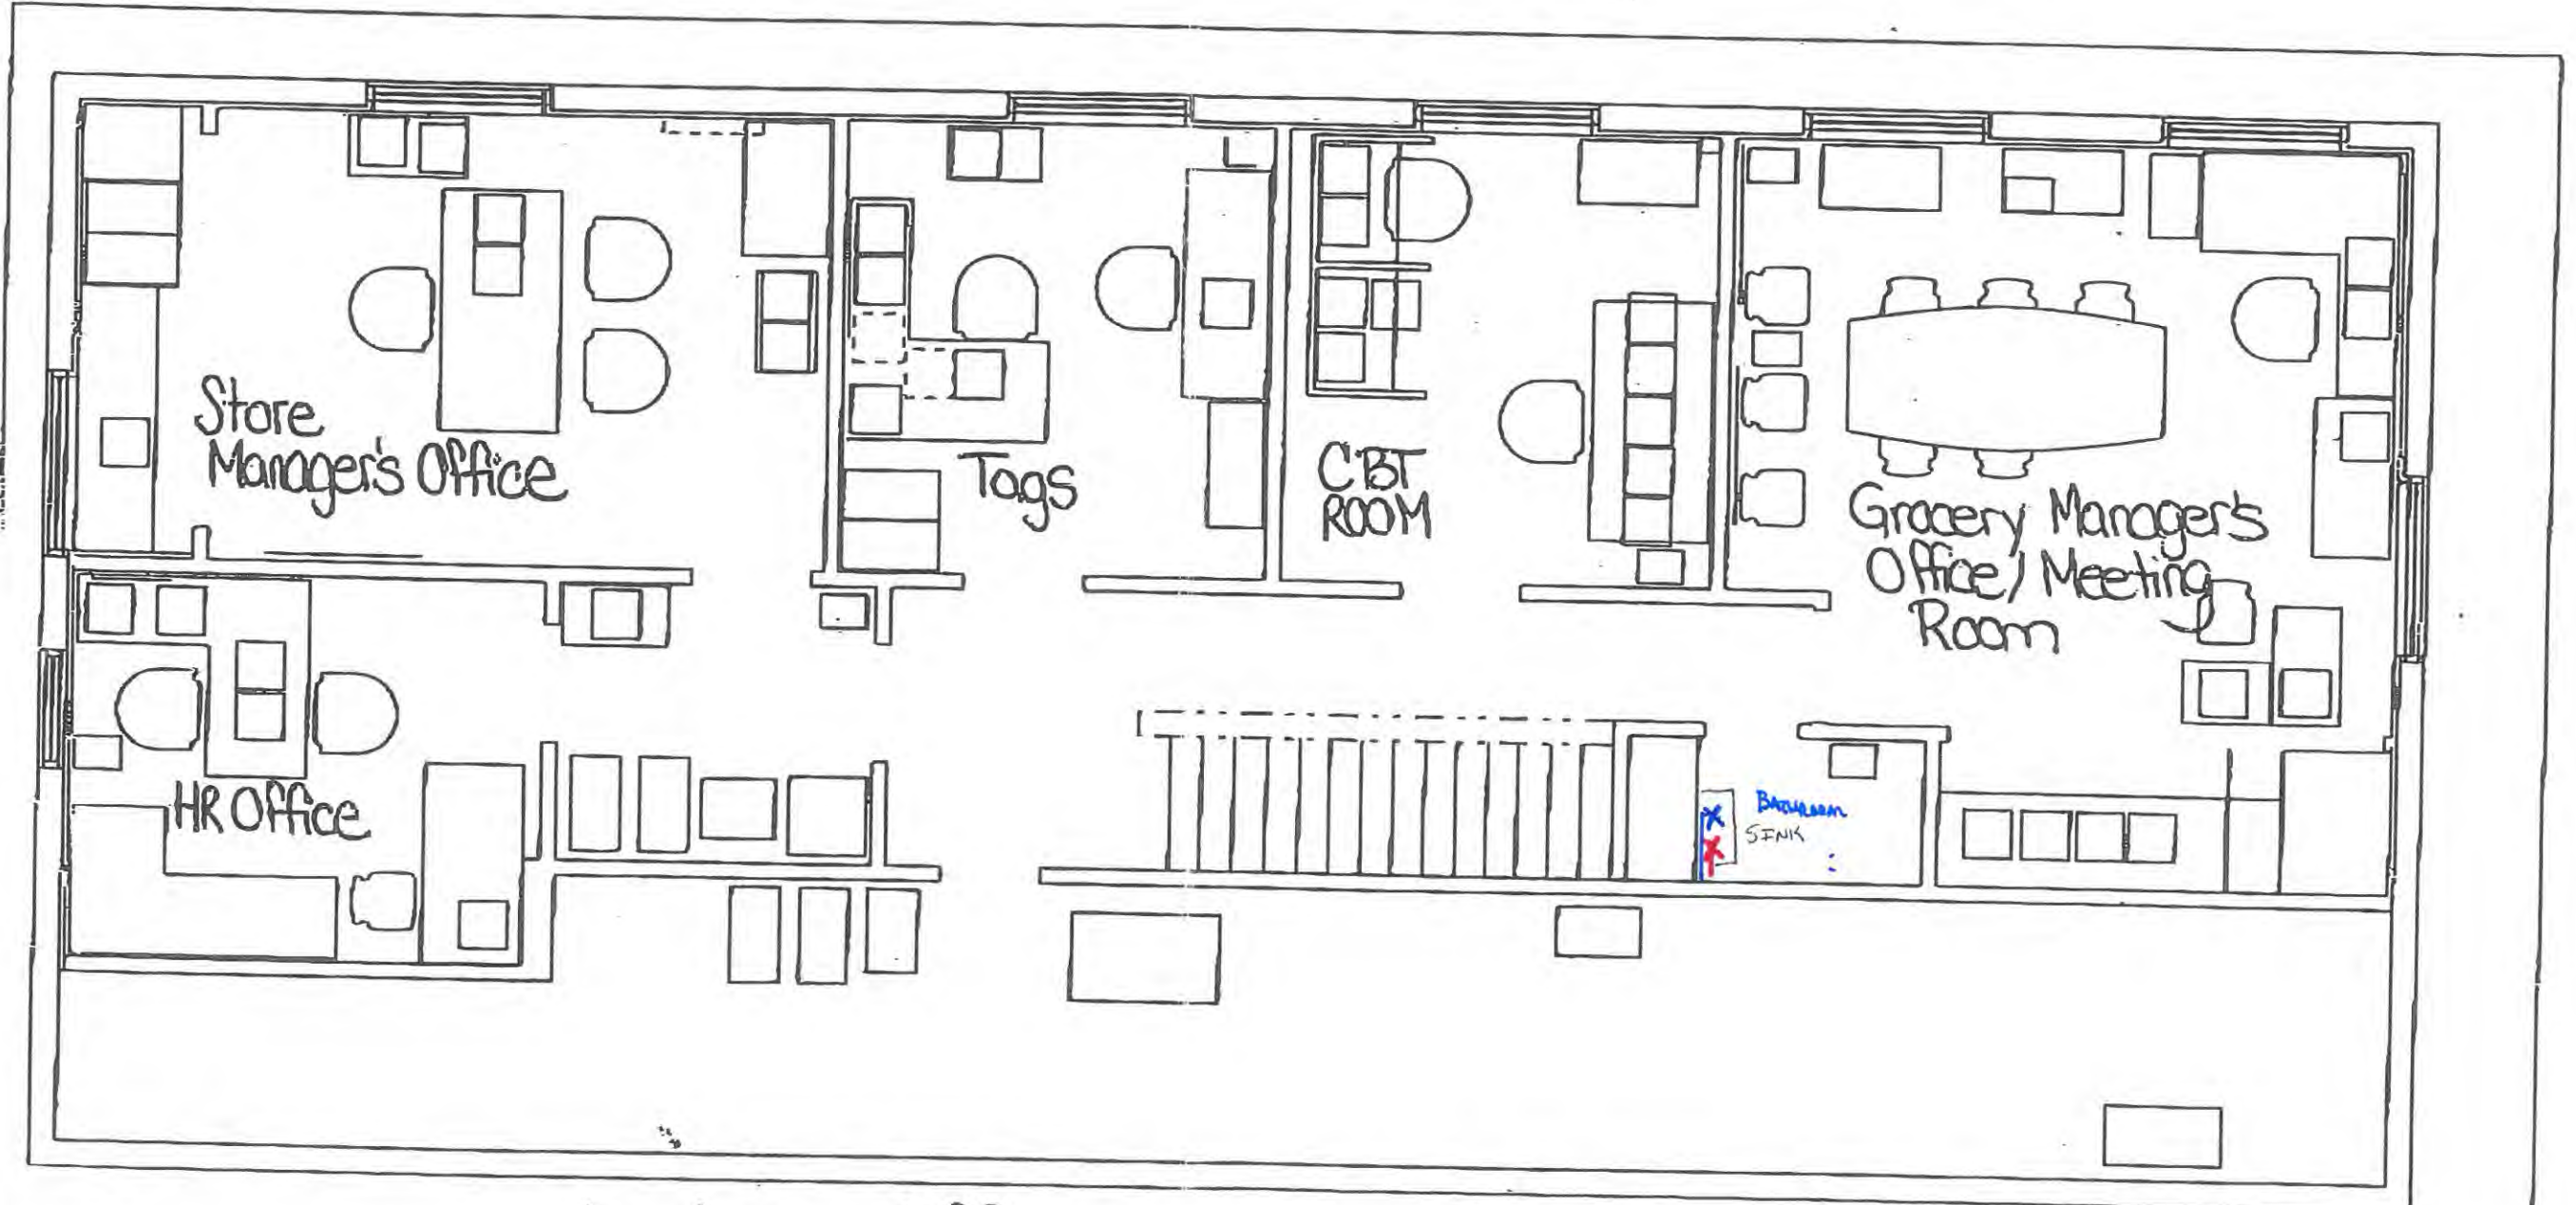

Upstairs Offices


Grant Eagle 0179  
 4428 Broadview Rd  
 Richfield, OH 44286  
 PWS ID: OH 7759212

All water lines are copper or plastic

- 1978-1980 add
- Fire Extinguisher Location
  - Emergency Exit
  - Tornado Shelter Area
  - Wet Floor Cones

EAST

03/03/2017 10:24 FAX ..

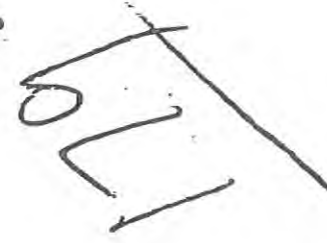


SOUTH

NORTH

South  
2nd Floor - Area over Produce and Meat

Giant Eagle #0179  
Richfield  
4428 Broadview Road  
West Richfield OH 44286  
(330) 659-6134  
PWS ID: OH 7759212

EAST

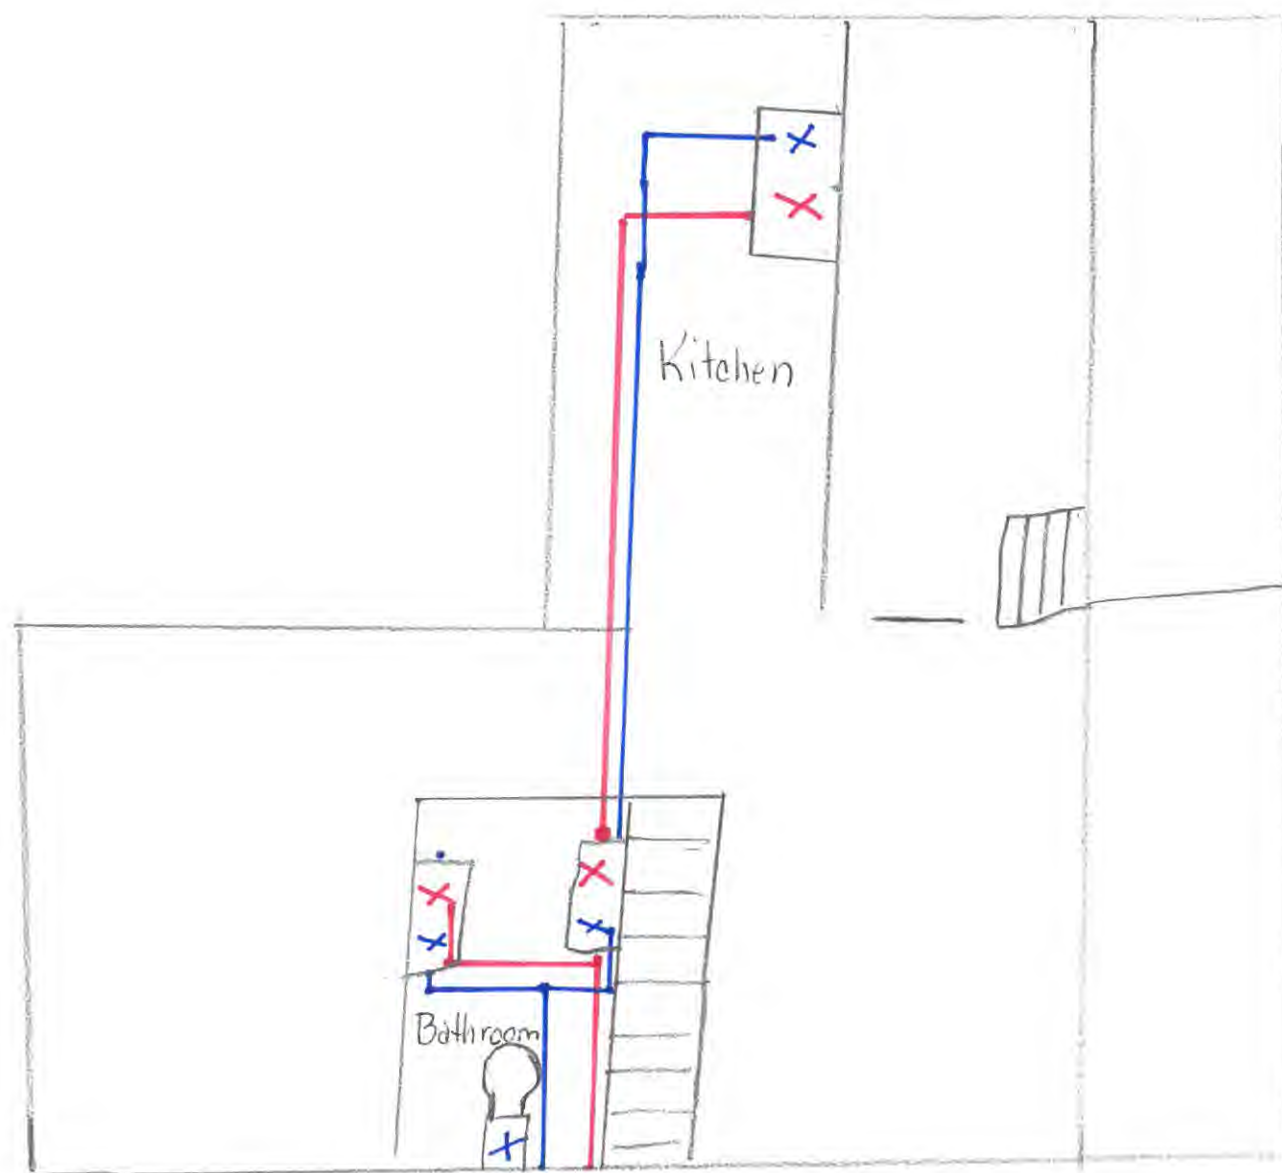

WEST

NORTH