

Central Christian School PWS ID 8533412
3970 Kidron Road Kidron, OHIO 44636
Phone 330-857-7311

Lead Mapping

The School's water system plumbing has no known lead pipes installed. No records have been found that show the use of lead piping. Looking at the building's water lines has not found any lead piping.

School maintenance supervisor Russell Miller has not seen any lead pipes, nor has the School's business manager Joel Otto.

The pipe from the well to the building is plastic. The pipes from the main building to both the Gerber building (Bldg. A) and the Soccer field Concession stand (Bldg. B) are also plastic. The buildings are all plumbed with copper.

The mid section of the main building was built in 1960 and would have used lead solder. The north addition (built in 1994) and the south addition (built in 1997) may have used lead solder. The south west addition (built in 2003) would have likely used a lower lead content solder. The Gerber building (Bldg. A), built in 1978 would contain lead solder. The soccer field concession stand (Bldg. B), built in 2008 would have likely used a lower lead content solder. There are no known records that show the exact age or type of material used in the solder, the faucets or fountains.

We must assume that most of the plumbing and fixtures do not meet the current 0.25% lead standard.


I certify that this information is accurate to the best of my knowledge.

Mick Stebelton
Mick Stebelton
Operator of Record

P.O. Box 268
Fridenicksburg, OH 44627
Cell 330-464-9876
e mail mickstebelton@hotmail.com


RECEIVED
MAY 18 2011
OHIO EPA RPD

Entity: Central Christian Sch
Doc Type: Report
Doc Subtype:
Program: RPAEC
County: Wayne
Secondary ID: OH8533412

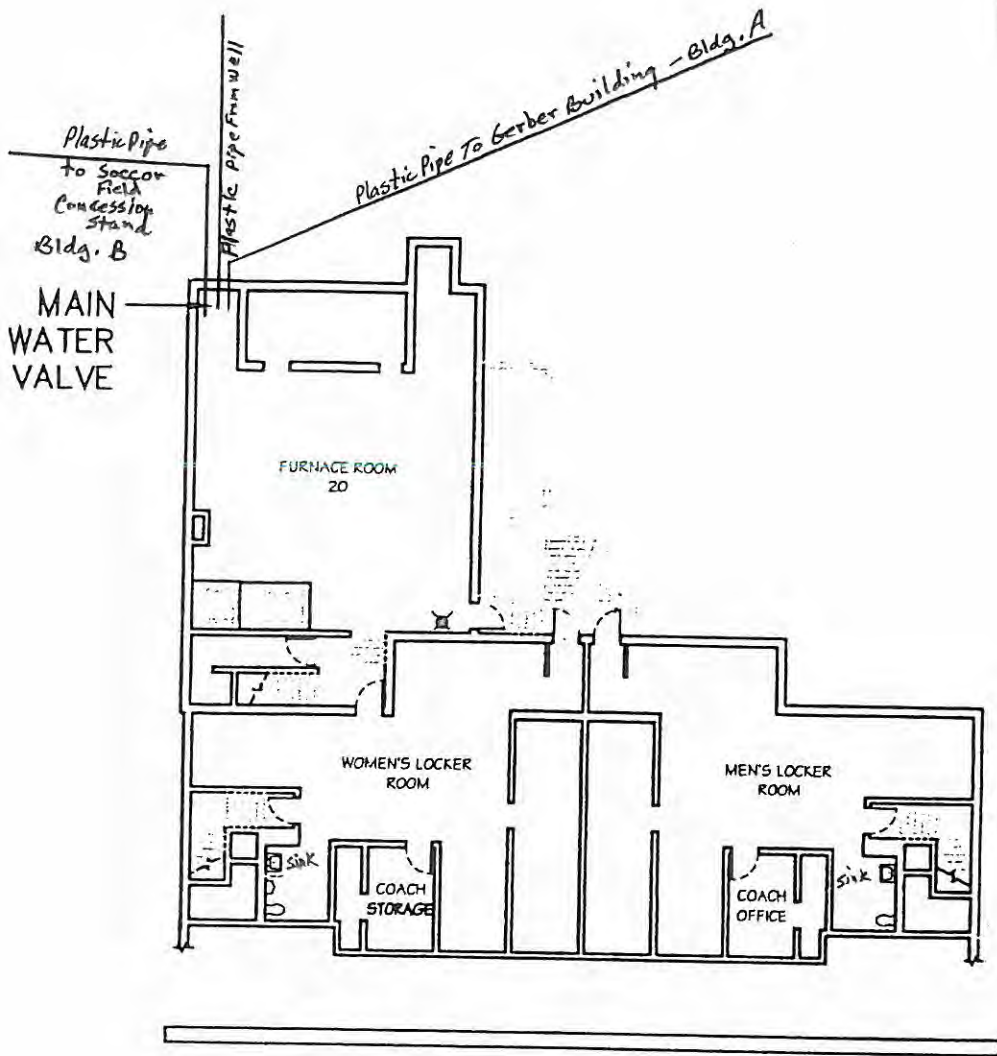

Basement #1

Built 1960

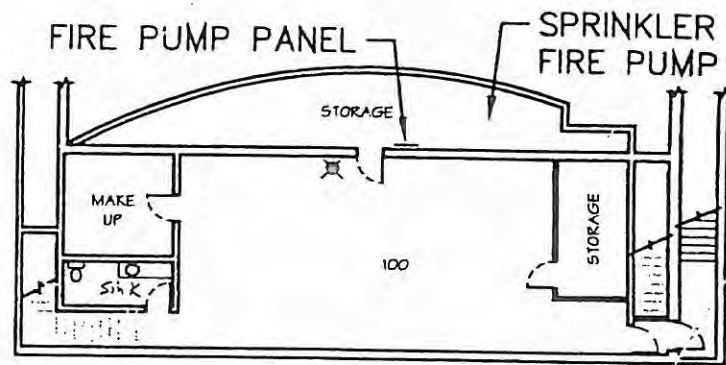

Basement #2

Built 2003

RECEIVED
 MAR 11 2011
 OHIO EPA NEDO

CENTRAL CHRISTIAN SCHOOL
 3970 KIDRON ROAD
 KIDRON, OHIO 44636
 PWS ID 8533412





CENTRAL CHRISTIAN SCHOOL

3970 KIDRON ROAD
KIDRON, OHIO 44636
PWS ID 8533 412

Gerber Bldg. Built 1978
(Bldg. A)

Soccer Field
Concession Stand
(Bldg. B) Built 2008

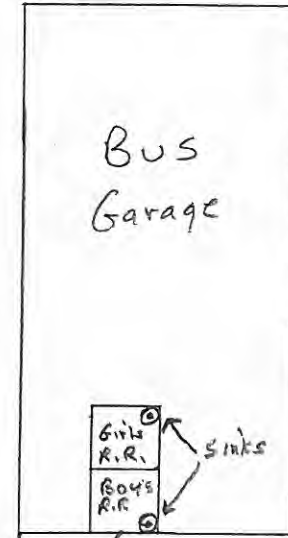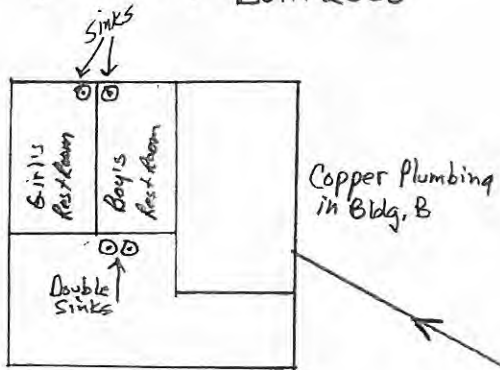

Well

Plastic Pipe From Well

Plastic Pipe to Bldg. B

Plastic Pipe to Bldg. A



RECEIVED

MAR 11 8 2017


OHIO EPA NEDO

300 HALL

Main School Bldg.

CENTRAL CHRISTIAN SCHOOL
3970 KIDRON ROAD
KIDRON, OHIO 44636
PWS ID 8533412

→ KIDRON ROAD →

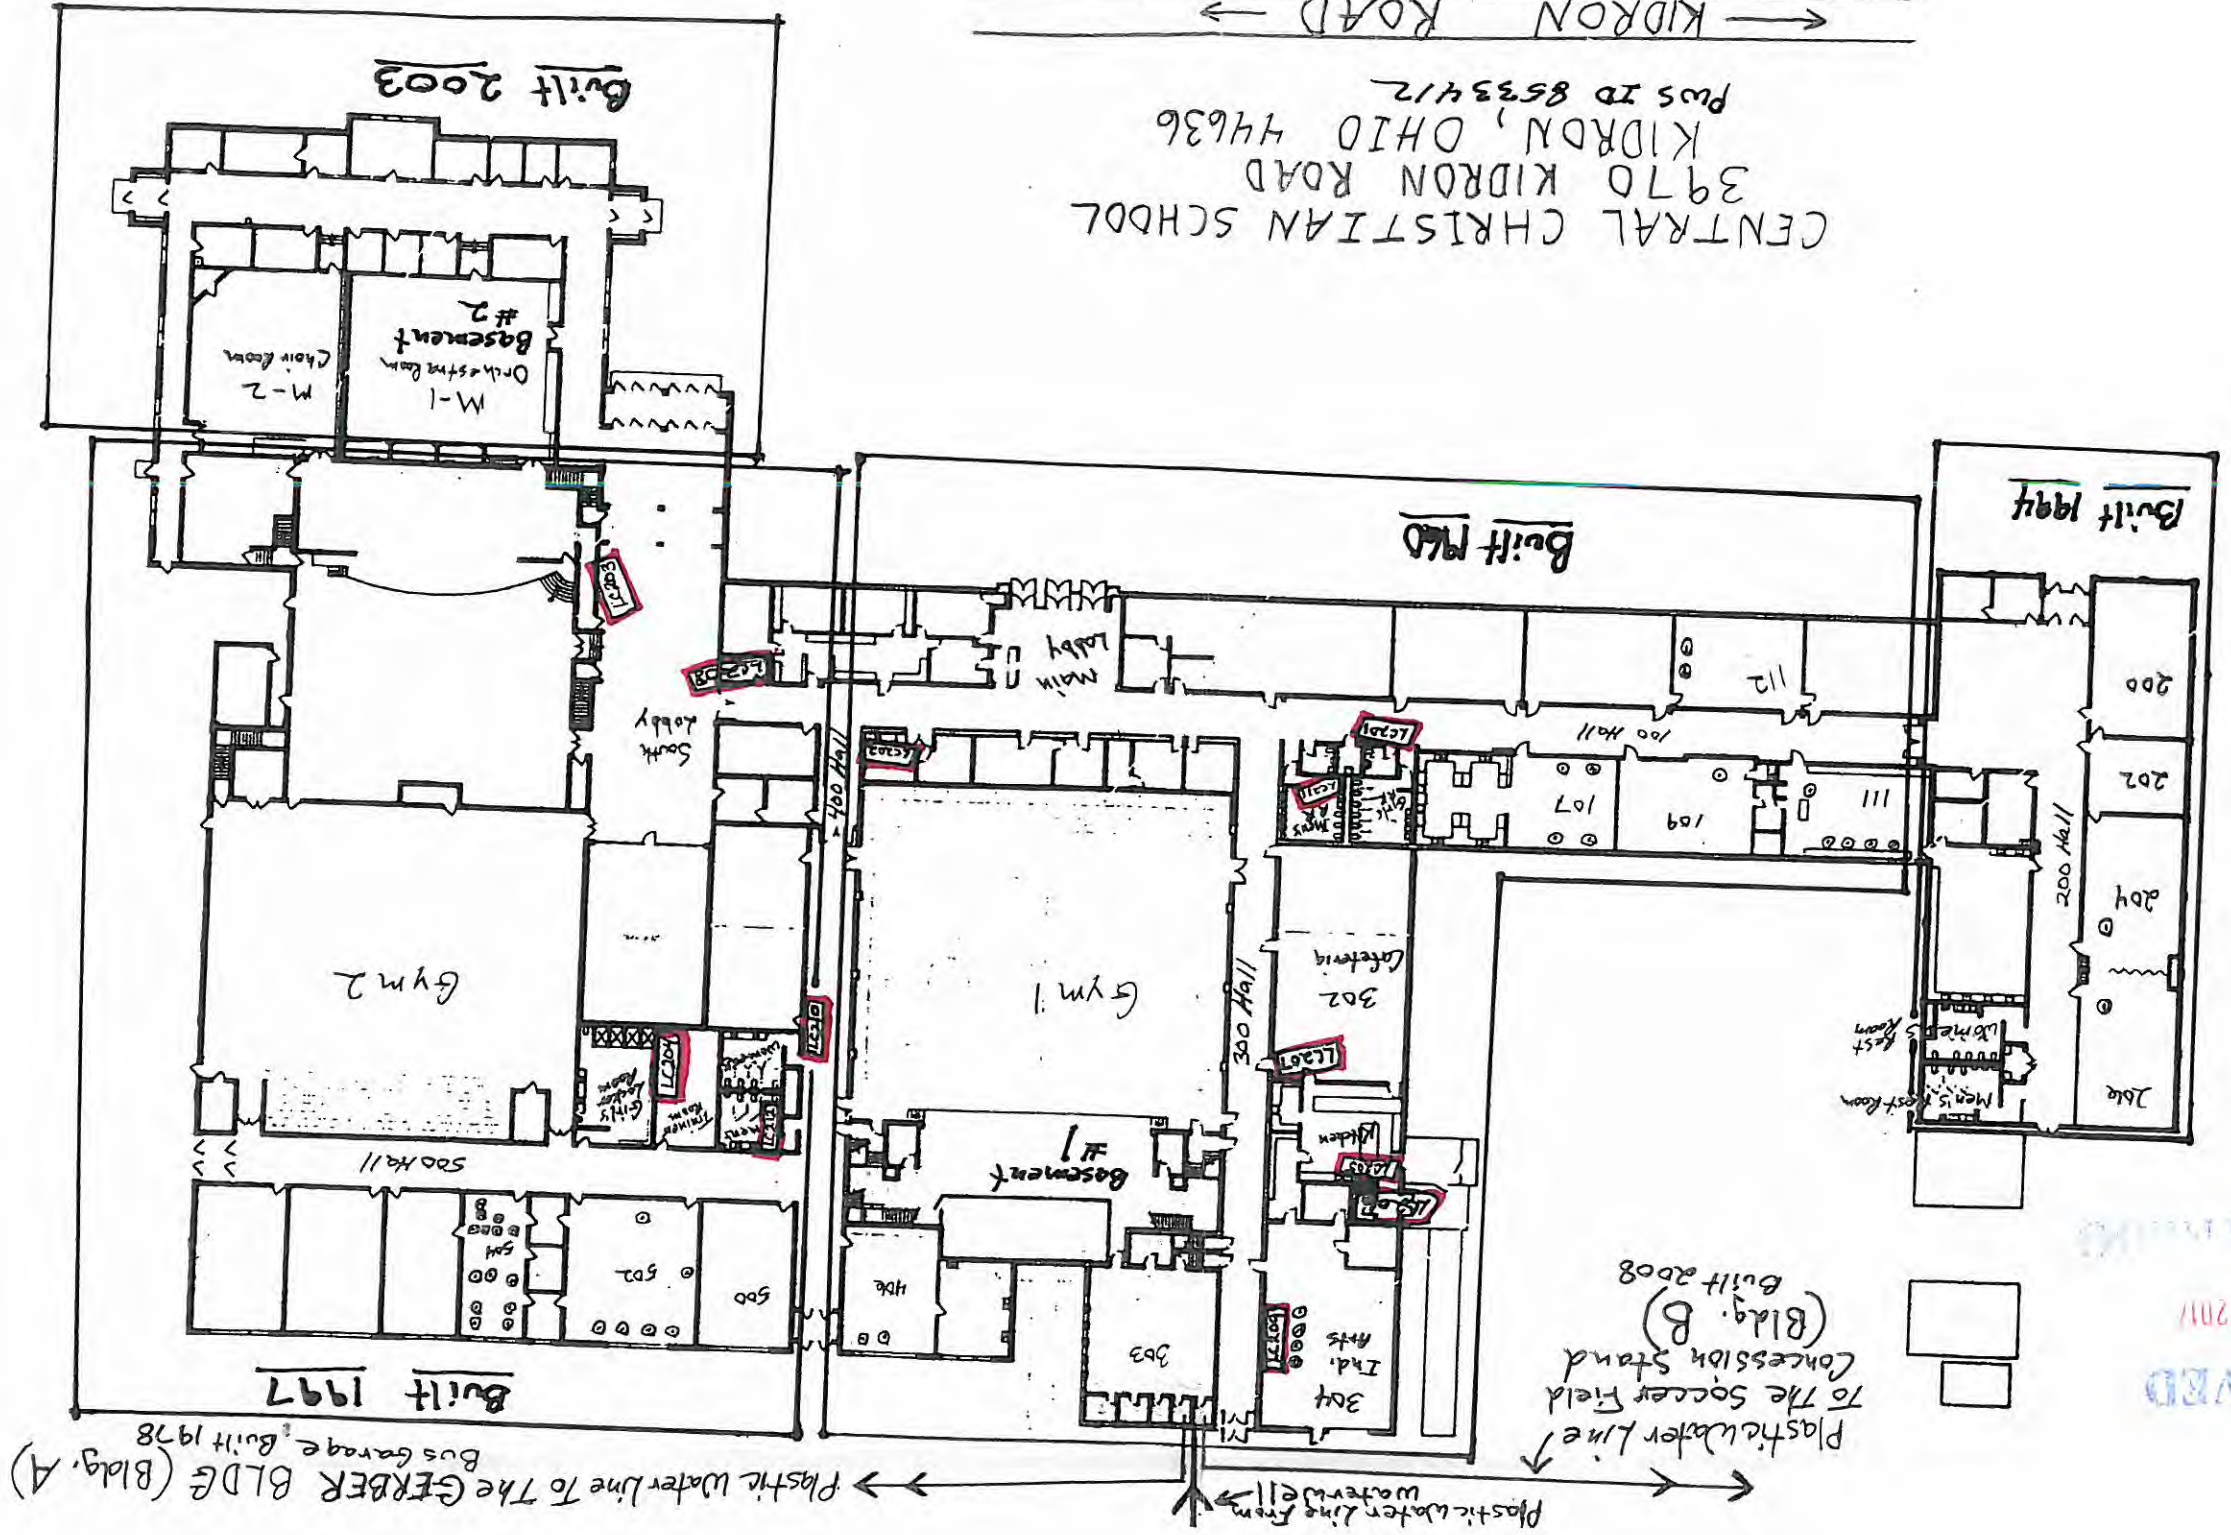

RECEIVED
FEB 2011
OHIO DEPARTMENT OF

→ Plastic Water Line to The GERBER BLDG (Bldg. A) Bus Garage Bldg 1978

→ Plastic Water Line from M