

LEAD MAPPING Program  
- LOUISVILLE M/H/P  
CANTON, OHIO 44705

RECEIVED

MAR 08 2017

OH7602512

OHIO EPA NEDO

I'VE OWNED THE PARK SINCE JAN. 1983.  
I NEVER HAD BLUE PRINTS AND LEARNED  
THE WATER SYSTEM THRU TRIAL AND ERROR.  
FROM REPAIRS, I'VE FOUND IN GROUND LINES  
ARE ALL GALVANIZED IN SIZES 2", 1 1/2", 1", 3/4" & 1/2"  
FIFTEEN HOMES SERVICE LINES HAVE BEEN  
REPLACED BY PLASTIC, ABANDONING THE  
GALVANIZED. ALL LEAD AND COPPER EPA TESTS HAVE  
RESULTED IN NEGLIGIBLE AMOUNTS IN THE WATER. IN  
34 YEARS I HAVE NOT FOUND ANY LEAD PIPES OR SOLDER


MAP INFORMATION

- 6 X INDICATES GALVANIZED SERVICE LINES.
- INDICATES PLASTIC SERVICE LINES.


2. Lots 5, 19, 53, 28, 33, 41, 51 contain mobile homes, but are abandoned, they are not hooked up to the service.
3. The apartment building has some GALVANIZED LINES IN THE BASEMENT. ALL 3 APARTMENTS HAVE BEEN CONVERTED TO PLASTIC.
4. A FEW mobile homes still have a combination of GALVANIZED & COPPER "FLARED", but the vast majority have been replumbed in plastic.

This is a true and honest report.

Entity: Louisville MHP Nick BROD, OWNER  
Doc Type: Report  
Doc Subtype: \_\_\_\_\_  
Program: DDAGW LOUISVILLE M/H/P  
County: Stark 4519 LOUISVILLE ST. N.E. 330-456-293  
Secondary ID: OH7602512 CANTON, OHIO 44705



LOUIS VALLE FENCE STREET

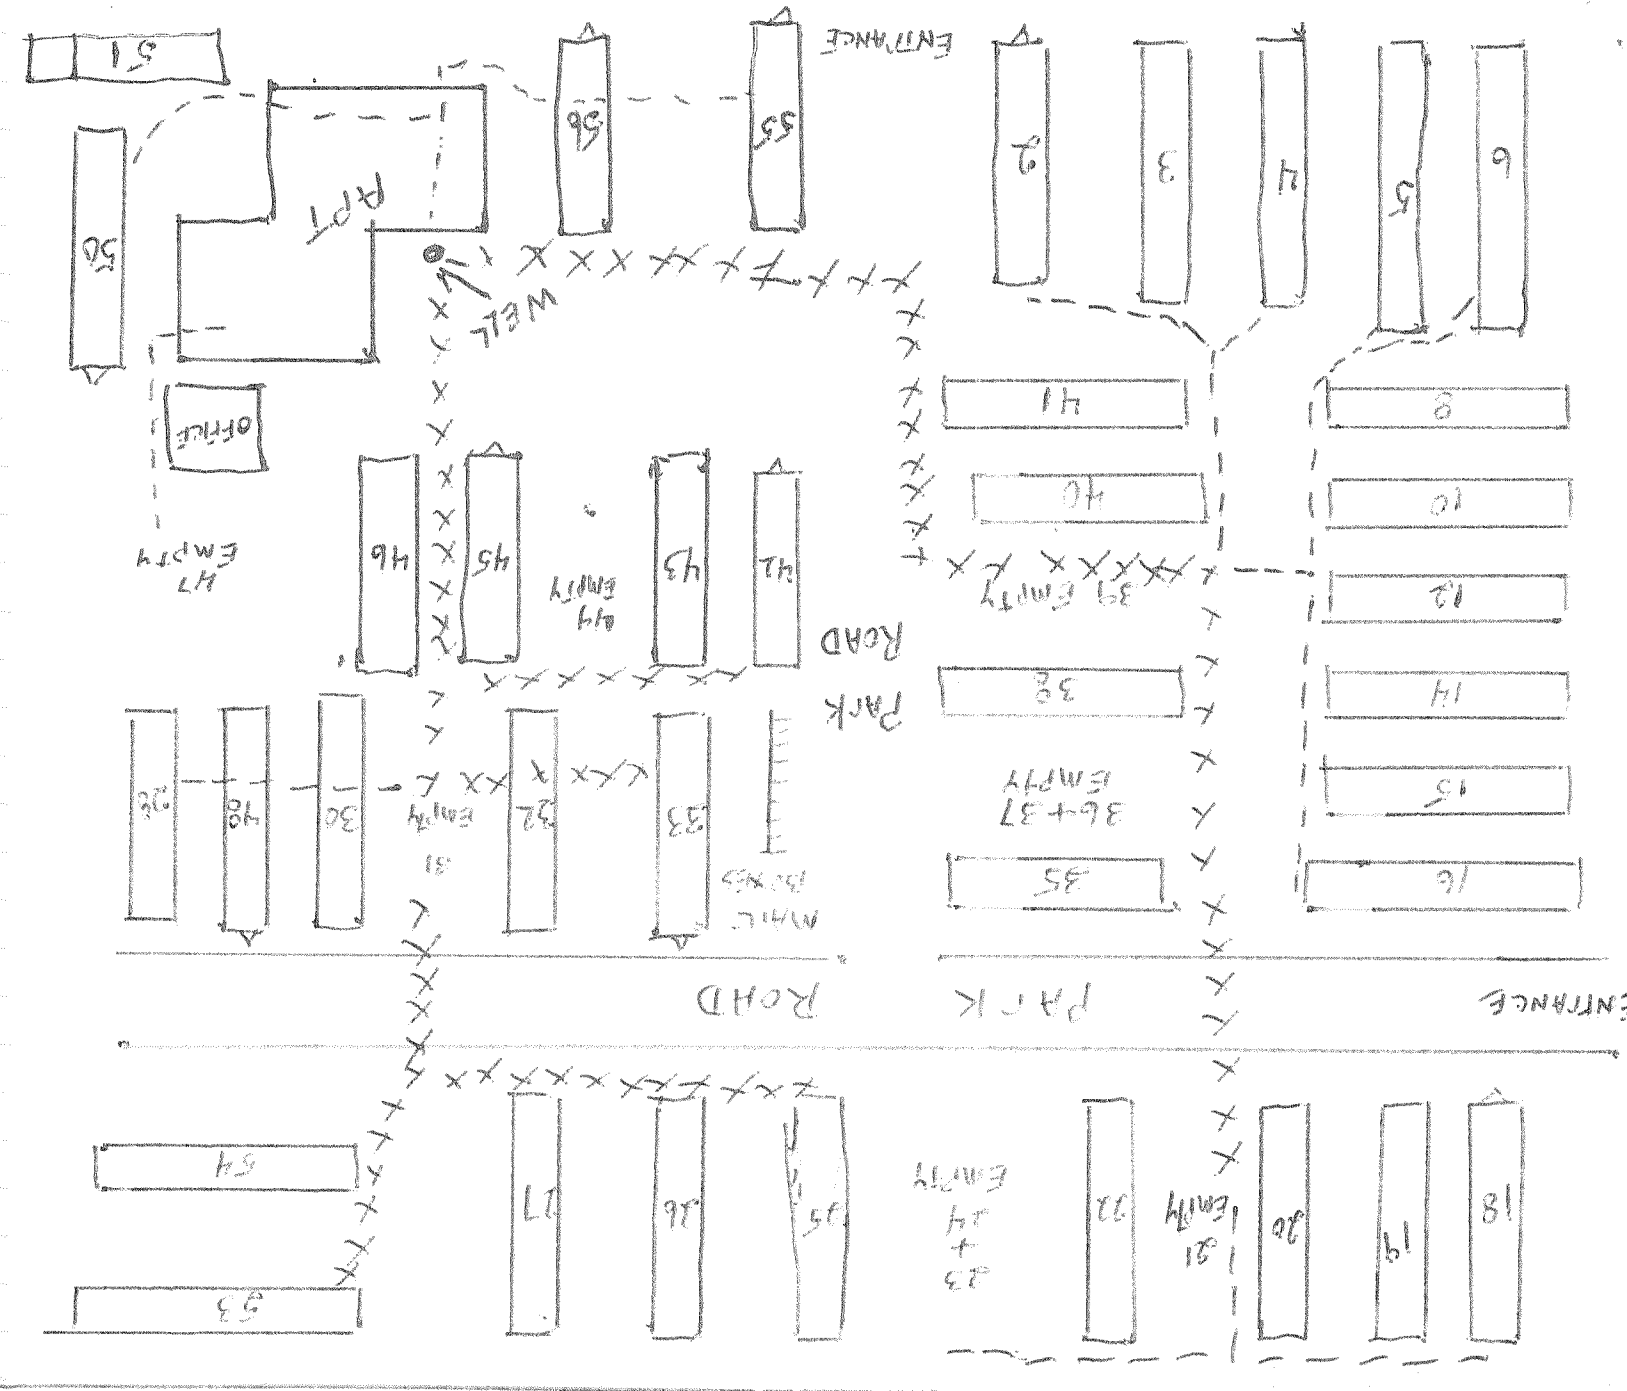

FENCE

PARK ROAD

MILLVALE ST.

PARK ROAD

CASTON, Ohio

LOUISVILLE M/H/P

FENCE

N