


NOTES:


- 1- 2" PVC WATER LINE FROM WELL HEAD TO BOILER ROOM.
- 2- 3/4" COPPER FROM BOILER ROOM TO EACH APARTMENT.
- 3- 3/4" COPPER ENTERS EACH APARTMENT IN THE KITCHEN.

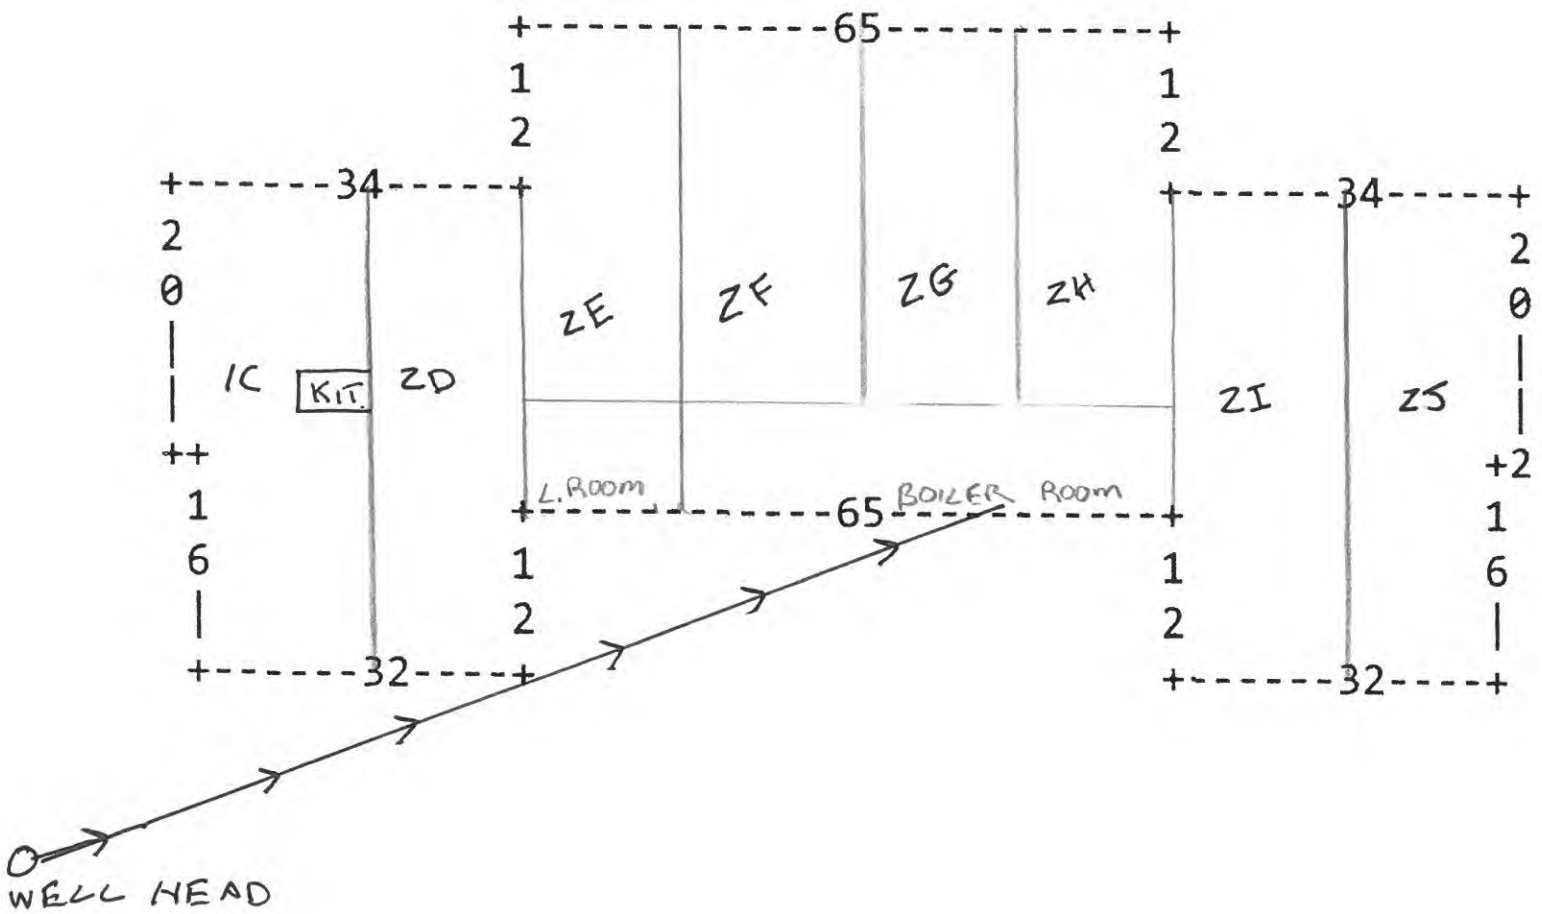

3-8-17


525 Meredith

1st Floor

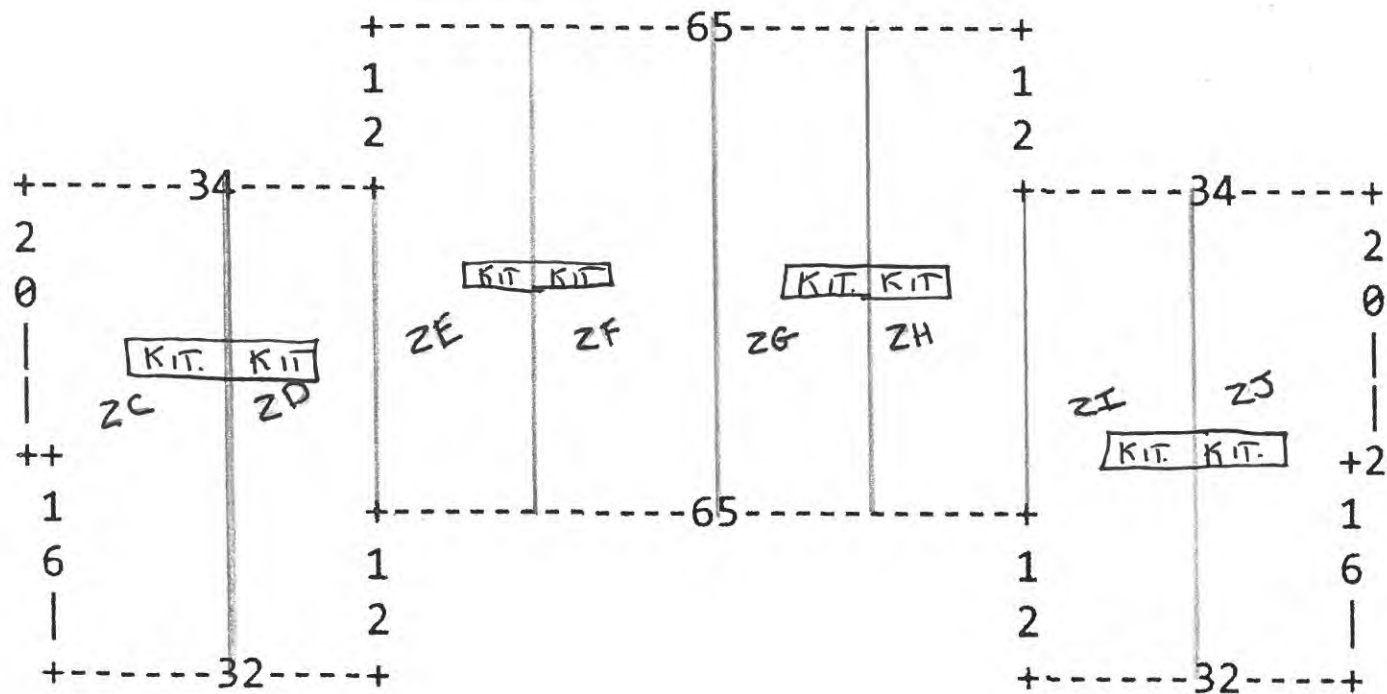


3-8-17

525 Meredith  
2<sup>nd</sup> Floor

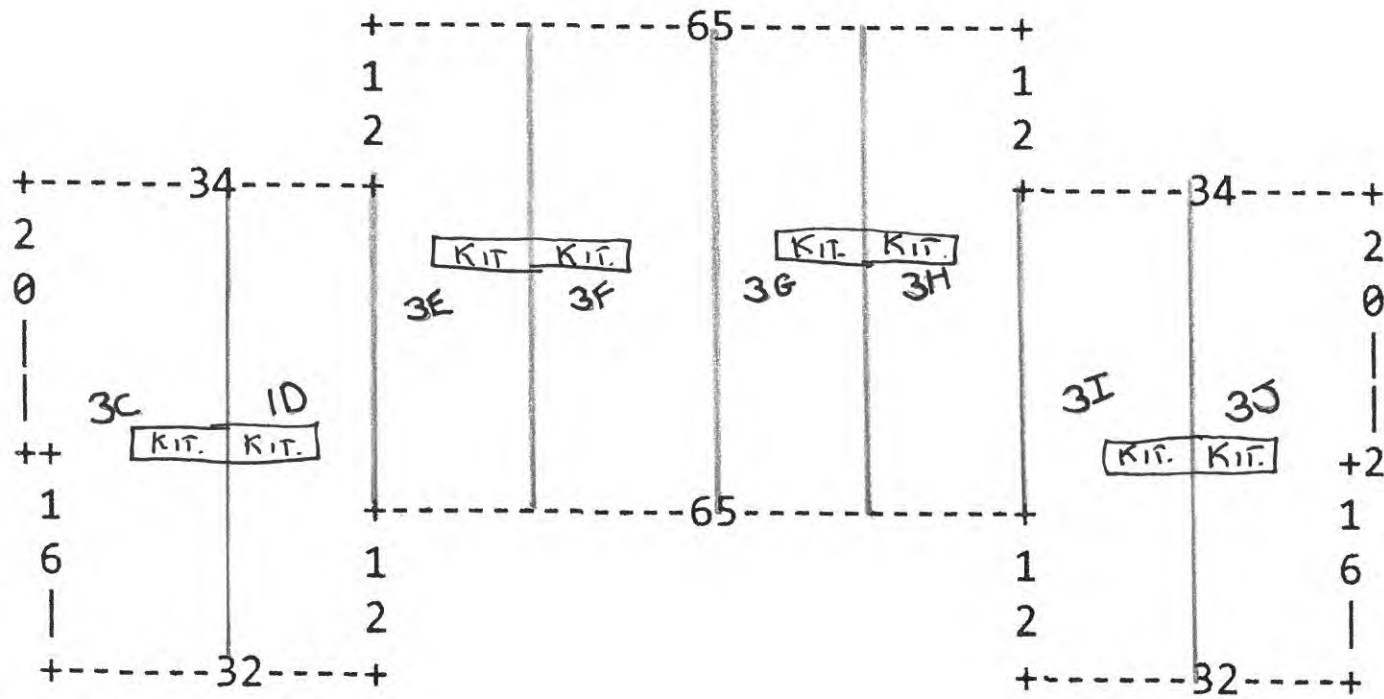

3-8-17

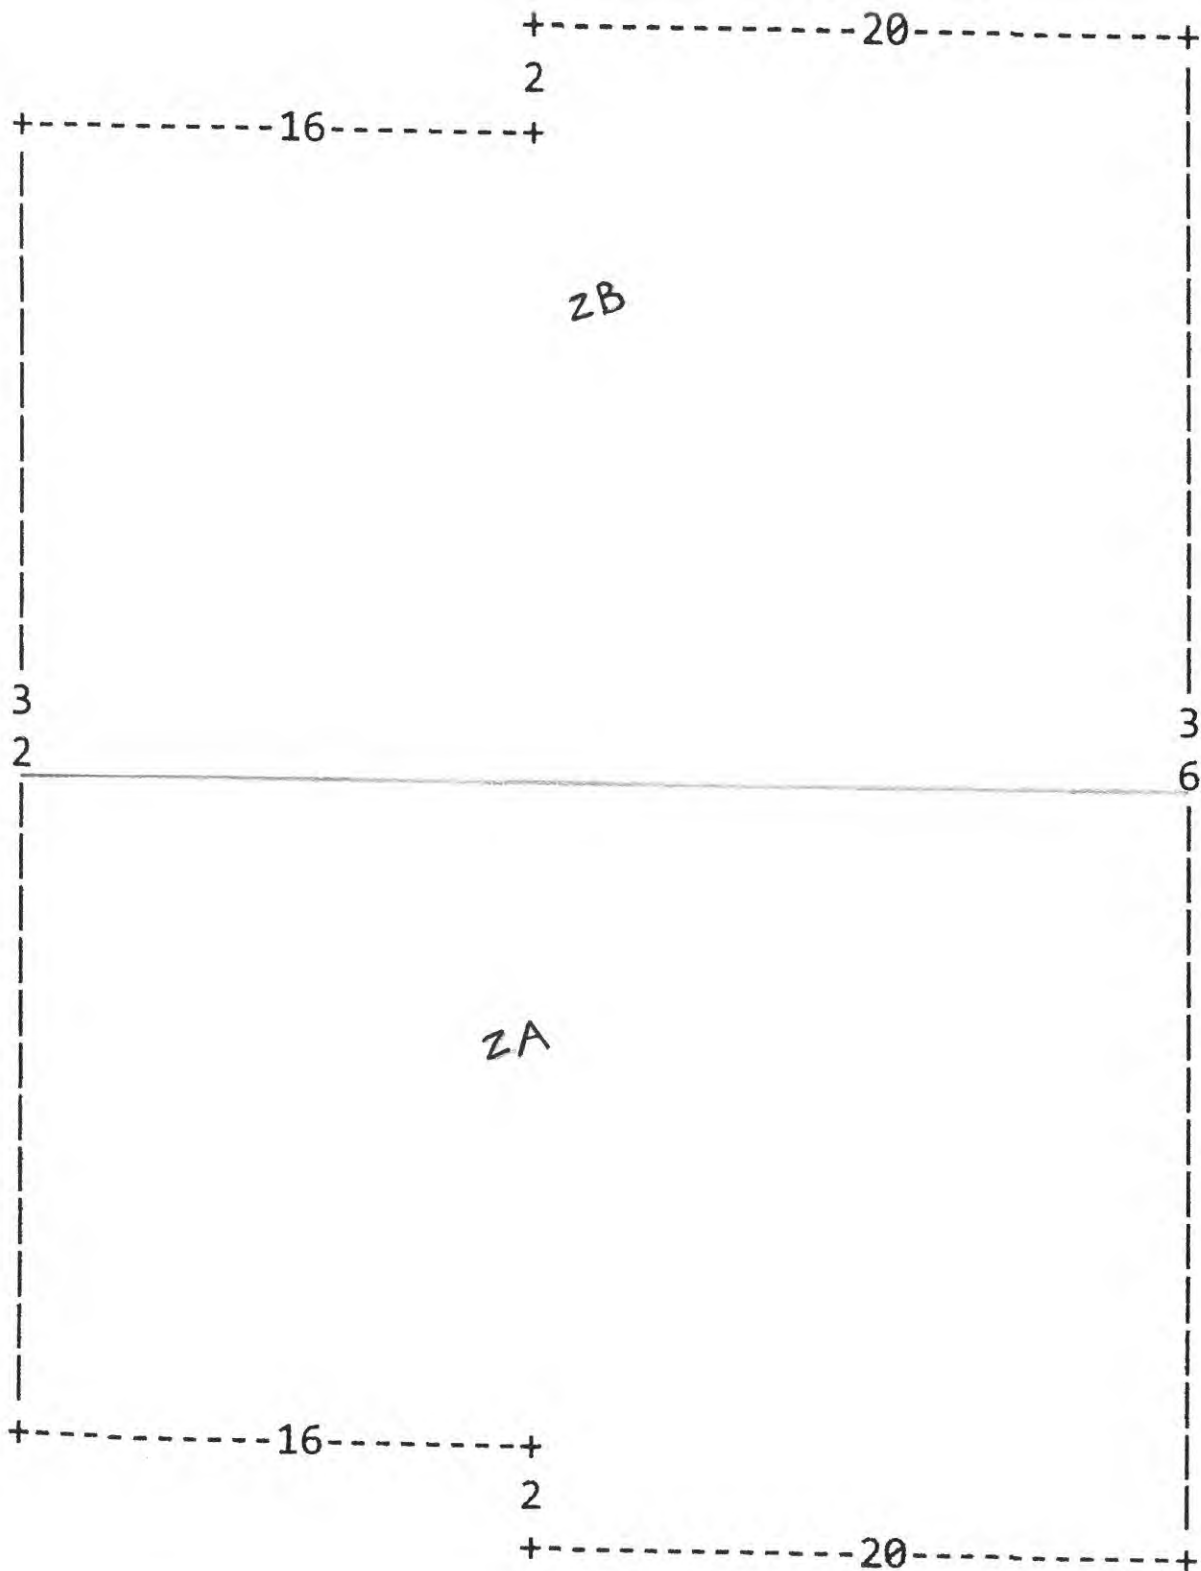

525 Meredith  
 (SMALL BLDG)  
 1st Floor  
 PWSID # 7707112


NOTES:

1- 2" PVC ENTERS  
 APARTMENT 1B.

2- 3/4" COPPER FROM  
 1B TO EACH APARTMENT.


3- 3/4" COPPER ENTERS  
 1A, 2A, AND 2B IN THE KITCHEN.

3-8-17

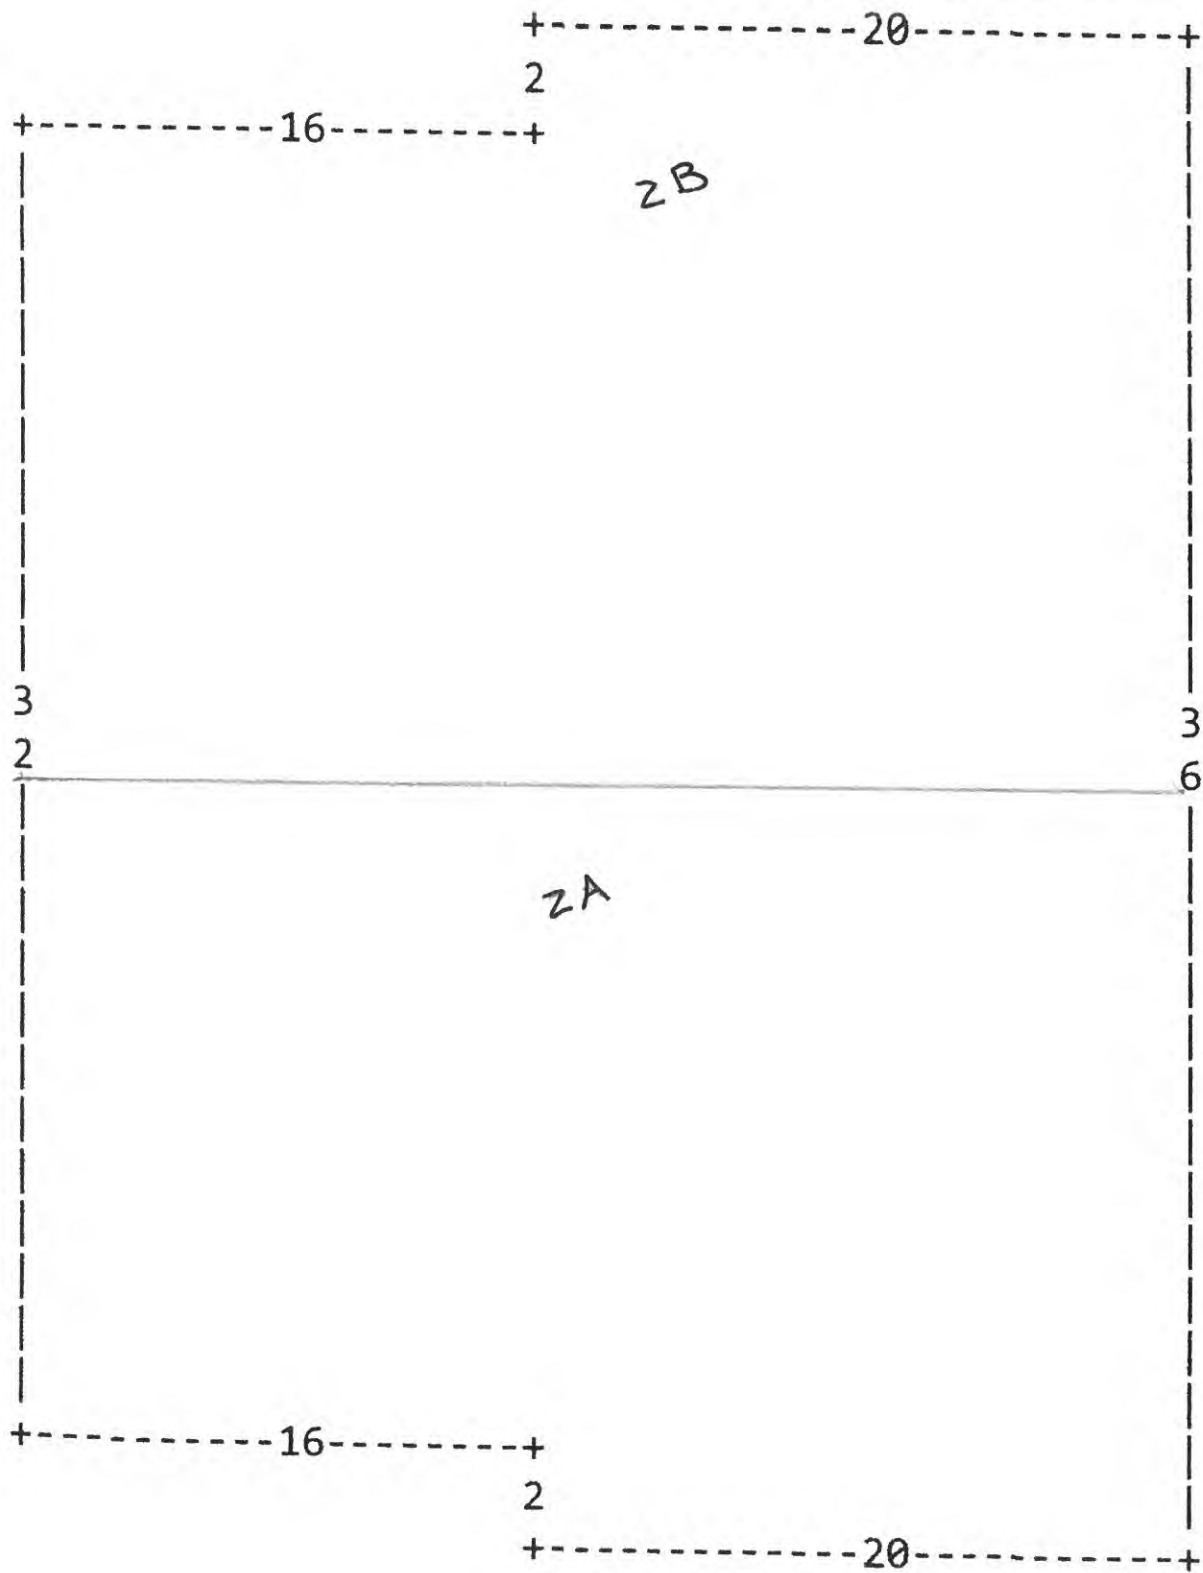

525 Meredith  
2<sup>nd</sup> Floor

3-8-17

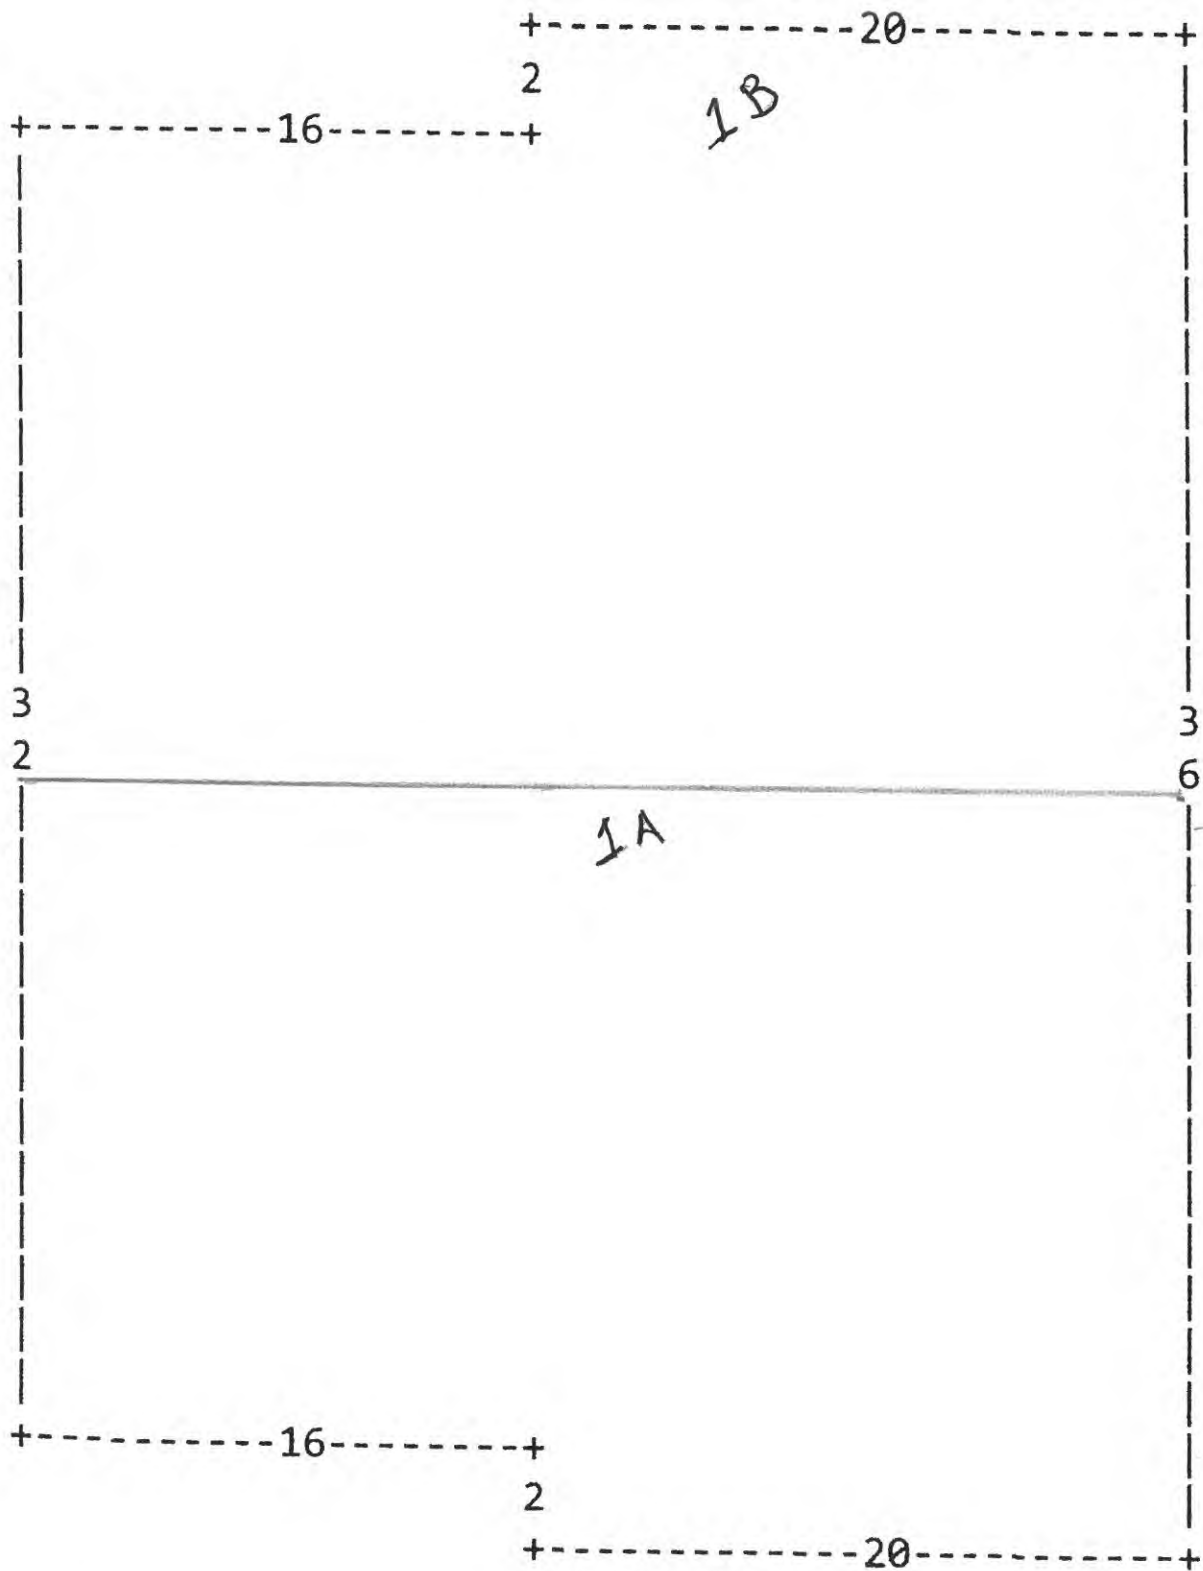

525 Meredith  
LL

3-8-17