

MAPLEWOOD MIDDLE SCHOOL FLOOR 1

4174 Greenville rd.NE
Cortland, Ohio 44410
Phone 330 924-2431
PWS ID OH 7848812
Facility ID 7859228

RECEIVED

MAR 06 2017

OHIO EPA NEDO

All service lines are copper after 1986
New building addition and all water lines replaced
in the old building finished in 2002

- 1 WATER CONNECTION FROM WELL PVC FROM WELL TO CAST IRON INTO BLDG TO COPPER
- 2 SINK COPPER RM 145
- 3 SINK COPPER RM 146
- 4 SINK COPPER REST ROOM RM 146
- 5 DRINKING FOUNTAIN COPPER HALL OUTSIDE OF RM 147
- 6 SINK OFFICE COPPER RM 108
- 7 SINK COPPER REST ROOM CLINIC RM 114
- 8 SINK COPPER CLINIC
- 9 SINK COPPER RR OFFICE
- 10 SINK COPPER RR OFFICE
- 11 ABCDE SINKS COPPER GIRLS REST ROOM
- 12 ABCDE SINKS COPPERBOYS REST ROOM
- 13 DRINKING FOUNTAIN COPPER HALL OUTSIDE OF RM 147
- 14 SINK COPPER RM 119 BAND
- 15 ABCD SINKS COPPER BOYS LOCKER ROOM
- 16 DRINKINGFOUNTAIN BOYS LOCKER ROOM
- 17 ABCD SINKS COPPER GIRLS LOCKER ROOM
- 18 DRINKINGFOUNTAIN COPPER GIRLS LOCKER ROOM
- 19 SINK COPPER RM 133
- 20 SINK COPPER REST RM RM 133
- 21 EYE WASH STATION COPPER RM 132
- 22 ABCDEF SINKS COPPER SCIENCE LAB RM 132
- 23 DRINKING FOUNTAIN COPPER WEST GYM DOOR

Entity: MAPLEWOOD MIDDLE SCHOOL
Doc Type: Report
Doc Subtype: _____
Program: DRINKING WATER
County: TUMBLE
Secondary ID: OH7848812

MAPLEWOOD MIDDLE SCHOOL 2ND FLOOR

- 1 WATER SOFTENERS 2 TANKS COPPER TO PVC TO COPPER
- 2 RETENTION TANKS 3 TANKS COPPER TO PVC TO COPPER
- 3 PRESSURE TANKS 2 TANKS COPPER
- 4 ARSENIC REMOVAL SYSTEM 4 TANKS COPPER TO PVC TO COPPER
- 5 SINK COPPER RM 206
- 6 SINK COPPER KITCHEN REST RM
- 7 DOUBLE SINK COPPER KITCHEN
- 8 TRIPLE SINK COPPER KITCHEN
- 9 DISHWASHER COPPER KITCHEN
- 10 GARBAGE DISPOSAL SINK & SPRAYER COPPER KITCHEN
- 11 HAND SINK COPPER KITCHEN
- 12 SINGLE SINK COPPER KITCHEN
- 13 SINK COPPER BOYS RESTROOM
- 14 DRINKING FOUNTAIN COPPER OUTSIDE RM 216
- 15 SINK COPPER RM 216
- 16 EYE WASH STATION COPPER RM 217
- 17 ABC SINKS COPPER RM 217
- 18 DRINKING FOUNTAIN COPPER OUTSIDE RM 217
- 19 ABCD SINKS COPPER
- 20 ABCD SINKS COPPER HOME EC ROOM

MAPLEWOOD MIDDLE SCHOOL 3RD FLOOR



- 1 DRINKING FOUNTAIN COPPER OUTSIDE RM 308
- 2 SINK COPPER RM 308
- 3 EYE WASH STATION COPPER RM 309
- 4 ABC SINKS COPPER RM 309
- 5 DRINKING FOUNTAIN COPPER OUTSIDE RM 309
- 6 ABCD SINKS COPPER GIRLS REST ROOM
- 7 SINK COPPER BOYS REST ROOM

RECEIVED

MAR 06 2017

OHIO DEPARTMENT OF EDUCATION

MAPLEWOOD MIDDLE SCHOOL
FIRST FLOOR

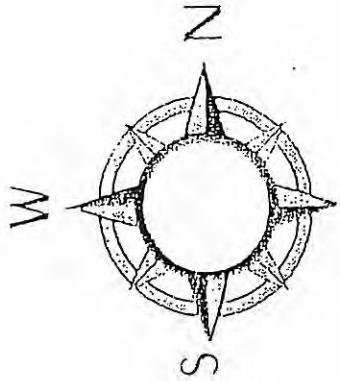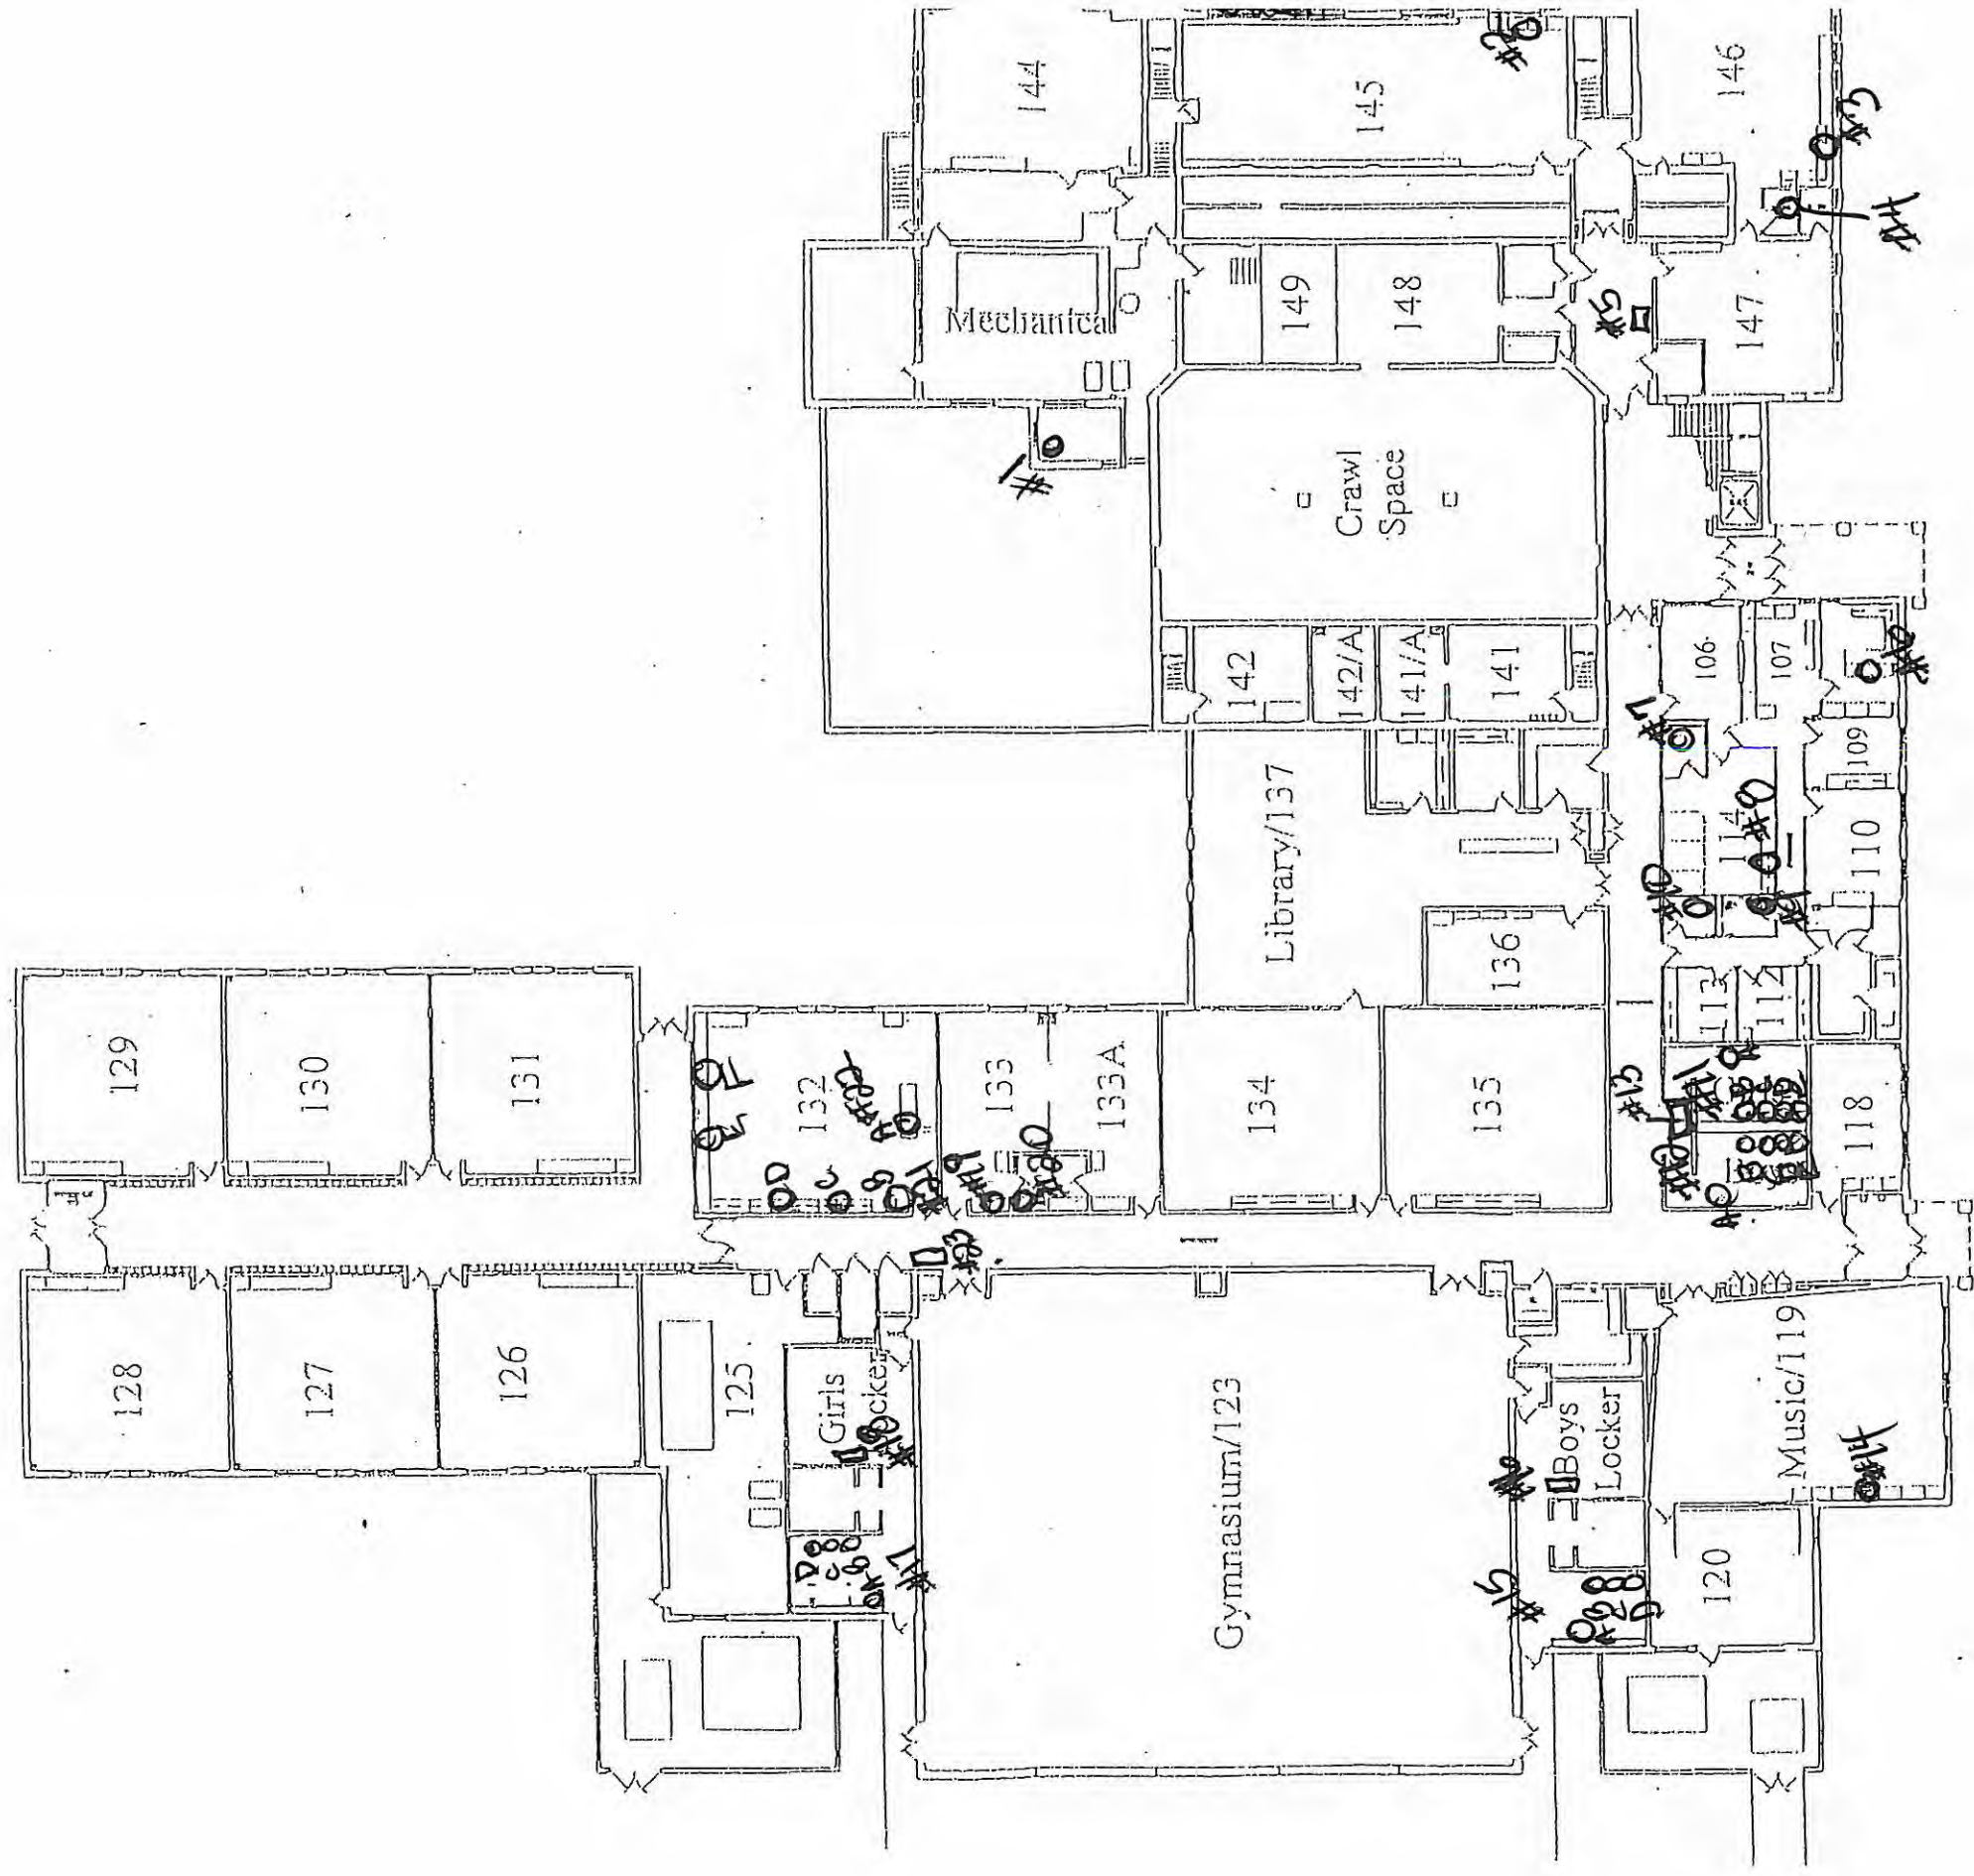

RECEIVED



MAR 06 2017

CHUCK KRAVITZ

MAPLEWOOD MIDDLE SCHOOL
SECOND FLOOR

FIRE

Second Floor Rooms
Exit North Doors

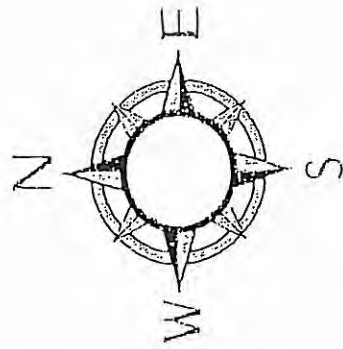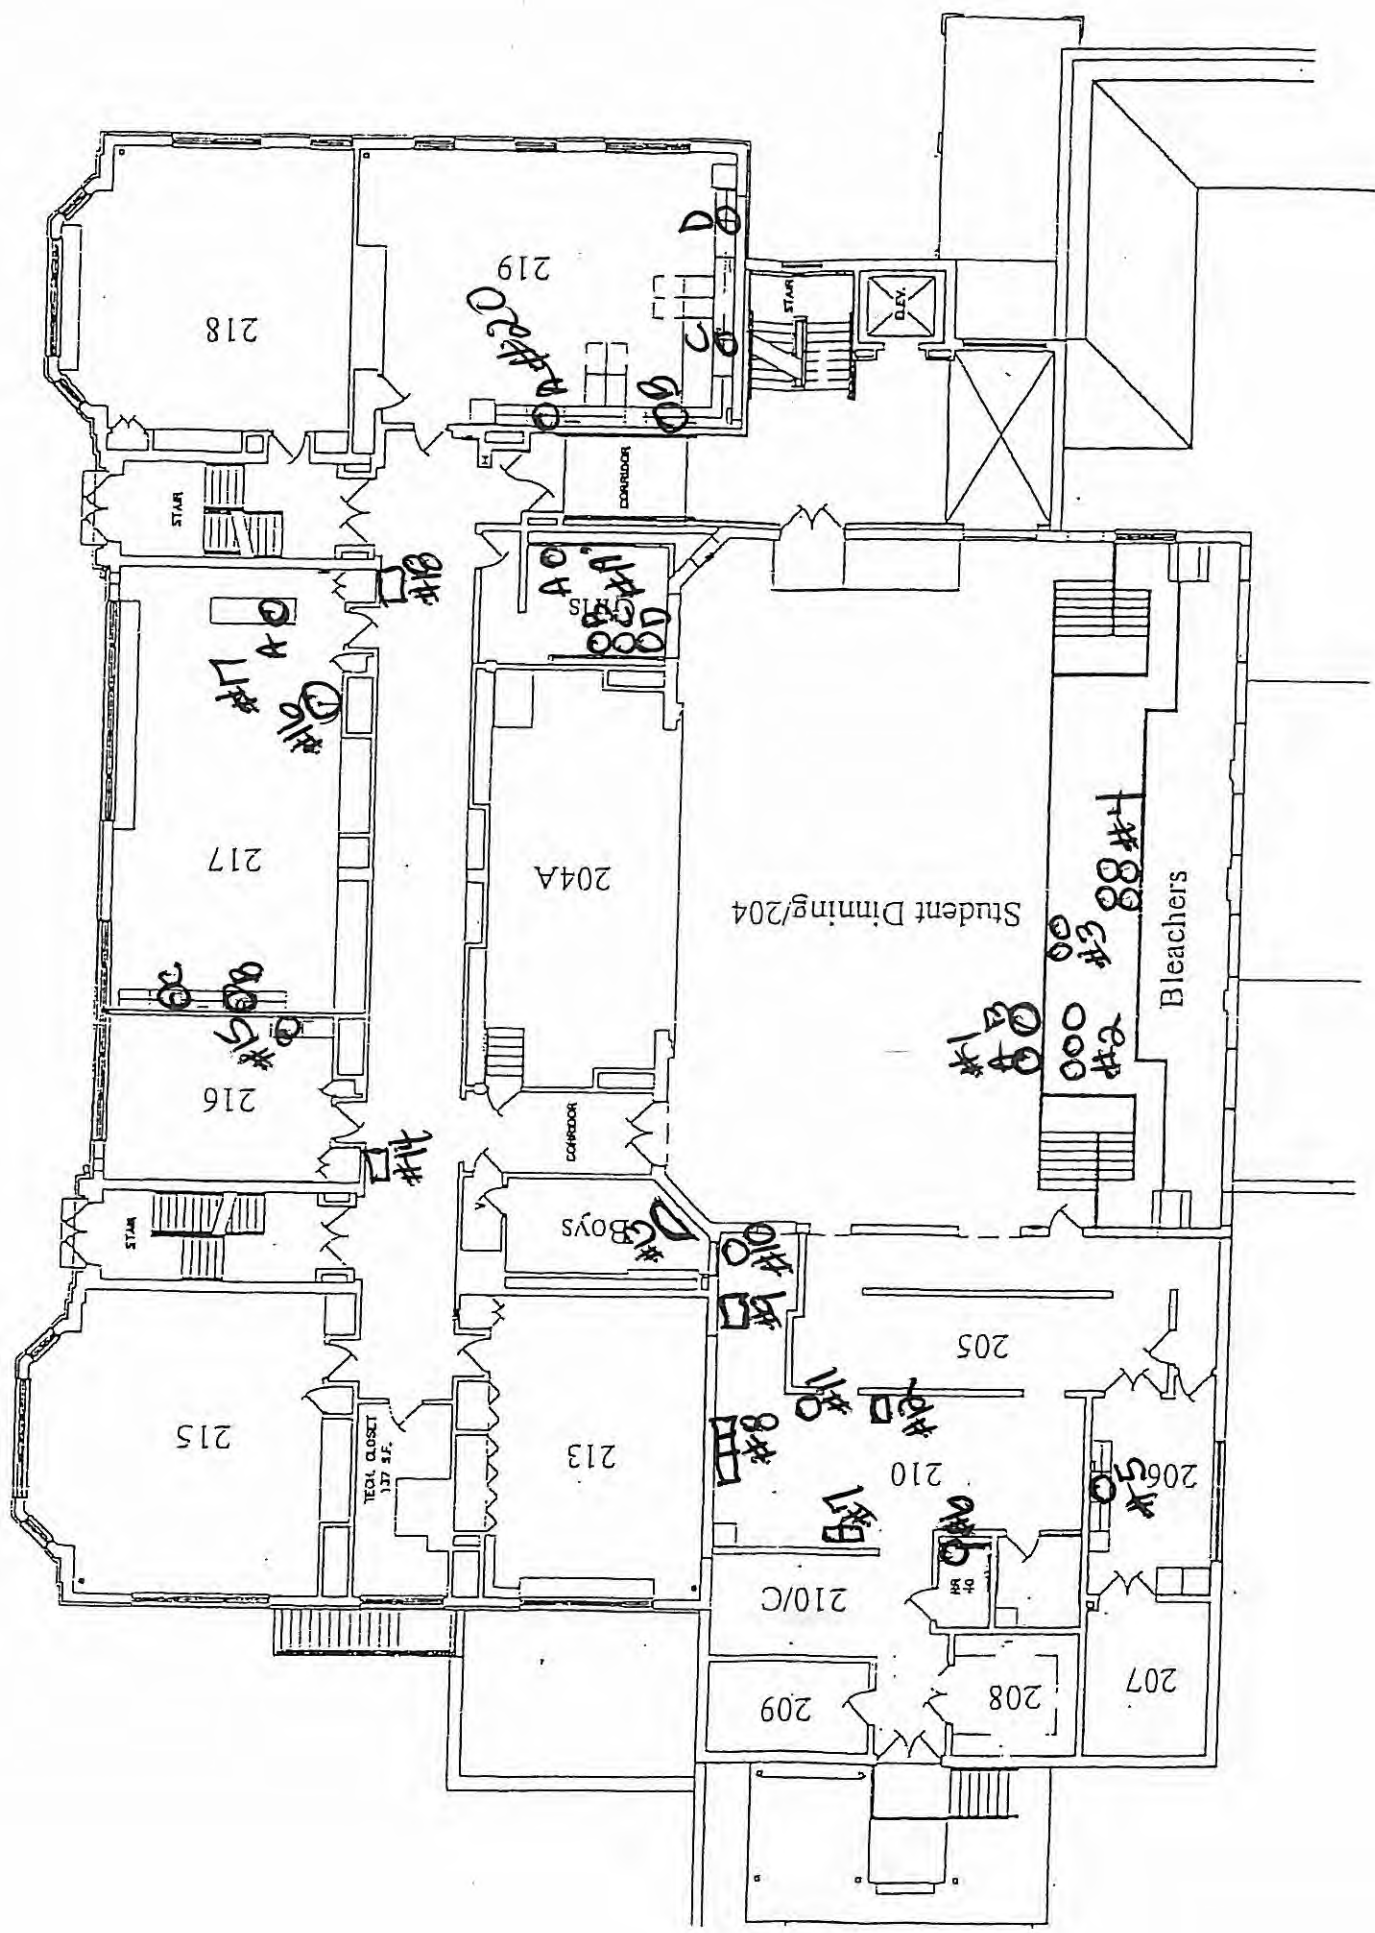

RECEIVED

MAR 05 2017

OLIVERA

MAPLEWOOD MIDDLE SCHOOL
THIRD FLOOR

FIRE

Third Floor Rooms
Exit North Doors

