
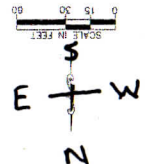


LEGEND

- - WELL
- ▨ - WATER PLANT
- ⊙ - STAND PIPE
- Outline of Building

■ - Area may contain Lead Solder in Service Lines.

- Wastewater Facility
- Plastic / Non-Lead main line

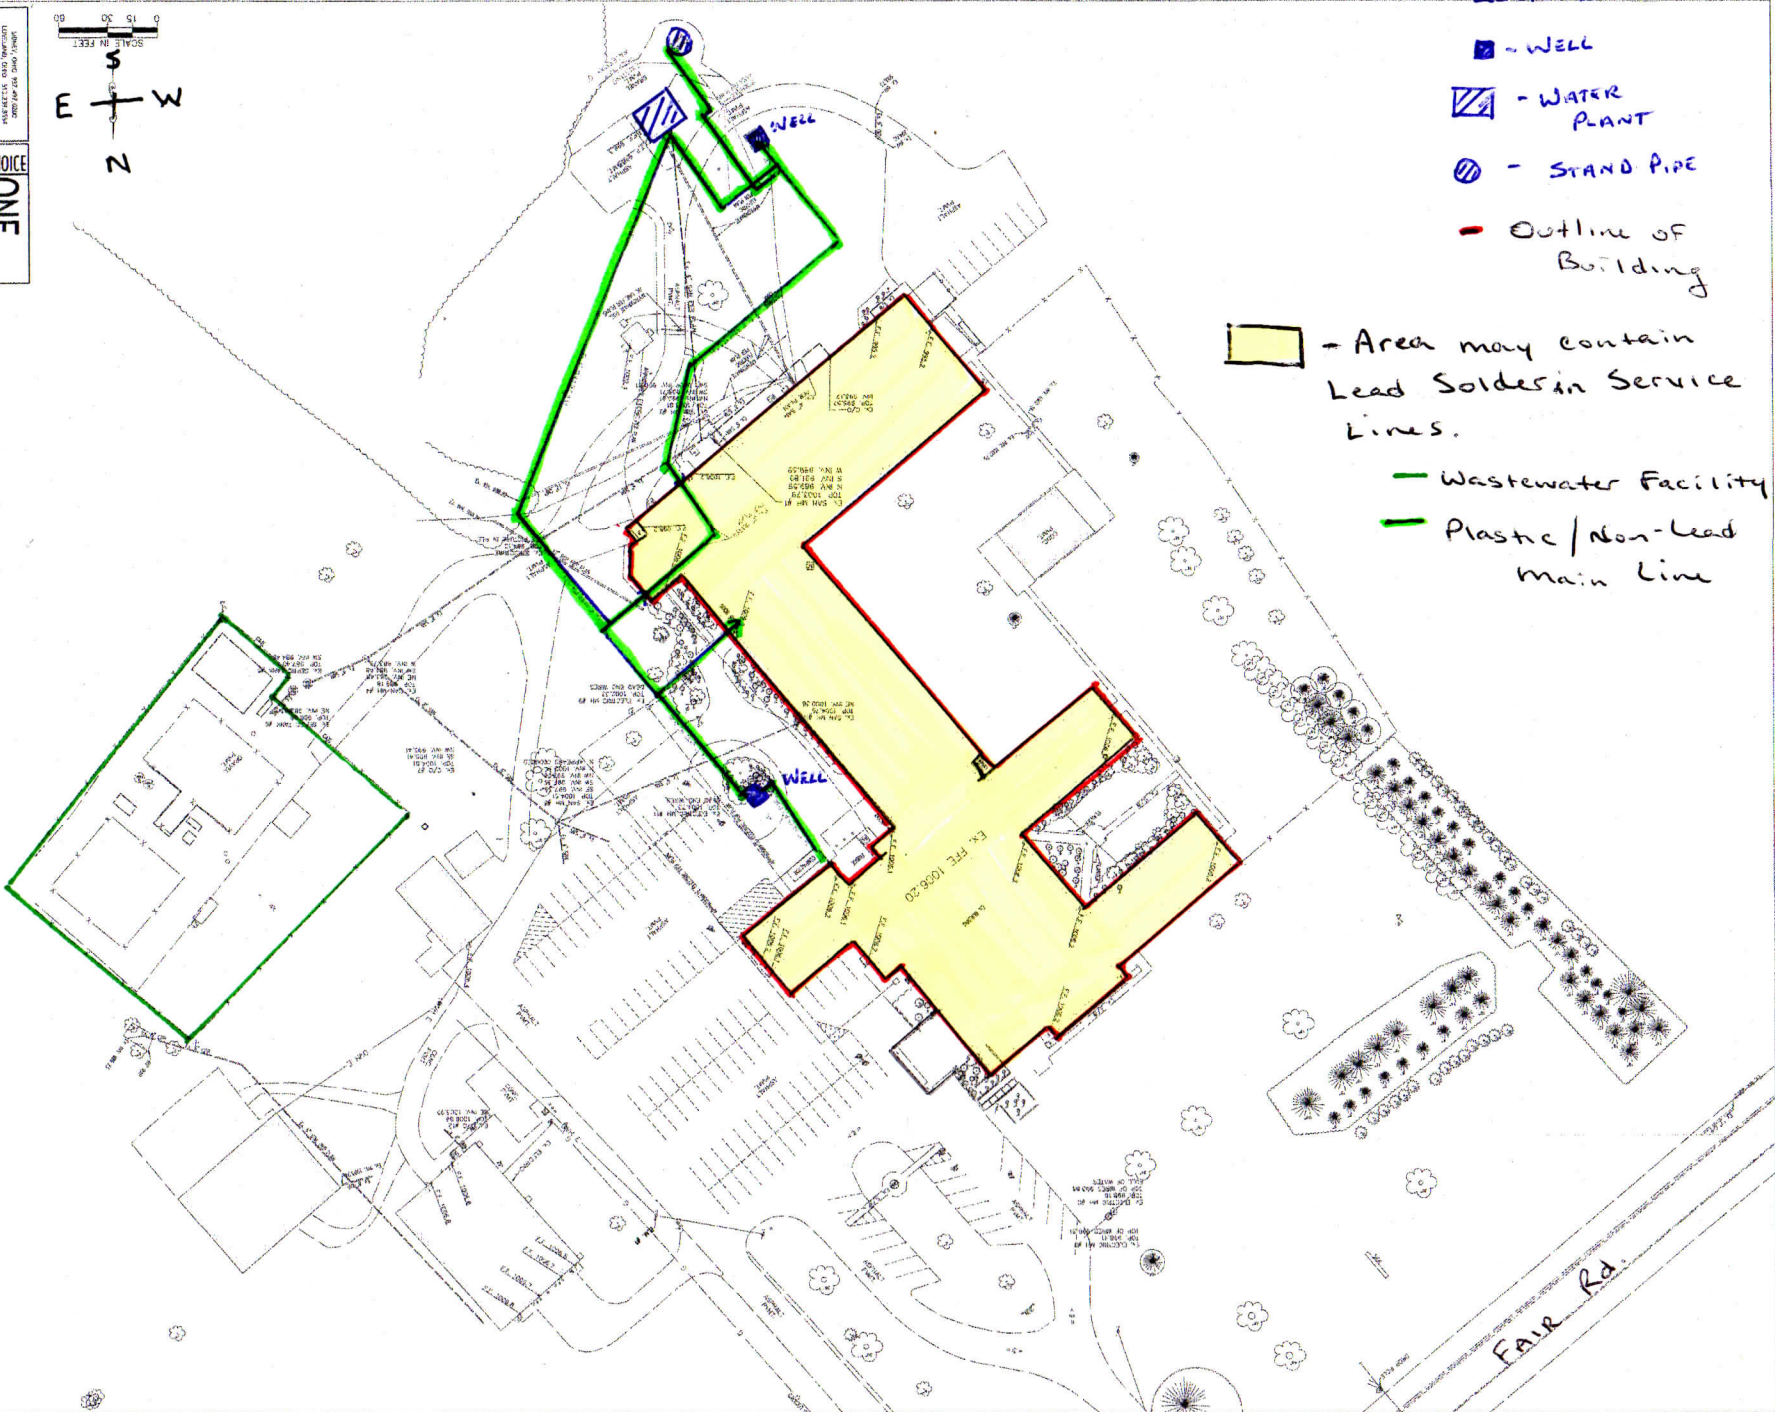

SHEET ONE OF TWO DATE: 05/13/2017 PROJECT: 1427 SHEETS: 2	
CHOICE ONE	ENGINEERING
REVISIONS: 1. 05/13/2017: Initial design and site plan. 2. 05/13/2017: Final design and site plan. 3. 05/13/2017: Final design and site plan.	

EARLY SITE WORK
DRAWINGS

RENOVATION AND NEW ADDITION
FAIR HAVEN
SHELBY COUNTY HOME
2901 FAIR ROAD
SIDNEY, OHIO 45365

FREYTAG & ASSOCIATES INC.
ARCHITECTS ENGINEERS
226 N. MAIN AVE.
P.O. BOX 220
SIDNEY, OHIO 45365
TELEPHONE (937) 482-7576
FAX (937) 482-6963
EMAIL: info@freitag.com



Shelby County Sewer District

3475 Canal Road #1
Minster, Ohio 45865
(419) 628-3411

Fair Haven-Shelby County Home
PWS ID# OH7501112
Lead and Copper Narrative
3/3/2017

To Whom It May Concern,

This narrative includes information pertaining to the Lead and Copper Mapping Requirements of 2017. After reviewing the water lines from the water plant in to the nursing home, it has been determined that the main lines are Ductile Iron. Service lines are an assortment of plastic and copper. The building was constructed prior to 1988 so there is a possibility of lead solder more than 0.2%. The building may also contain materials with greater than 8% lead and are at a higher risk of contributing lead to the drinking water. Record retention of repairs and maintenance is currently unavailable. I met with the current maintenance supervisor to help field this information. Please contact me should you have any questions regarding this matter.

Sincerely,

Tyler Shuster
Shelby County Sewer District, Director
3475 Canal Road No. 1
Minster, OH 45865
Cell: 937-538-0132
Office: 419-628-3411
Email: tshuster@shelbycountyengineer.com

VERIFICATION FORM FOR COMMUNITY PUBLIC WATER SYSTEMS CLAIMING NO LEAD SERVICE LINES

The owner or operator of all community public water systems must identify and map areas of their distribution system that are known or are likely to contain lead service lines. Systems must submit a copy of the applicable map to the Ohio Department of Health and the Ohio Department of Job and Family Services. Systems must also submit a report to the director containing at least both of the following: (1) The applicable map with narrative, and (2) A list of sampling locations used to collect samples as required by Ohio Revised Code (ORC) Section 6109.121 and any rules adopted thereunder, including contact information for the owner and occupant of each sampling site.

Should a water system determine no lead service lines exist in their distribution system, they must provide information stating they reviewed, at the minimum, historical permit records and local ordinances, distribution maintenance records and information pertaining to installation dates or materials for all services lines. This information must be verified below.

I HEREBY CERTIFY THAT THE FOLLOWING METHOD(S) WERE USED TO DETERMINE NO LEAD SERVICE LINES EXIST IN THIS WATER SYSTEM'S DISTRIBUTION SYSTEM, AS REQUIRED BY ORC 6109.121(F):

LEAD SERVICE LINE VERIFICATION

This PWS states they have no lead service lines and has reviewed the following information (select one or more of the following):

- ☐ Historical permit records and/or local ordinances
- ☒ Distribution maintenance records (i.e. meter replacement, waterline break repairs)
- ☒ Information pertaining to installation dates for all service lines (i.e. after 1986 when lead services lines were banned)
- ☒ Service line material of all service lines is known (i.e. all service lines are known to be PVC)

 3-8-17
Signature of Responsible Person Date

TYLER SHUSTER, DIRECTOR SCSO
Printed Name and Title of Responsible Person

PWS NAME: FAIR HAVEN - SHELBY
PWS ID: COUNTY HOME
COUNTY: OH 7501112
SHELBY

For Ohio EPA use only:

Date Verification Rec'd: _____