


DFC MOBILE HOME PARK
PWS ID OH 0405512

RECEIVED
MAR 08 2017

PVC Plastic line

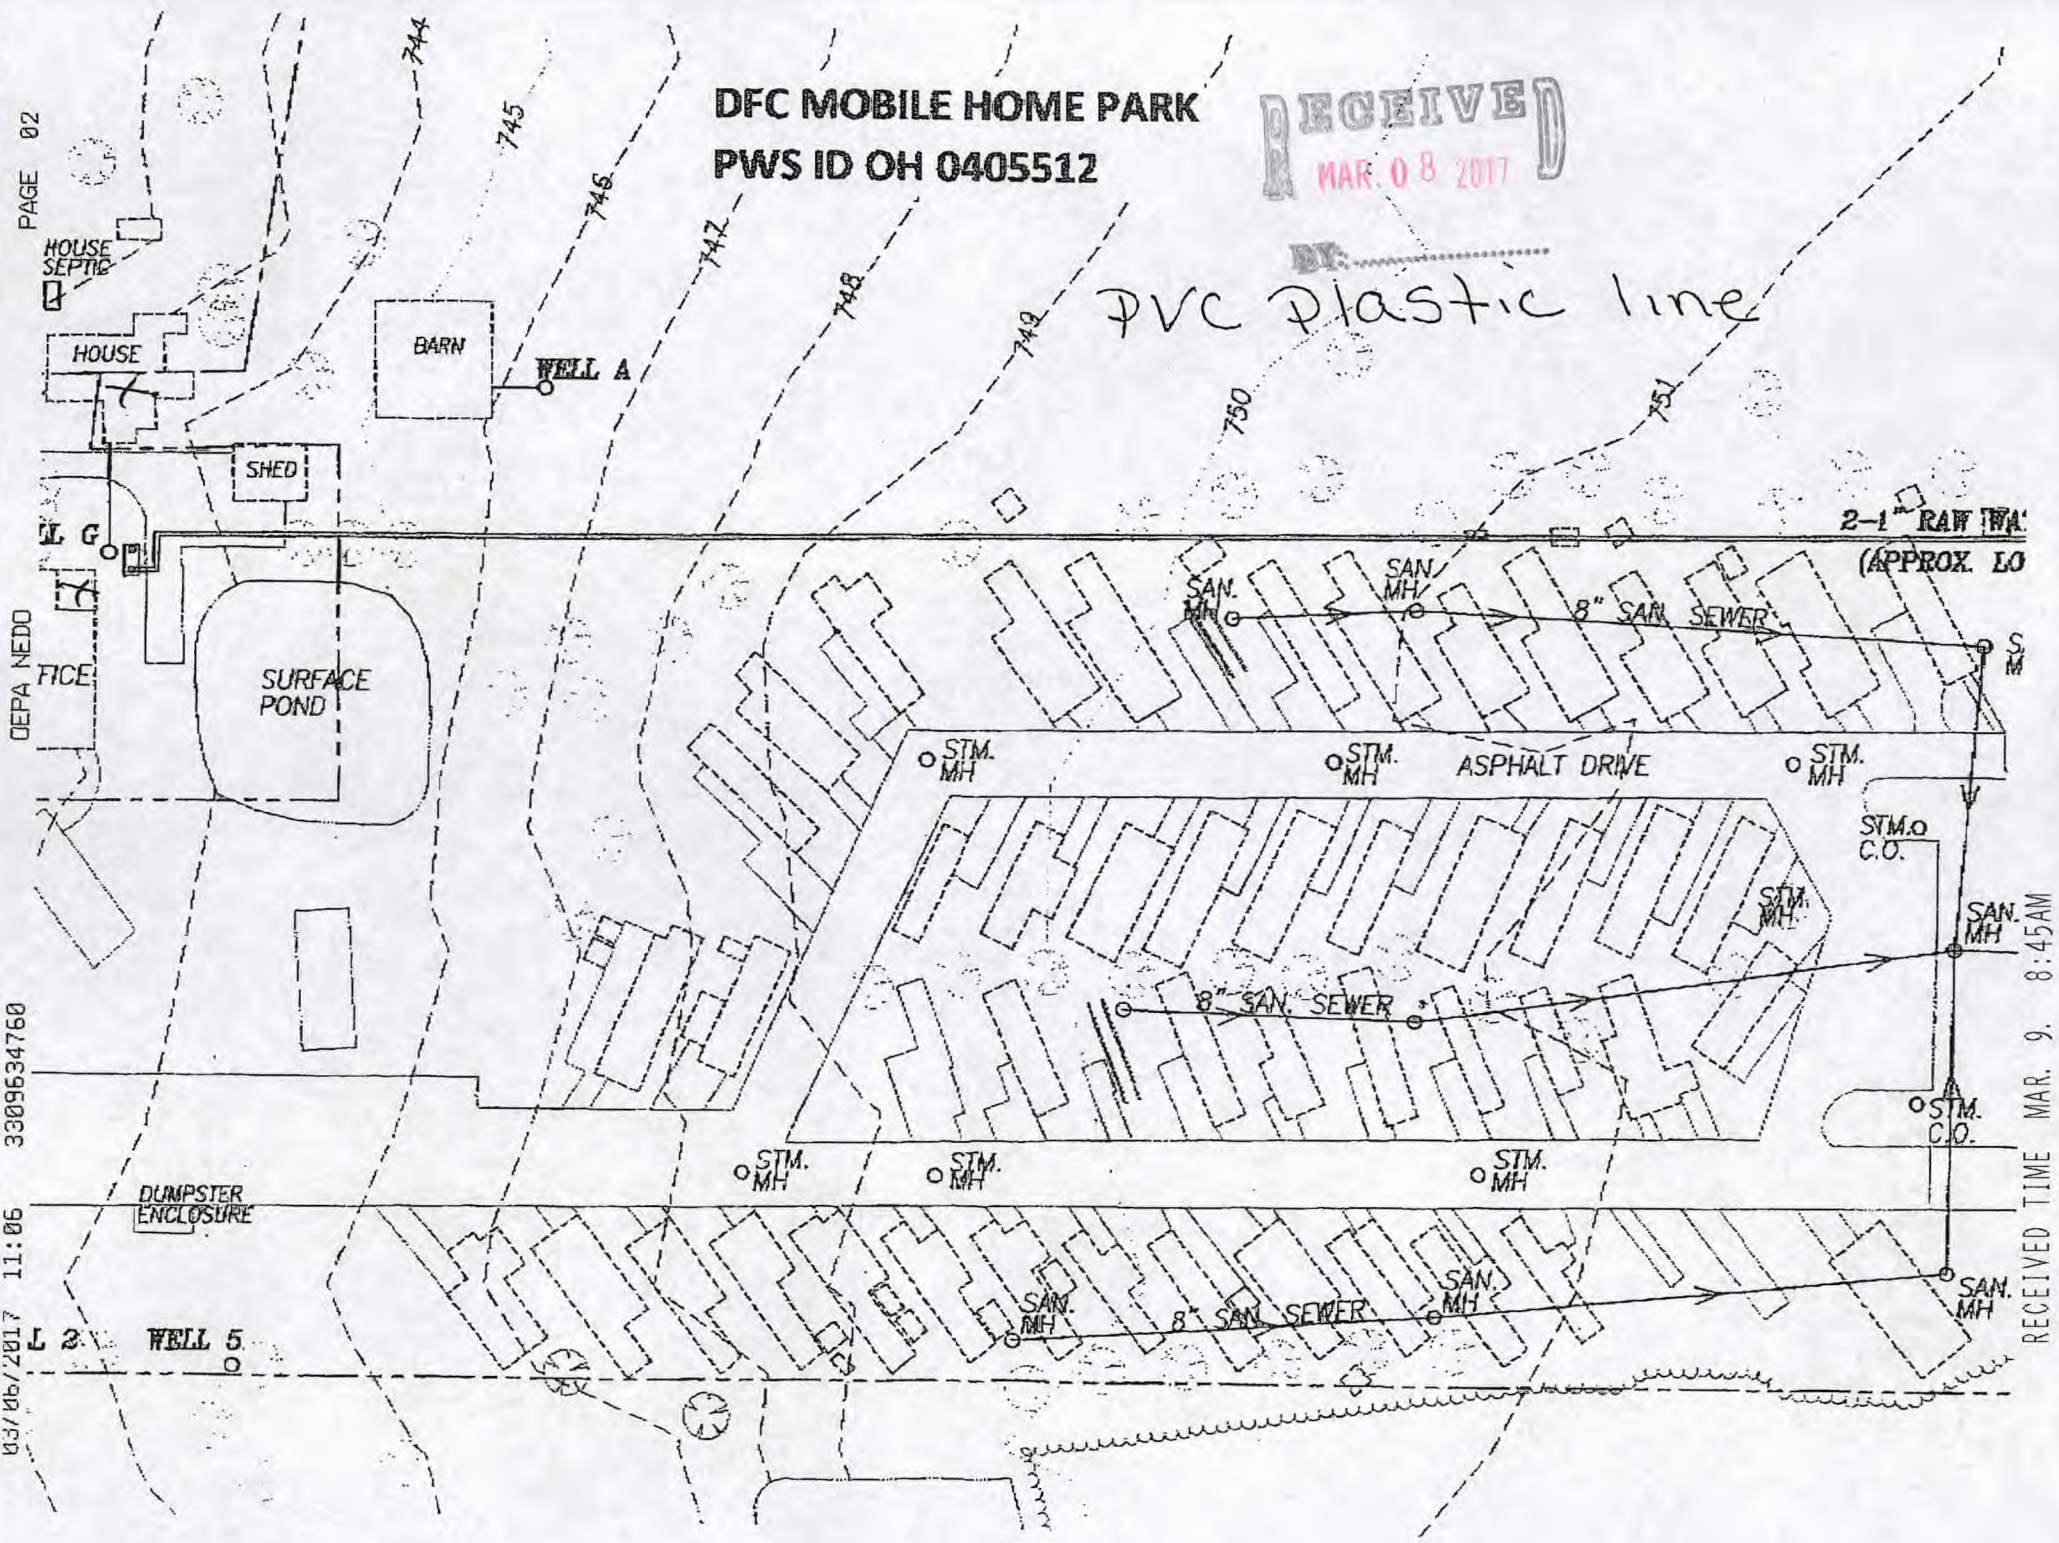

DEPA NEDO

3309634760

11:06

03/06/2017

RECEIVED TIME MAR. 9. 8:45AM