










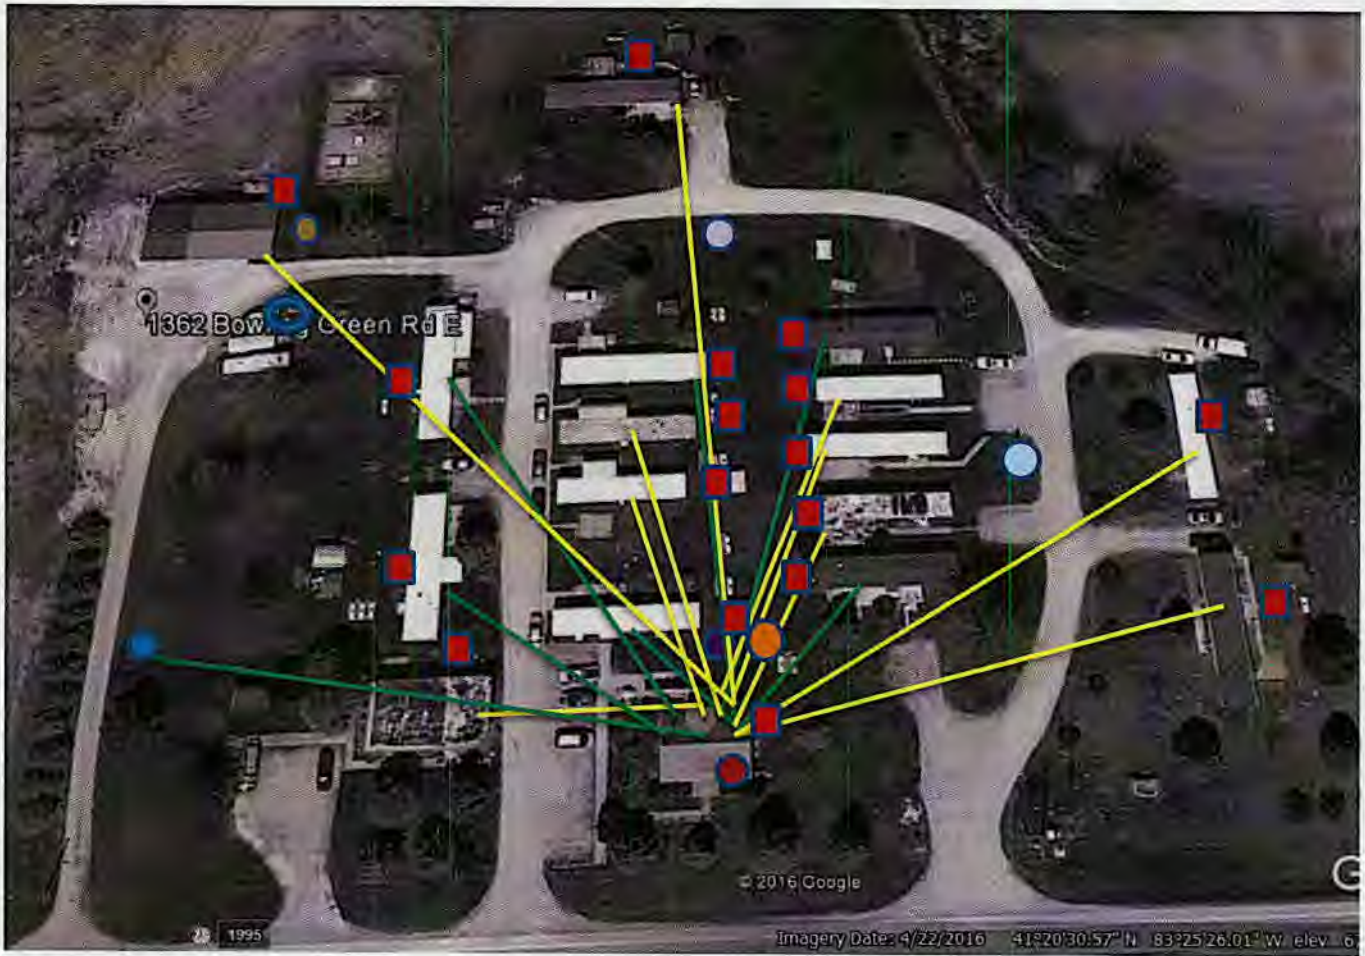


RE: TWIN MAPLES MHP
Report
Drinking Water Program
Wood County
PWS ID: OH8702712



Twin Maples Mobile Park LLC. 1362 East Bowling Green RD. Bradner, OH 43406

Charles Gribbin

(419-764-5087)

<u>Symbol</u>	<u>Description</u>	<u>Symbol</u>	<u>Description</u>
	Lead		Hand Pump
	Non Lead		Well
	Shut off valve-13		Water Hydrant
	Main shut off valve		
	Shut off valve- pole building		
	West Shut off valve-Lot 1,3,4,5, 14, 15 Appts 16,17,18,19		
	North West shut off valve-Lot 6,7,8,9, 10		
	Shut off valve-lot 11, 12		

RECEIVED
 MAR 07 2017
 DDAGW - NWDO