

RE: ST JOHN LUTHERAN SCHOOL-
NAPOLEON

Report

Drinking Water Program

Henry County

PWS ID: OH3536112

ST. JOHN LUTHERAN
16035 COUNTY ROAD 4
NAPOLEON, OHIO

RECEIVED

MAR 09 2017

OHIO E.P.A.
N.W.D.O.



PWS ID # OH3536112

PWS Name ⇒ St. John Lutheran School -
Napoleon

Smp ID ⇒ LC 201

Tier Site ⇒ 2

Address ⇒ 16035 County Road 4

City ⇒ Napoleon

State ⇒ OHIO


Zip ⇒ 43545

Tap Location ⇒ Kitchen Hand
Wash Sink

Church # 419-598-8702

ORC # 419-591-9124
Kenneth Griff

EDGE OF PRESENT

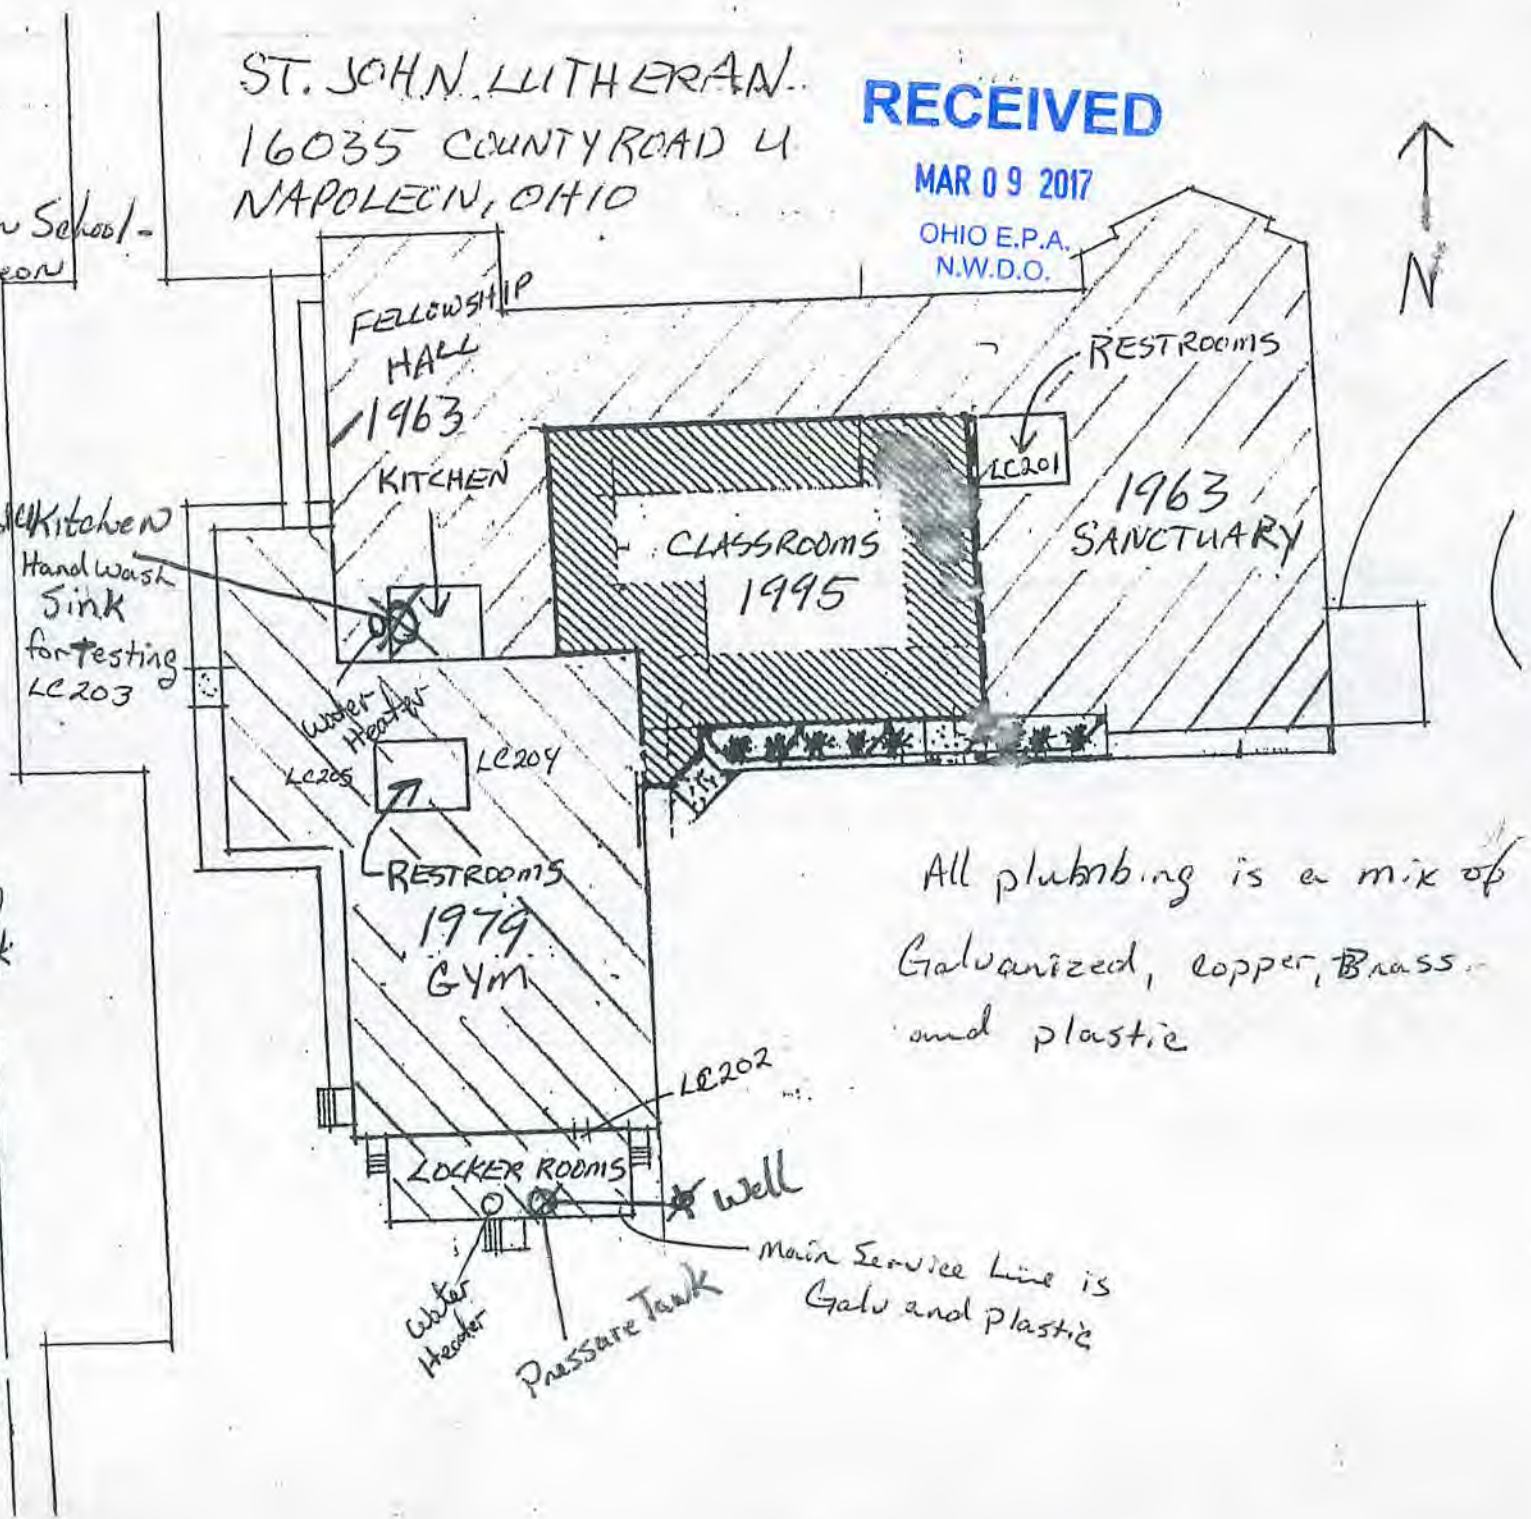

All plumbing is a mix of
Galvanized, copper, Brass,
and plastic

main Service Line is
Galv and plastic