

There has been Lead Service Lines  
Dug, Found, and Removed it is possible  
There is still some Lead lines  
in the Area.

There is no Soldered Copper  
That we know of on Village  
Lines That we know of.

Although There are many properties  
That Have Copper/Soldered Plumbing  
inside the Home. all properties  
built prior to 1998 plumbed w/  
Copper is subject to have Lead  
Soldered joints.

It would Be safe to say 85% of  
all homes in ~~bar~~ <sup>bar</sup> was Built  
Prior to 1998.

2017 MAR -9 AM 10:23

5.10.17

“Buildings built prior to 1998 or that use plumbing material or solder manufactured before 1998 may have materials with greater than 8% lead and are at a higher risk of contributing lead to the drinking water than materials manufactured after 1998. In addition, buildings built and plumbing materials manufactured after 2014 were required to have less than 0.25% lead by weight and have the lowest risk for contributing lead to the drinking water. It should be noted however that, although prohibited, some use of leaded solder or leaded components may have occurred after the prohibitions became effective.”

You can just add a sentence about the average age


2017 MAR -9 AM 10:23

5/10/17



ST-100

2017 MAR -9 AM 10:22

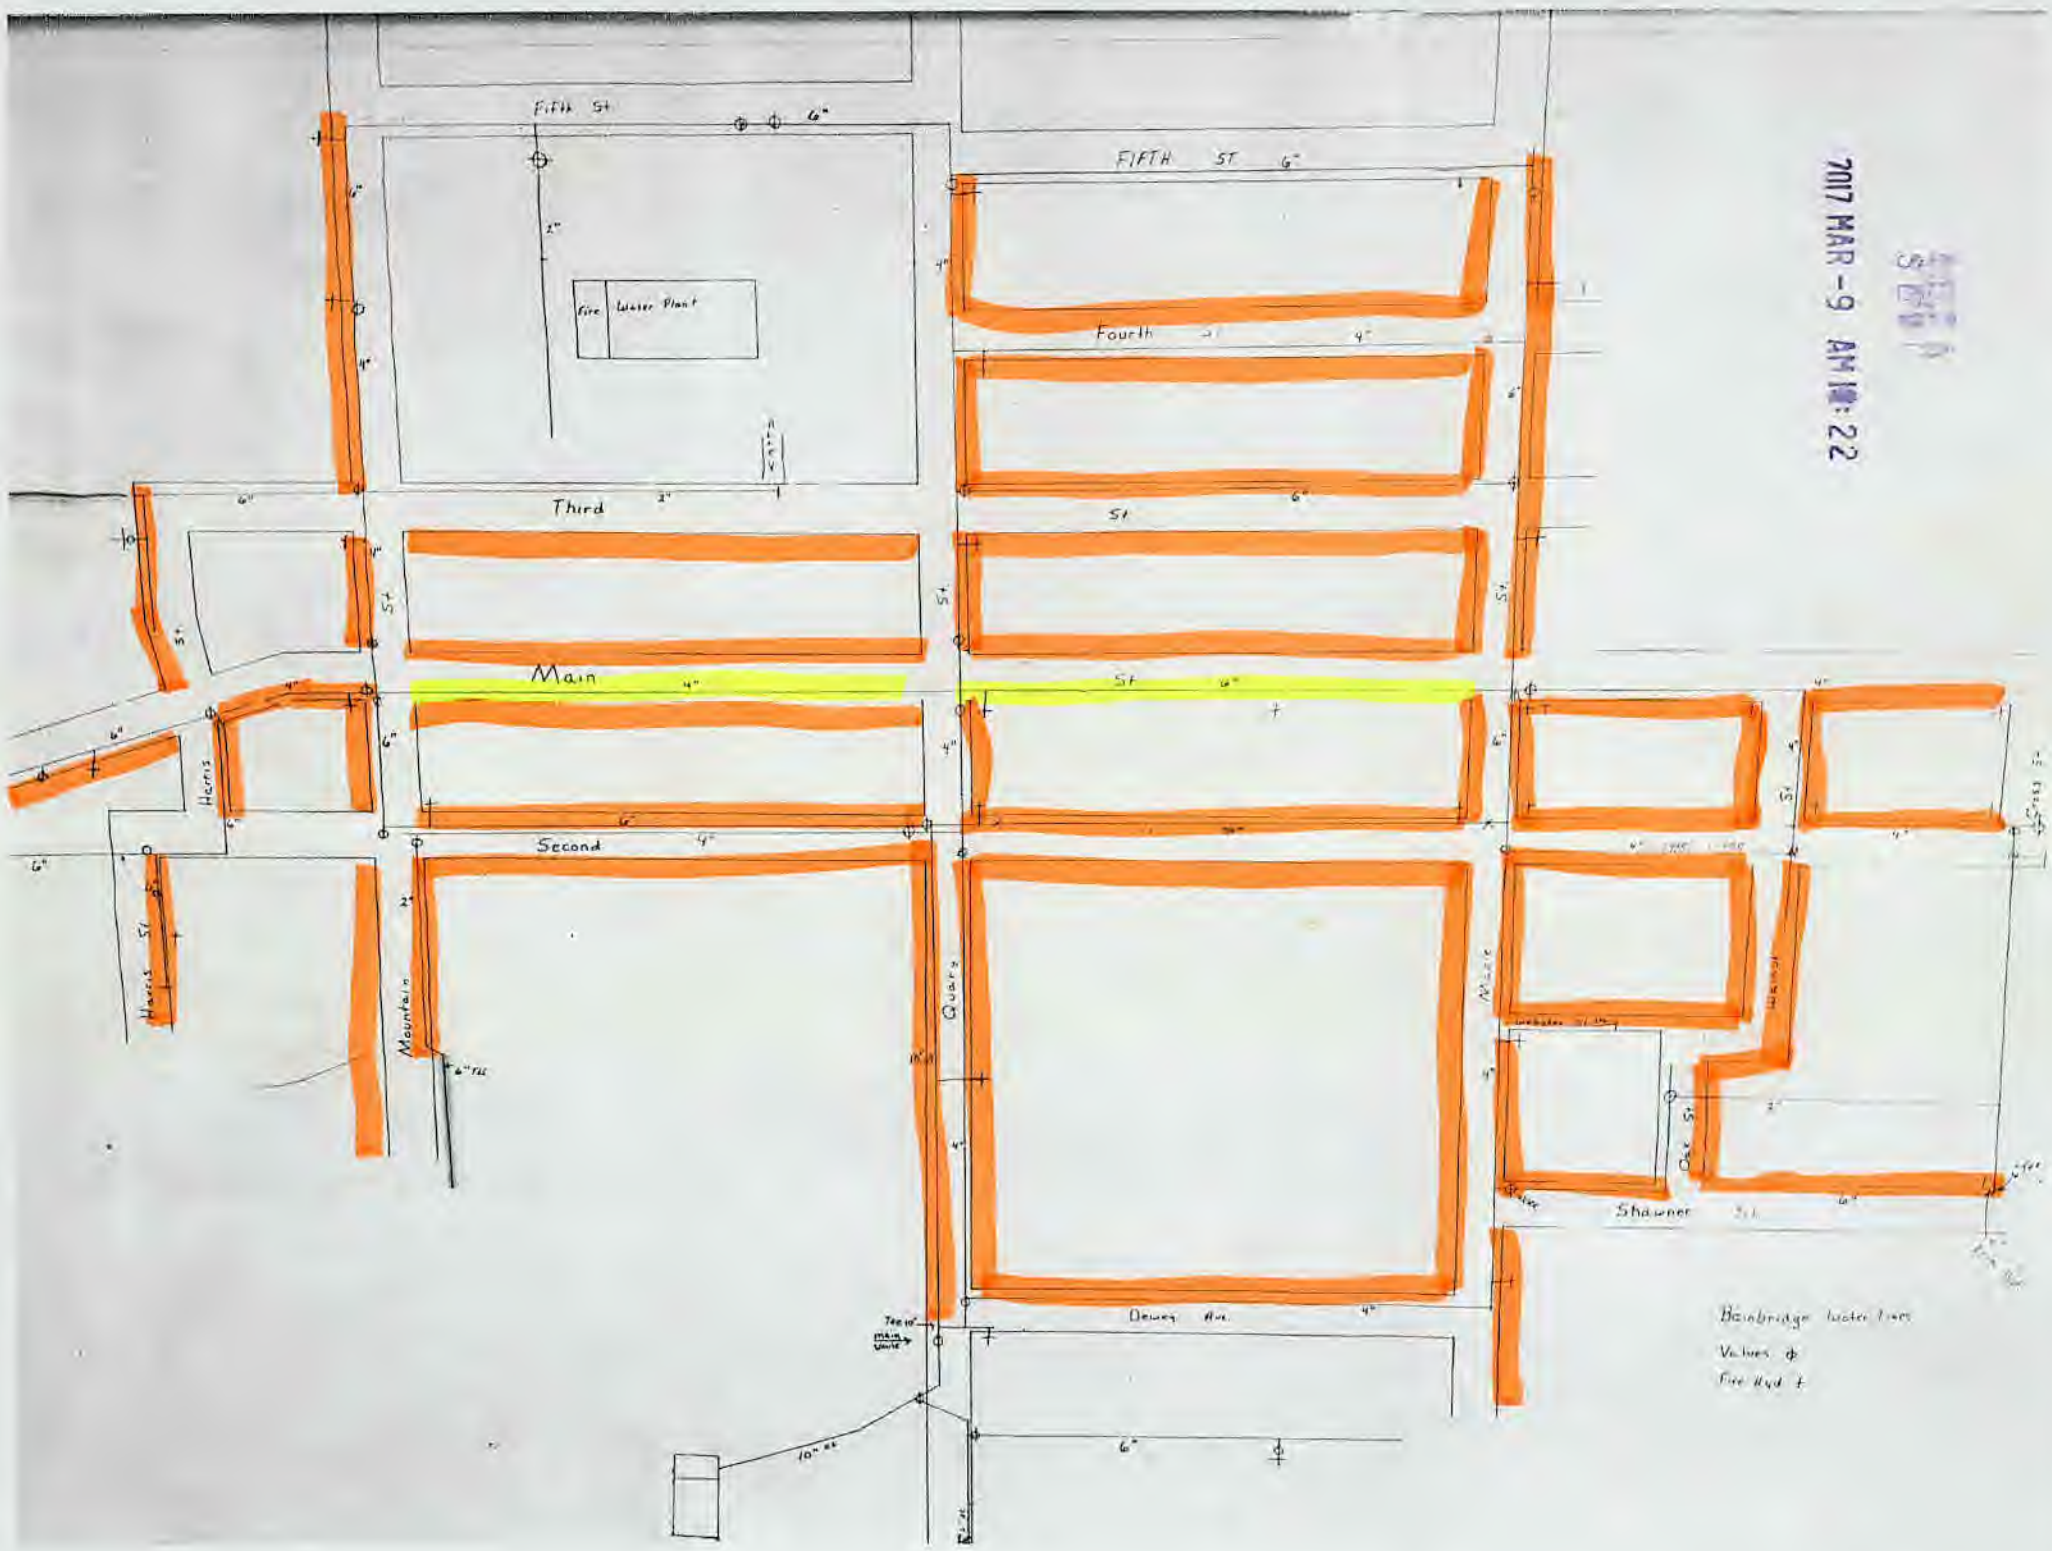

Bainbridge Water Lines  
Values of  
Fire Hyd. T