

HYDROX CORPORATION  
3875 S. ELYRIA RD.  
SHREVE, OH 44676

PHONE: 330-262-1300

PWS ID# 8559212

STU # 8559802

 = NON LEAD  
 = LEAD  
 = NO INFORMATION


BUILDING CONSTRUCTED 1991

COPPER SERVICE LINES  
LEAD FREE SOLDER

LADIES LOCKERROOM SINK

MENS LOCKERROOM SINK

NORTH  
→

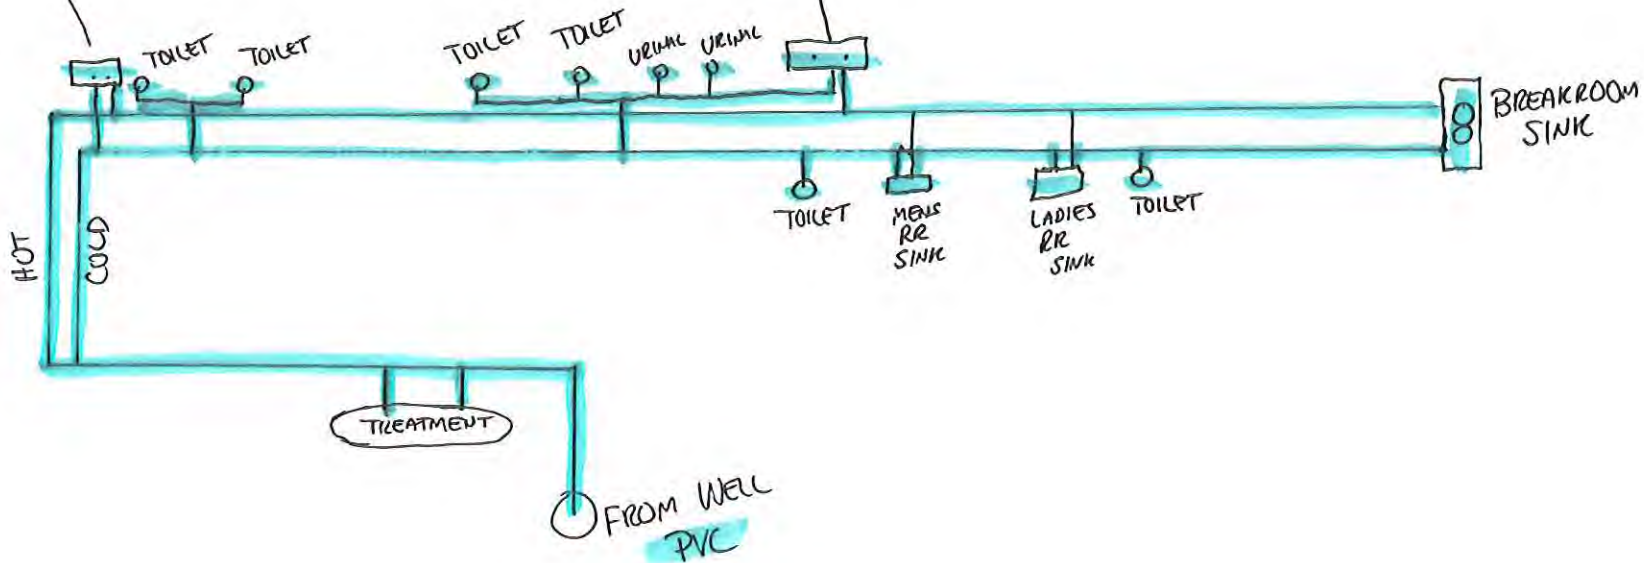

LEAD & COPPER SAMPLING SITES - HYPONEX CORPORATION

1. MENS RR SINK
2. LADIES RR SINK
3. BREAKROOM SINK
4. MENS LOCKERROOM SINK
5. LADIES LOCKERROOM SINK.

CONTACT: LEWIS MORRIS  
330-262-1300  
OPTION 6