

UPstairs

All built in 2000




Junction Buick GMC
12423 Ravenna Rd.
Chardon, OH 44024

N
S

down stairs

All built in 2000



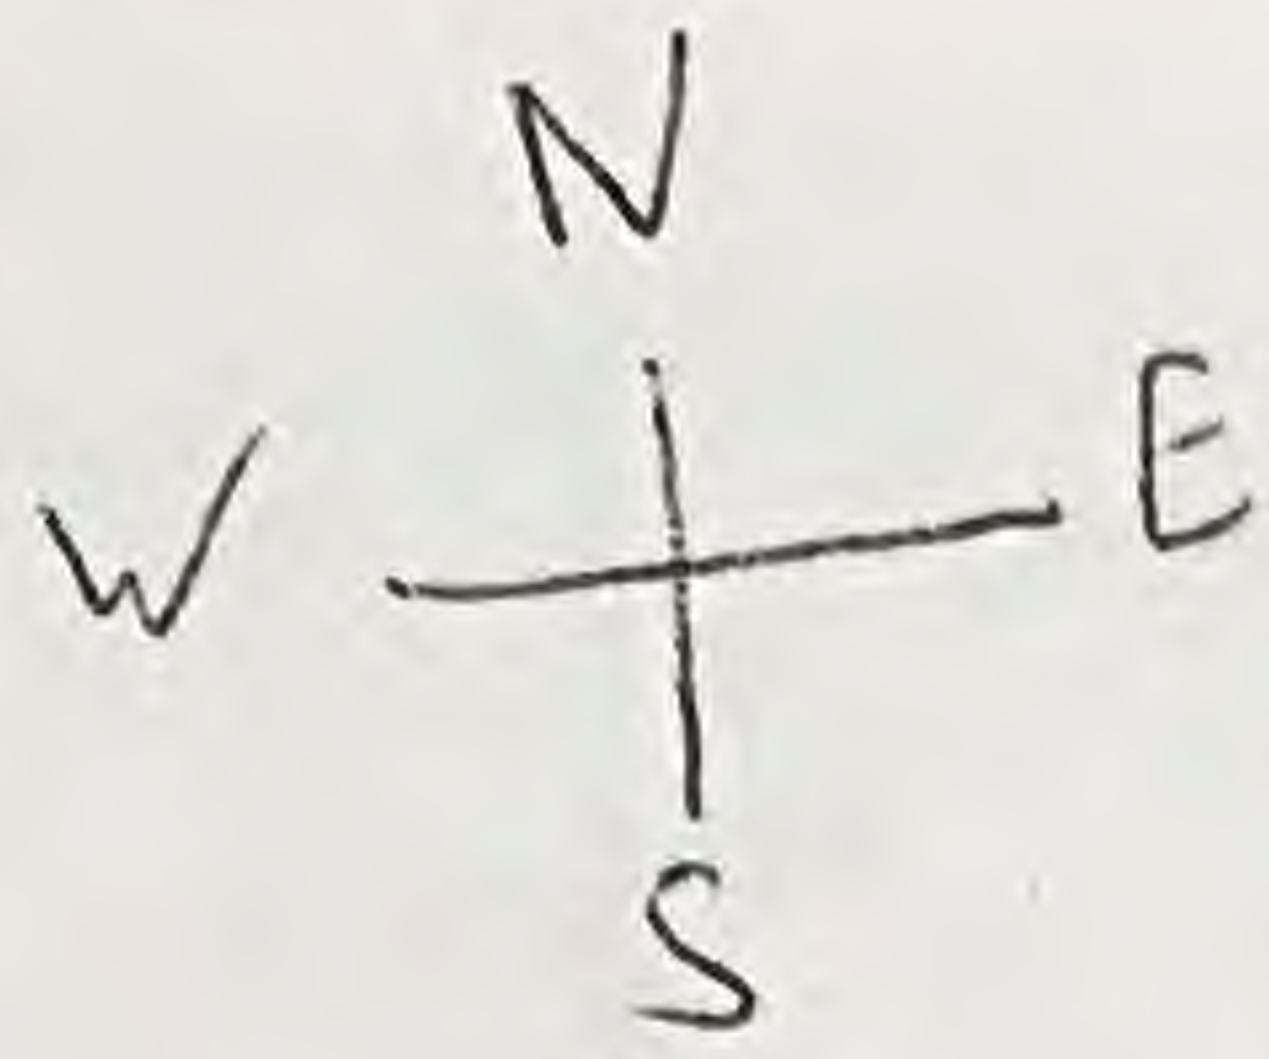

Main Floor

All built in 2000
Copper lines



= Water Source

Junction ~~Auto~~ Sales Buick GMC
12423 Ravenna Rd.
Chardon, OH 44024