


Threaded Galvanized Pipe From well
 LOPPER Pipe installed in 1965 to all
 Sinks and Hose bibs and drinking fountains.

Drinking Fountain — D
 Sink — — — S
 Hose bib — — — H
 well — — — W
 Sample monitoring points — M
 all Tier 1

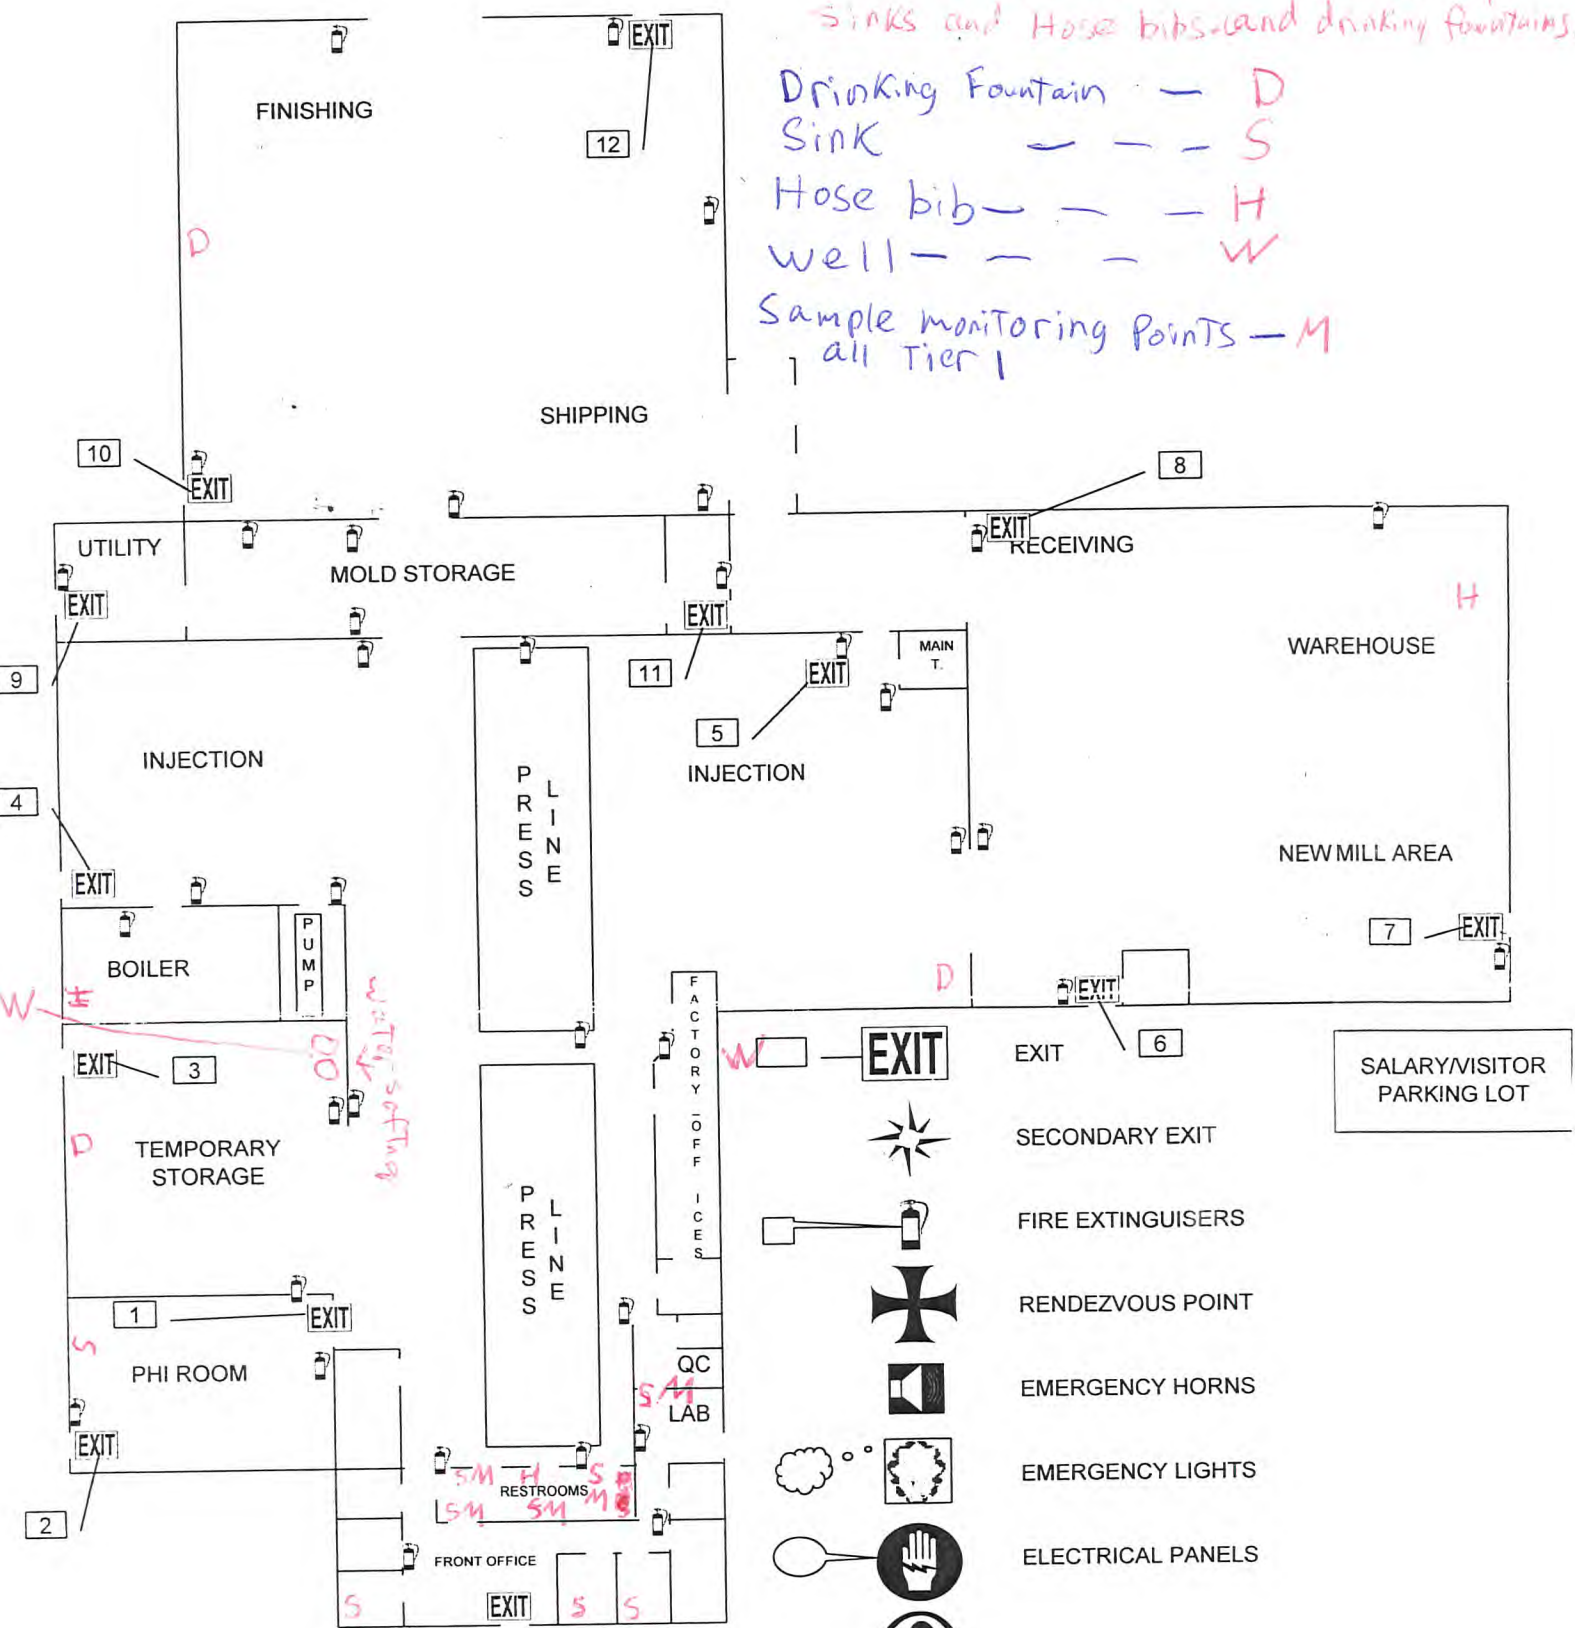

Rubber Associates
 OH 772112