



MARIETTA BIBLE CENTER CHURCH

4070 St. Rt. 60 • Marietta, OH 45750

(740) 373-5551

Myron K. Guiler, Pastor

March 8, 2017

To Whom It May Concern,

The following attachments are sketches and drawings of the water lines for the following businesses/campus.

- Marietta Bible Center Church was built in 1972 and opened its doors in 1973.
- Marietta Bible College opened its doors in September of 1977.
- Marietta Christian School was founded in 1980.

These have been completed to the best of our knowledge. Thank you for your understanding.


God Bless,

Marietta Bible Center Church Staff

RT 60

RT 60

To Highland ridge water and fire hydrant.

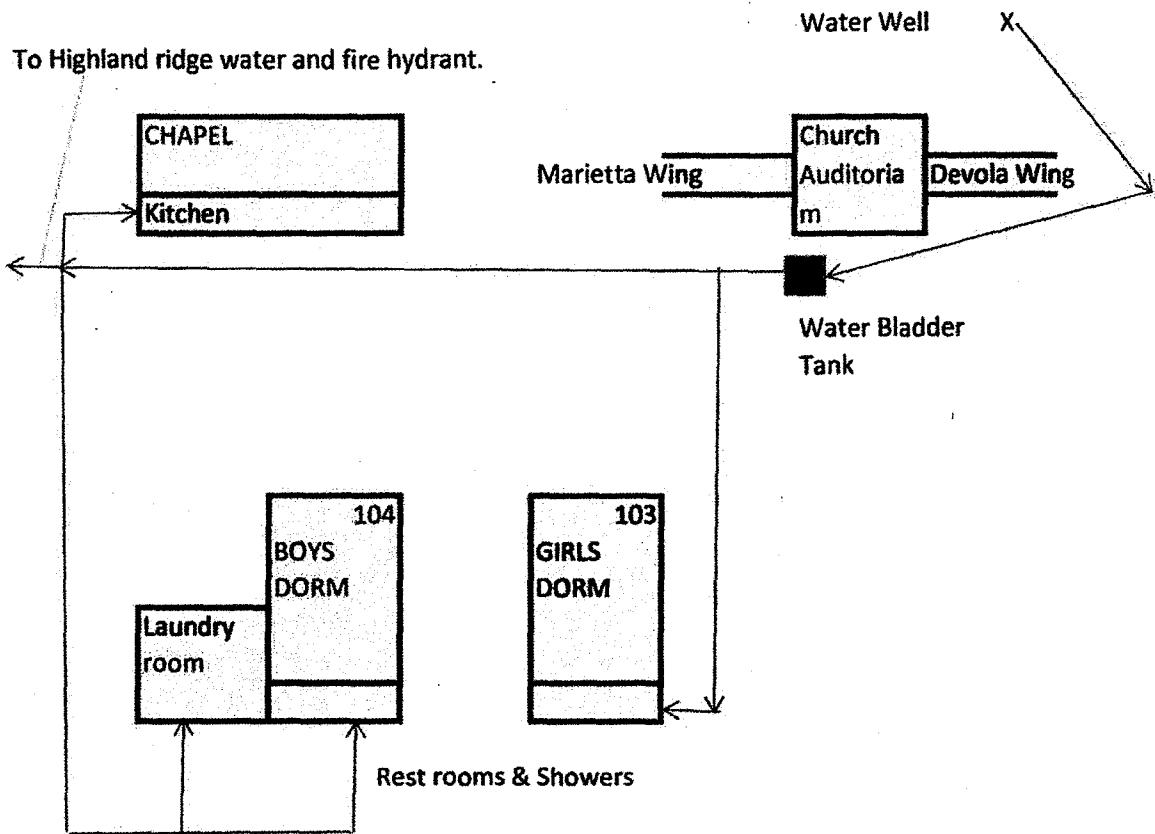


Marietta Bible Center Church
4070 St Rt 60
Marietta Ohio 45750


Marietta Bible Center Church
 4070 St Rt 60
 Marietta Ohio 45750




Sketch not to scale.
 Arrows show water lines and direction of flow.

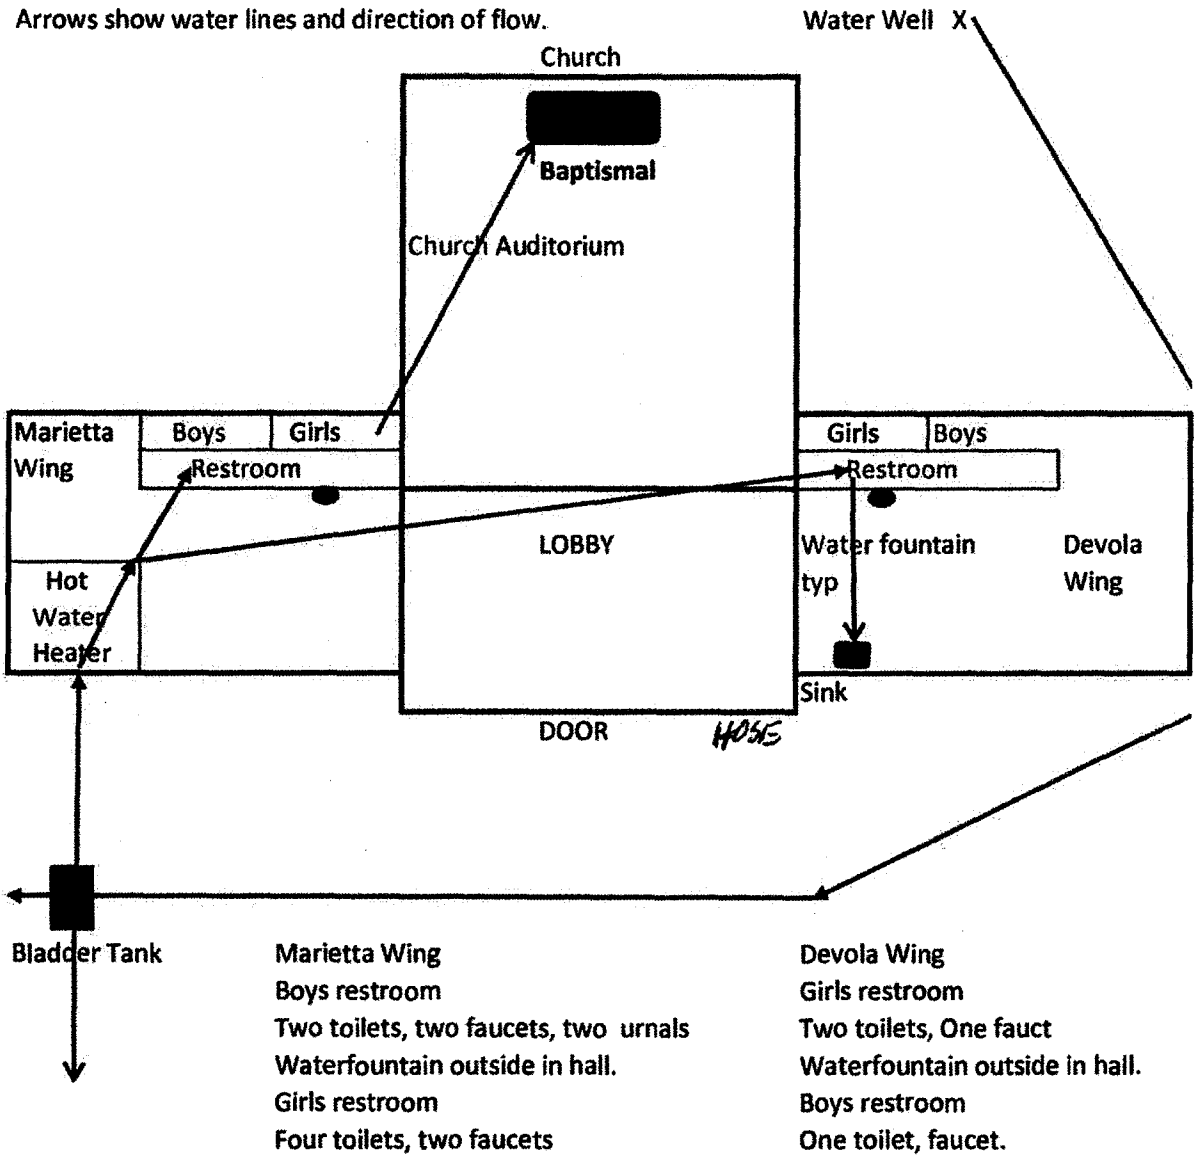


Down Stairs Ladies Dorm

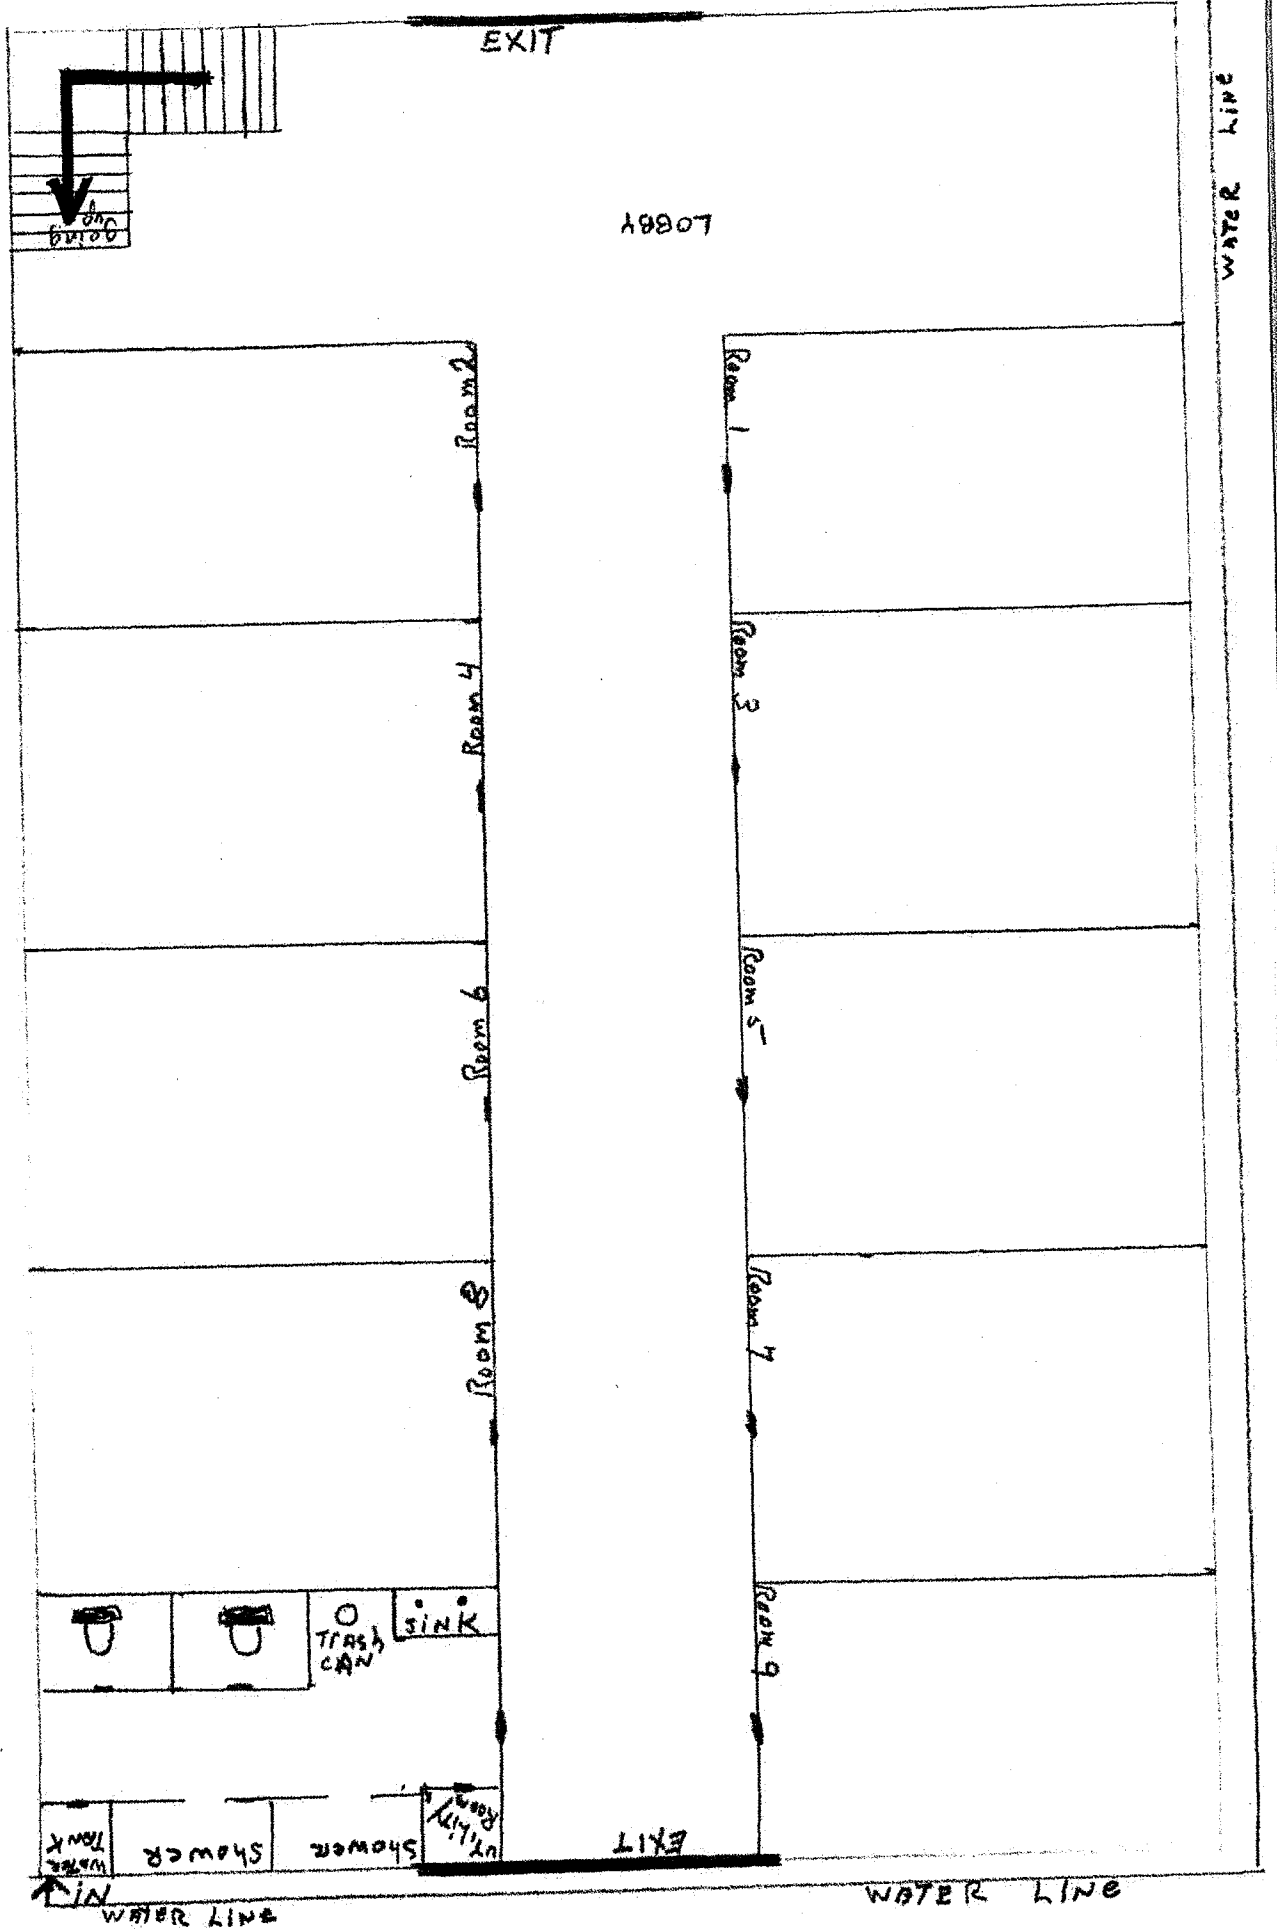

Upstairs Ladies Dorm

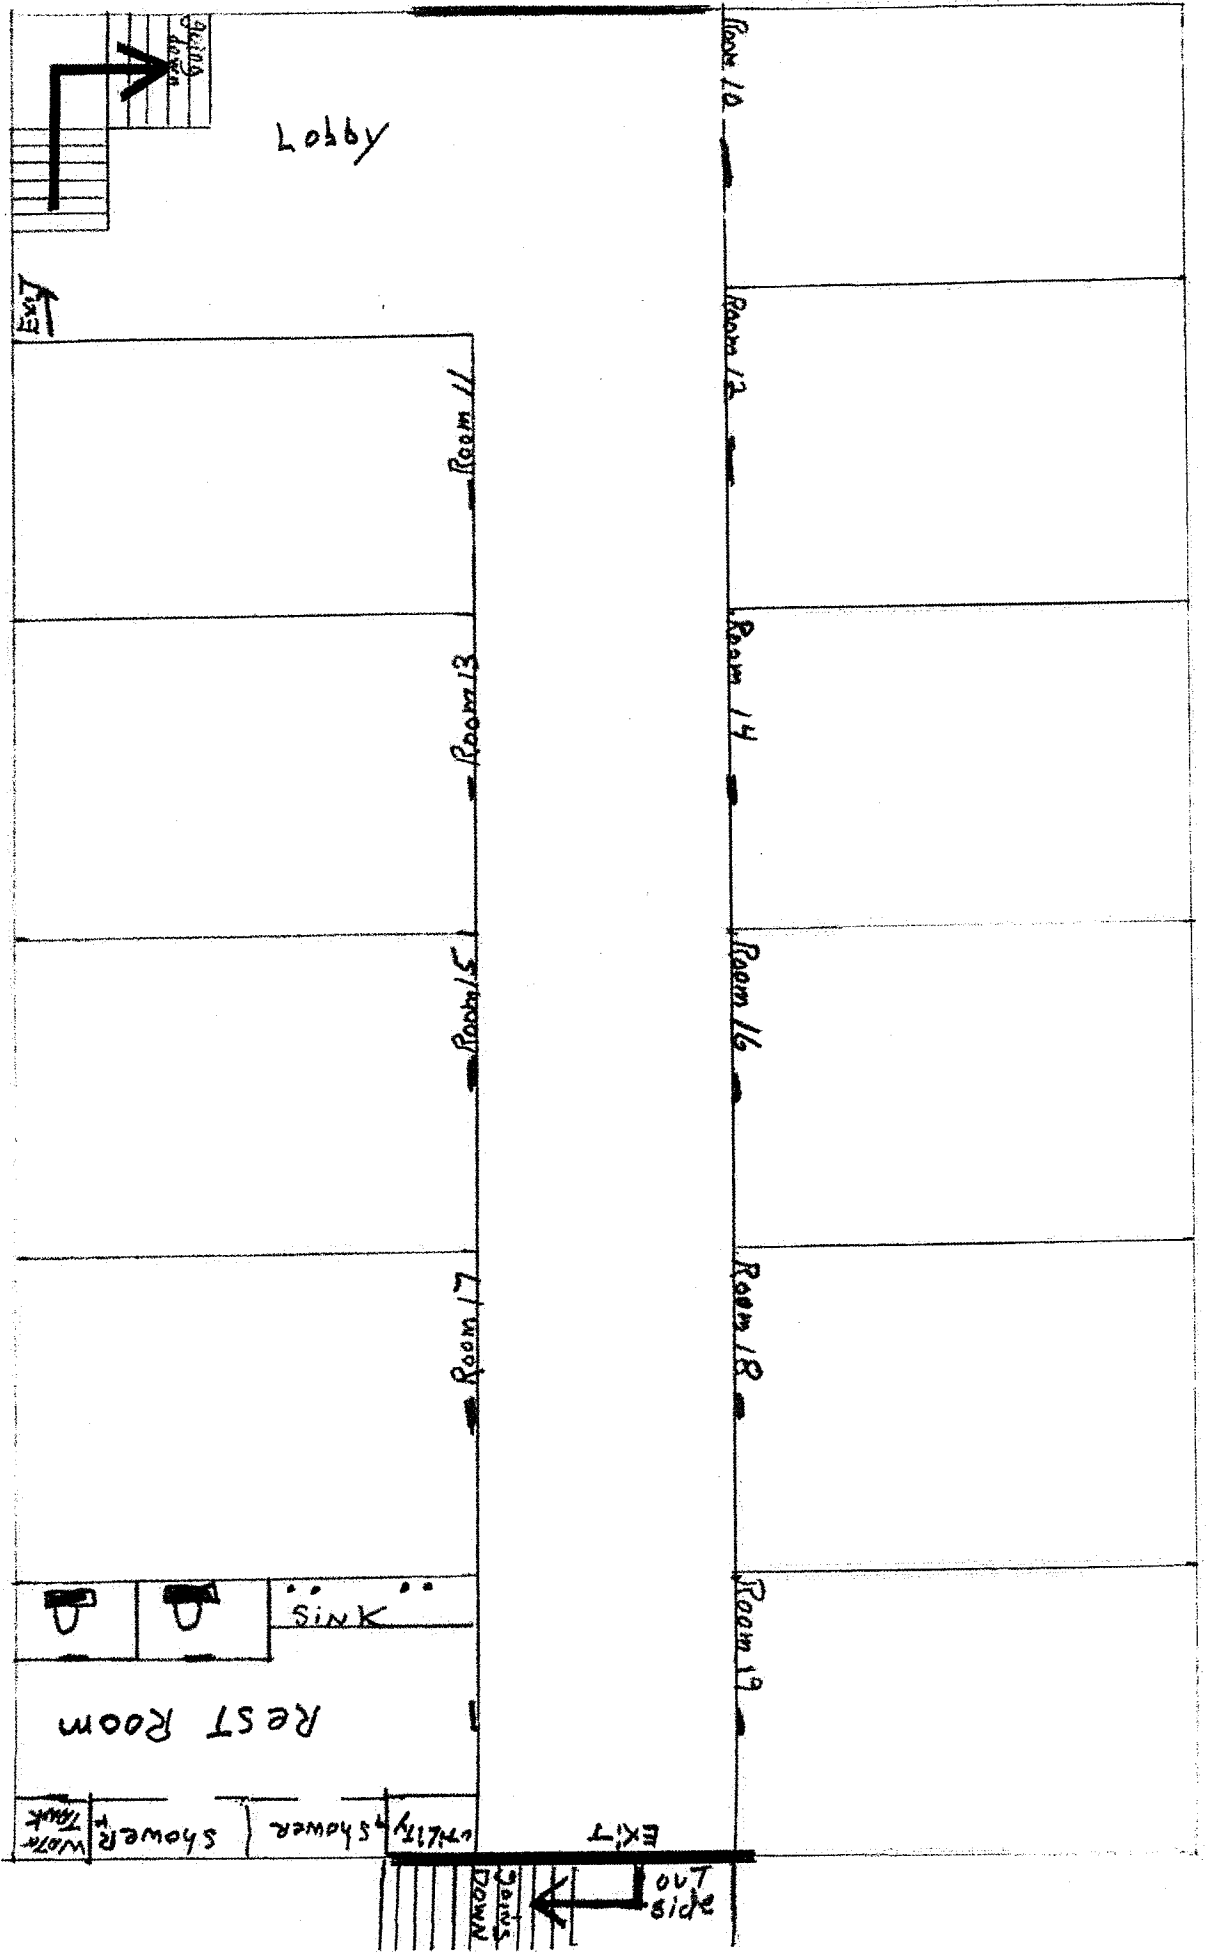


Down Stairs Mens Dorm

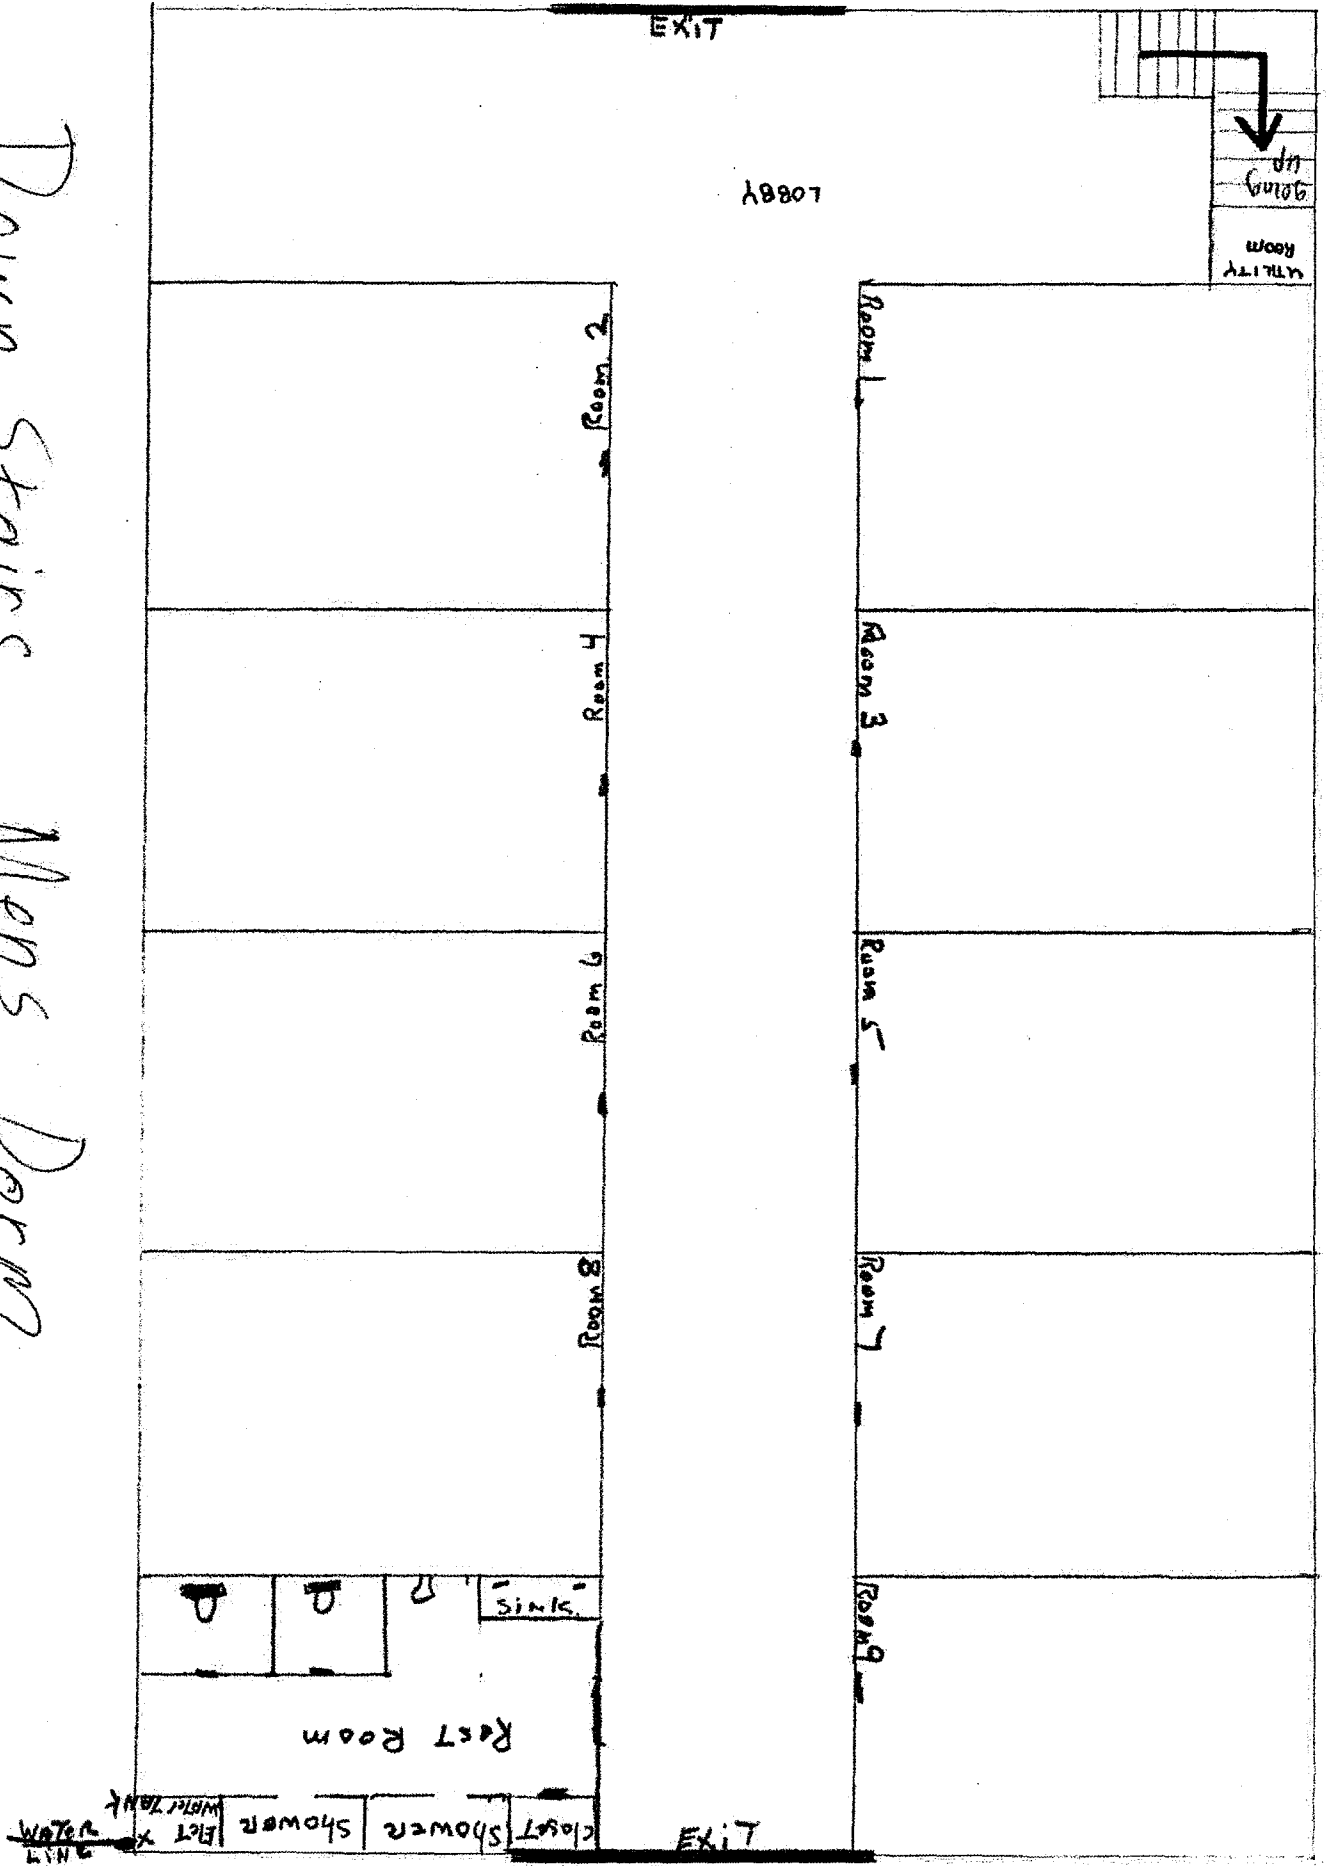

401

Upstairs Mens Dorm

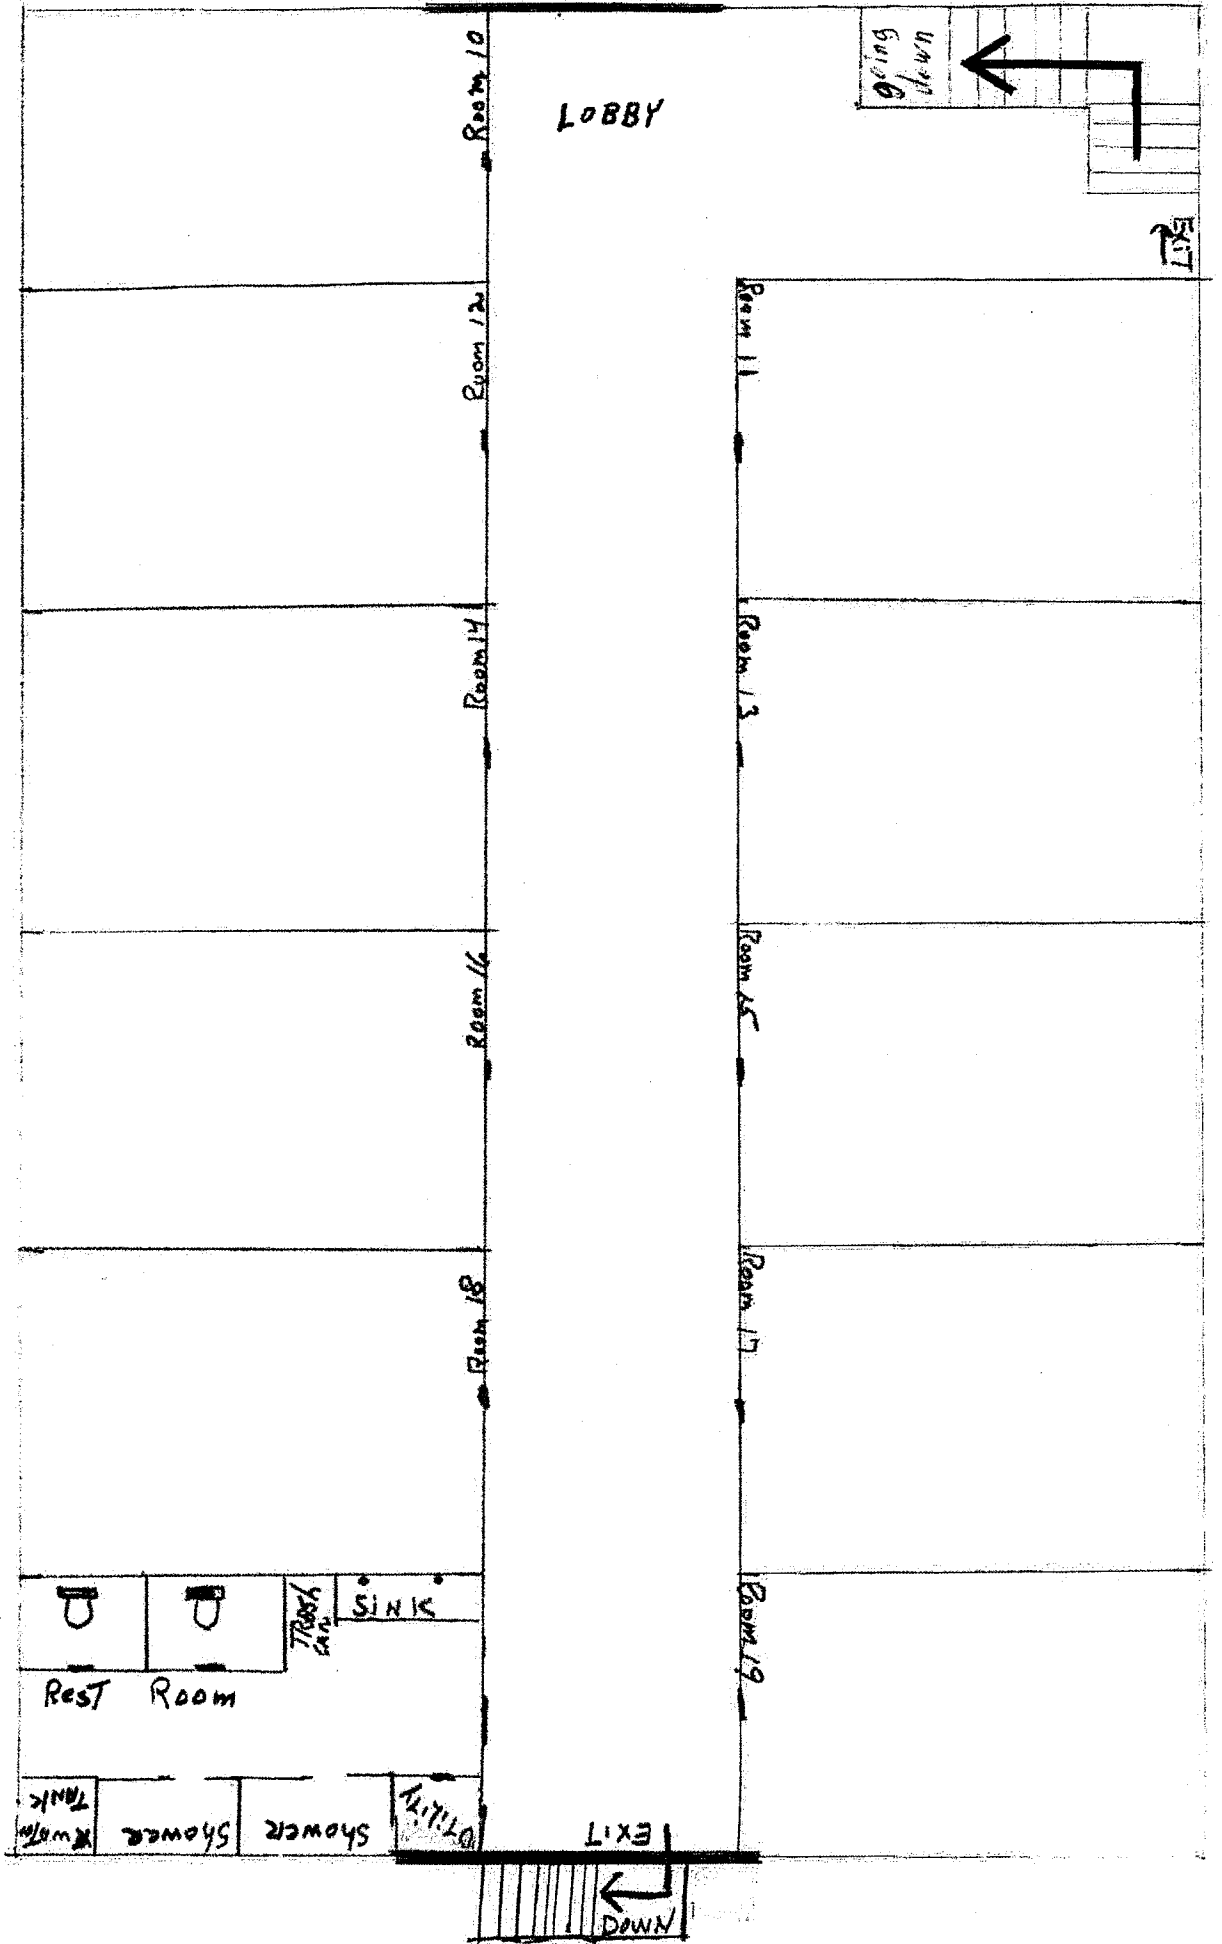


Marietta Bible Center Church
4070 St Rt 60
Marietta Ohio 45750

Water from Bladder Tank

Sketch not to scale.

Arrows show water lines and direction of flow.

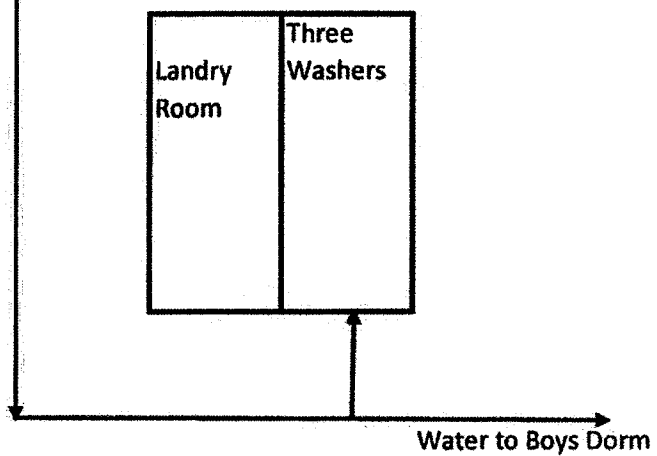



4070 OH-60

Marietta Bible Center Church; Marietta Bible College, 4070 State Route 60, Marietta, OH 45750



Imagery ©2017 Google, Map data ©2017 Google 100 ft