

August 5, 2016

Ohio EPA SEDO
2195 Front St.
Logan, OH 43138

ATTN: Rex Haggy

Re: Warner Lane Estates Violations

This letter is to inform you that that 5 violations noted in the Sanitary Survey of June 8, 2016
Have been corrected

- The feed lot was measured and found to be outside the radius of influence of Well #2.
However, the animals have been relocated.
- The temporary structure nearest the wells has been abandoned and moved.
- The fuel tank has been removed.
- The well cap on well #2 has been tightened and the conduit secured.
- Chemical dosages are being recorded.

Please feel free to contact me with any questions.

Thanks
Steve Parmiter

Operator of Record Warner Lane Estates.

Warner Lane Estates MHP
Muskingum County PWS: OH6002512
Water Distribution System

Public Water System

The Warner Lane Estates Mobile Home Park located in Muskingum County is a mobile home community consisting of 18 trailers and 4 single family homes. The entire system is 2" PVC with plastic service lines. The majority of the mobile homes are older so there some copper plumbing prior to 1986. Most however have either plastic or galvanized plumbing.

Building characteristics

As mentioned above, there are 18 mobile homes and 4 single family homes. Most of the trailers are older so there is possibly some pre-1986 solder used. However, most contain a mixture of plastic and galvanized plumbing.

Attachments

Please find included along with this narrative a map of the facility to the best of our ability, the SMP template and the Verification Form for systems with no lead services.

Contact Information

Operator of Record:


Steve Parmiter

6529 Welsh Rd.

Nashport, OH 43830

740-683-8875

HOPEWELL TWP RD

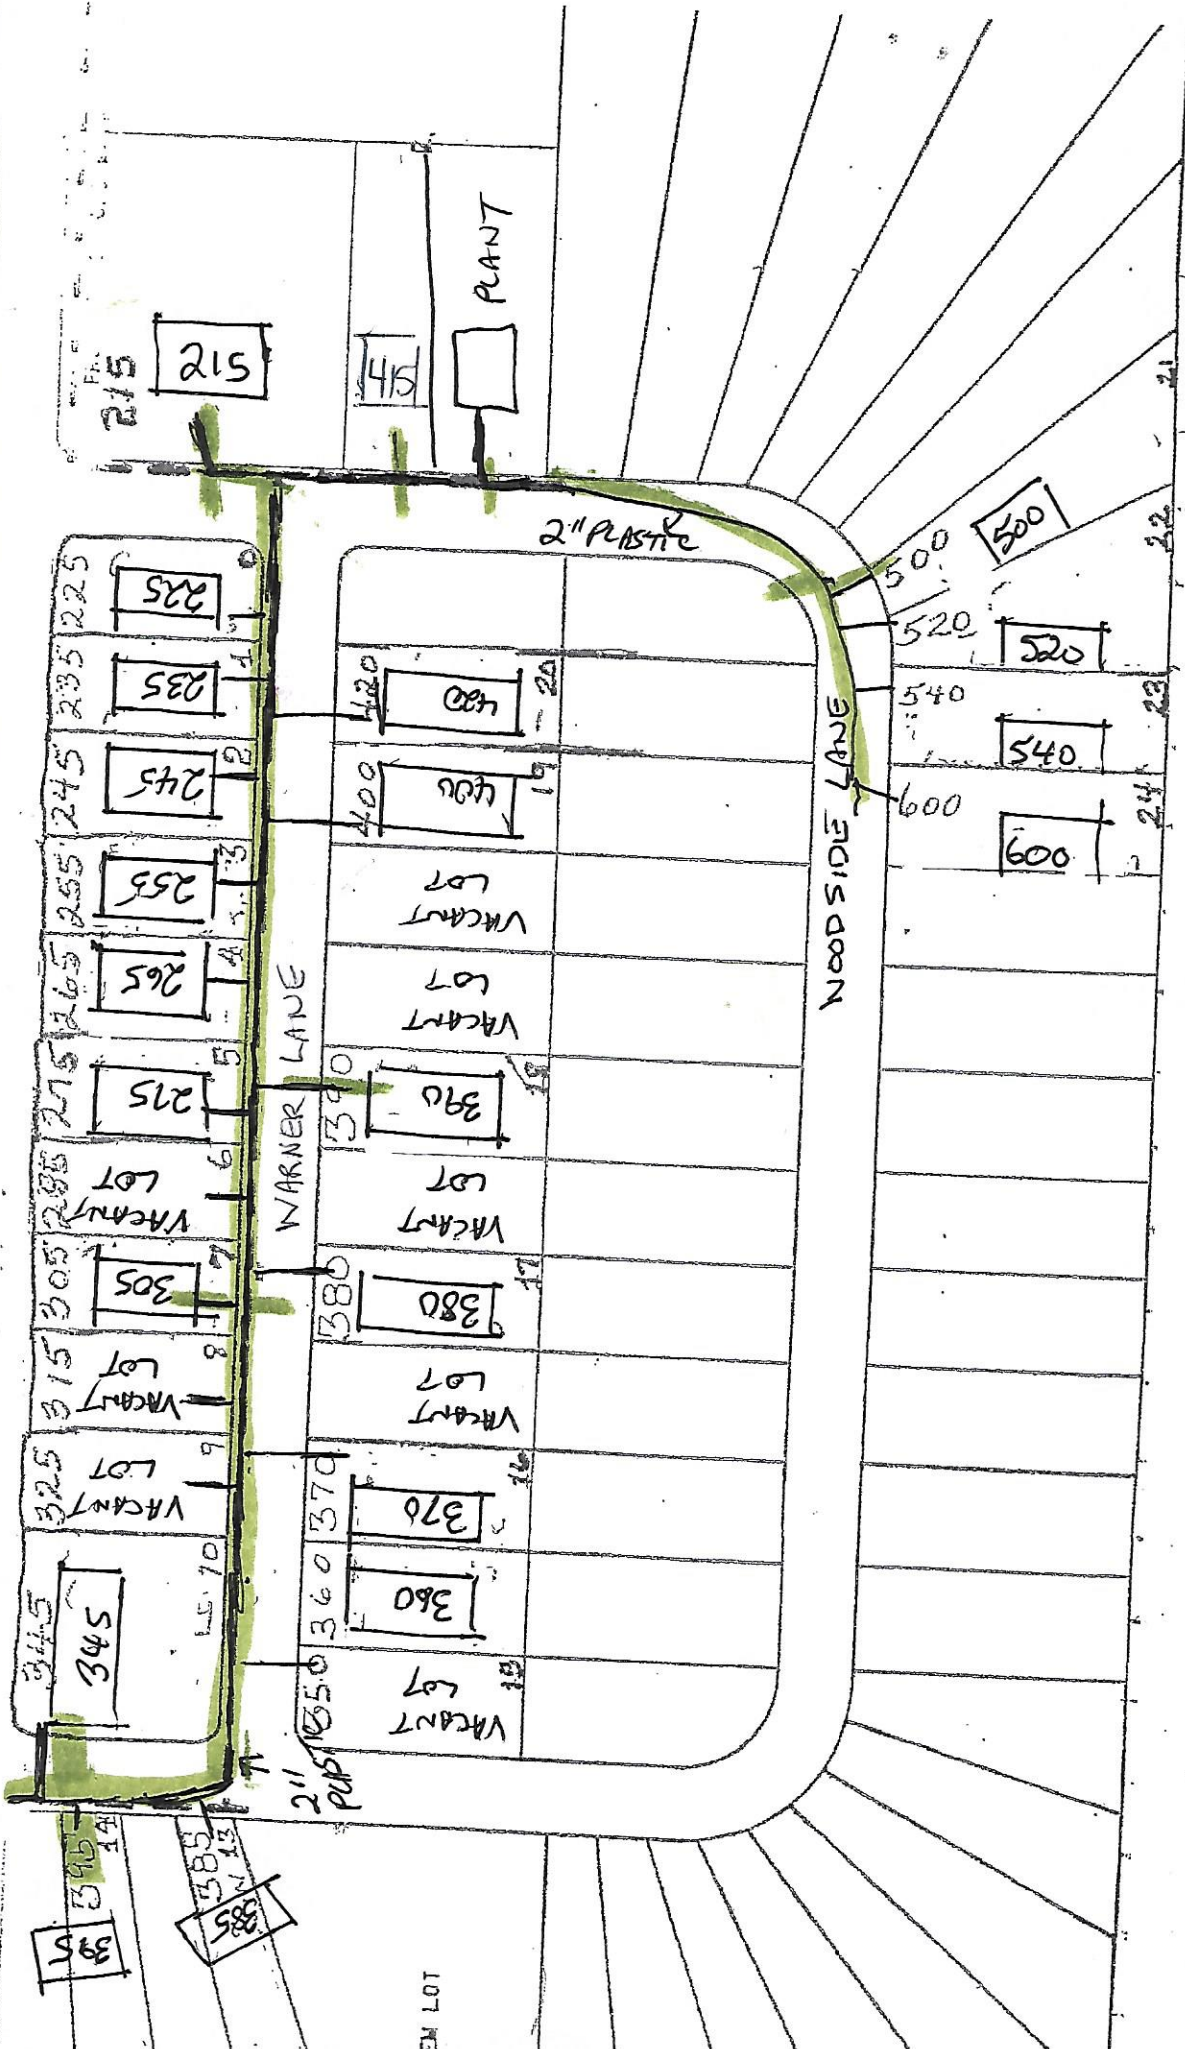

SERVICE LINES 3/4\"/>