



2ND FLOOR

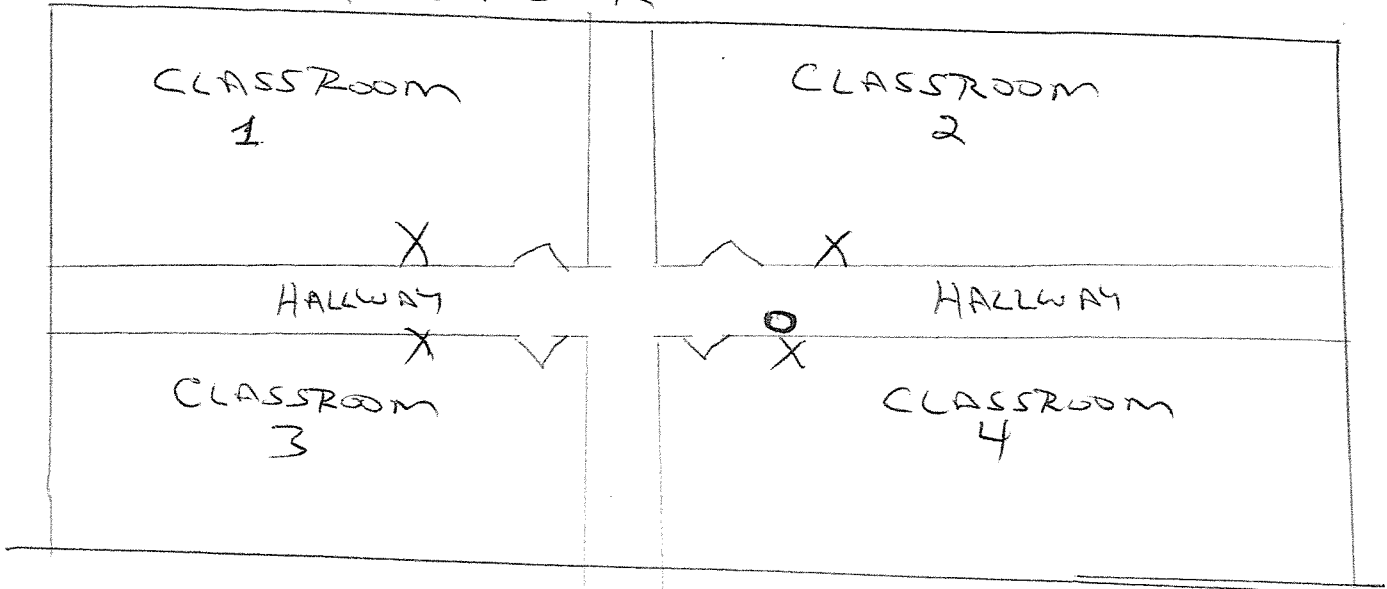

1ST FLOOR

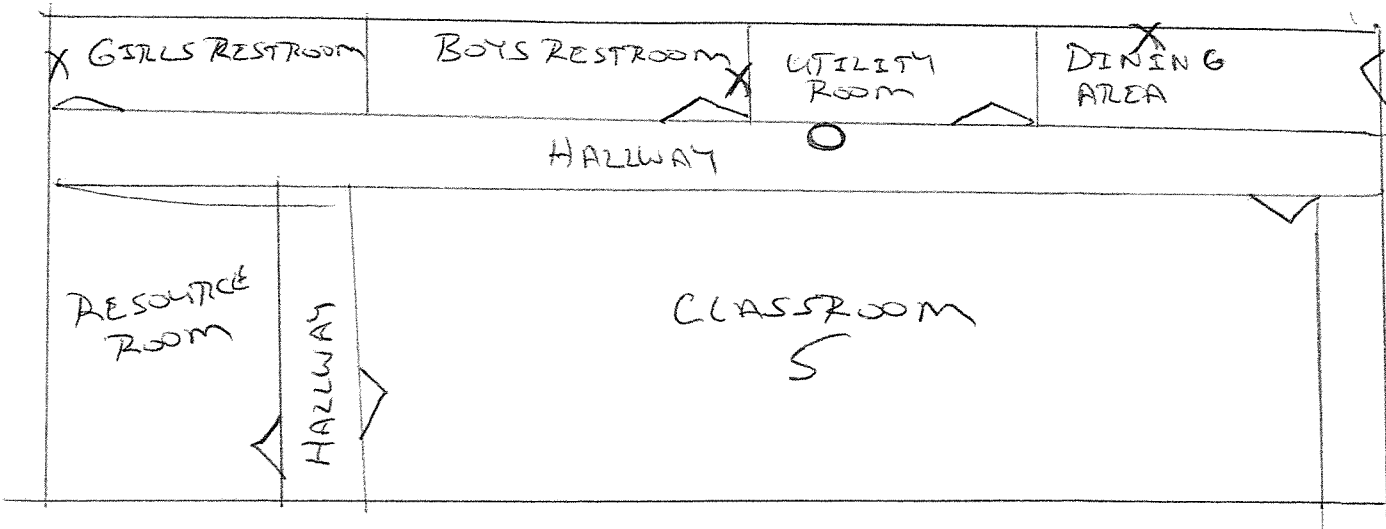

ZION CHRISTIAN SCHOOL PWS ID# 3839412 TEER 1

BUILT PRE 1980 PLUMBING MATERIAL COPPER W/LEAD SOLDER

SAMPLE MONITORING PLAN

- ① LC201 BOYS RESTROOM
- ② LC202 GIRLS RESTROOM
- ③ LC203 CLASSROOM 1
- ④ LC204 CLASSROOM 2
- ⑤ LC205 CLASSROOM 3

LEGEND

X LAVATORY

O DRINKING FOUNTAIN

PWS: OPERATOR

FIRMAN MELLER

330-674-4505

CLASS A #

WSA-1108002-10

Entity: ZION CHRISTIAN SCHOOL
 Doc Type: REPORT
 Doc Subtype: _____
 Program: _____
 County: HOLMES
 Secondary ID: 0143839412

RECEIVED
 MAR 03 2017

BY: