

WARSTLER BROS.

LANDSCAPING, INC.

4125 SALWAY AVE. N.W.

CANTON, OH 44718


330-492-9500

March 7, 2017


To Whom It May Concern,

Enclosed is your lead mapping diagram.

Thank you,

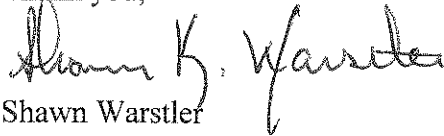
Shawn Warstler

RECEIVED
MAR 09 2017
OHIO EPA NEDO

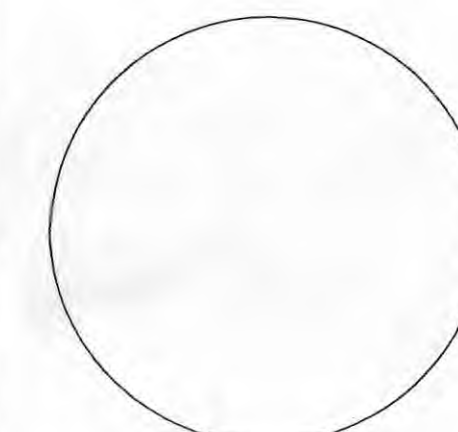[illegible]


NEW ADDITION FOR:
WARSTLER BROTHERS
LANDSCAPING, INC.
4125 Salway NW
Canton, Ohio


PROJECT NUMBER	02-10
PROJECT DATE	10-17-

PARCEL PLAN

2.1a

RECEIVED
MAR 09 2017
OHIO EPA NEDO

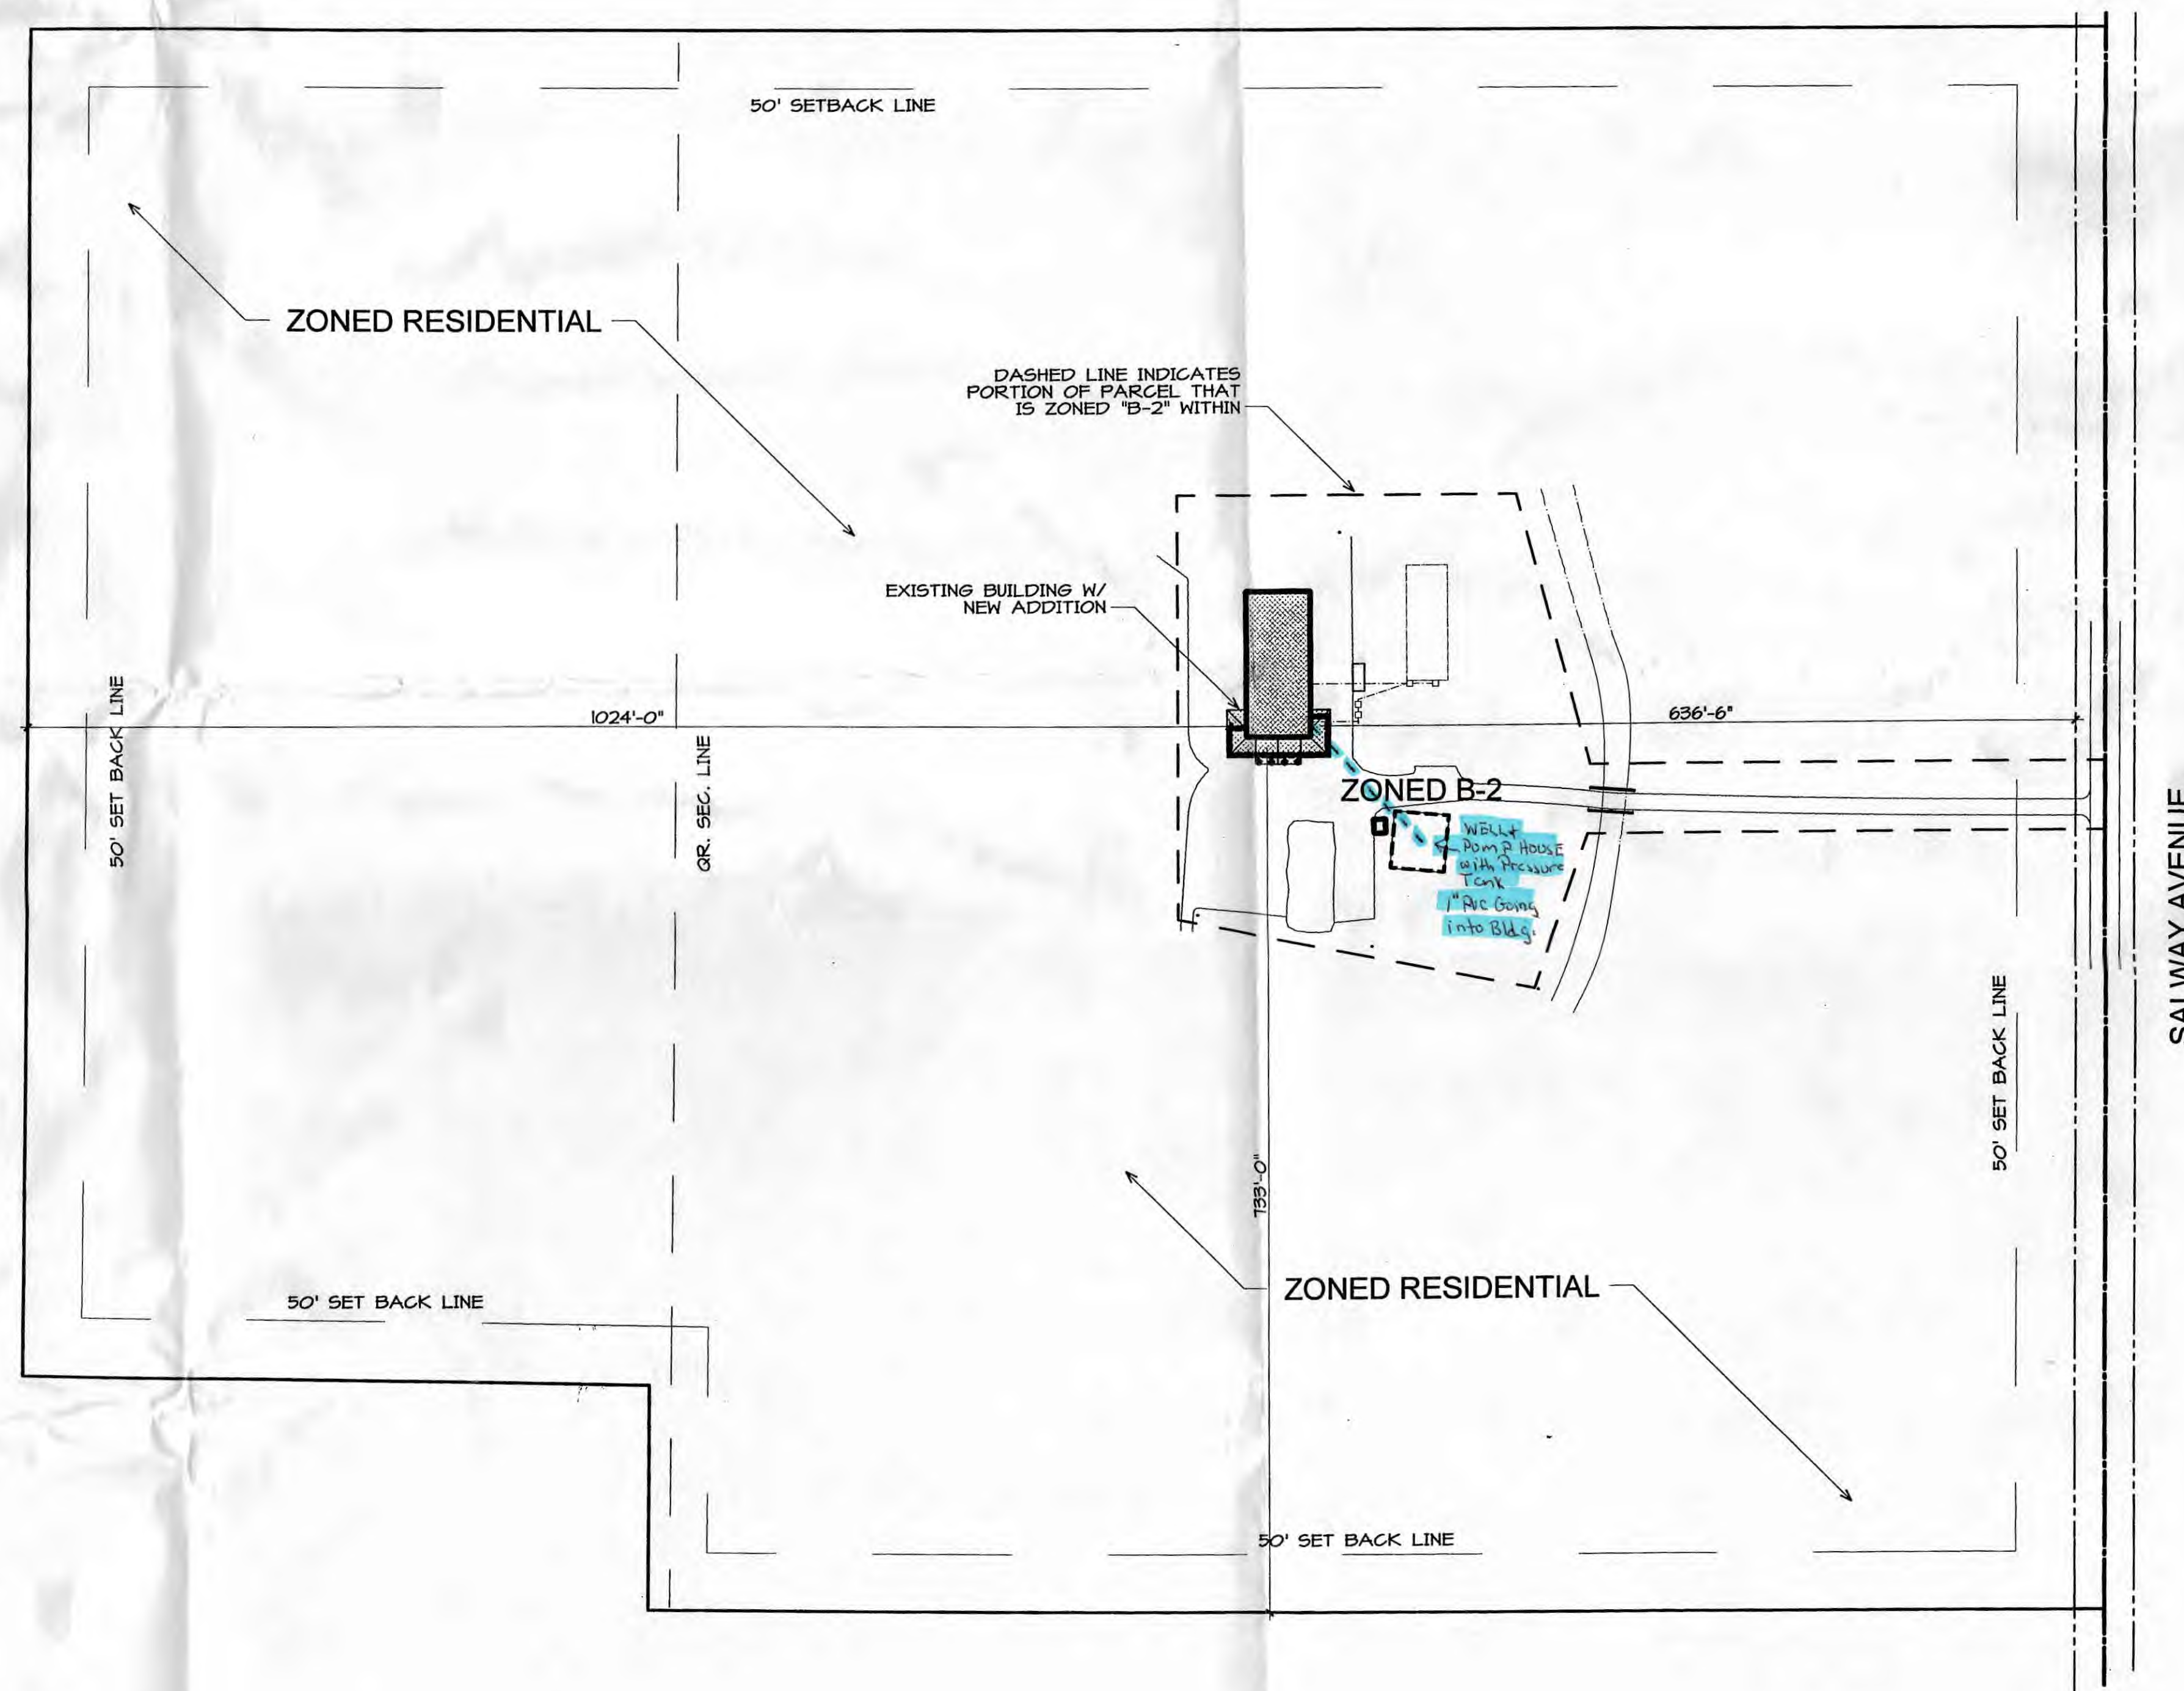 1" = 100'-0"
PARCEL PLAN

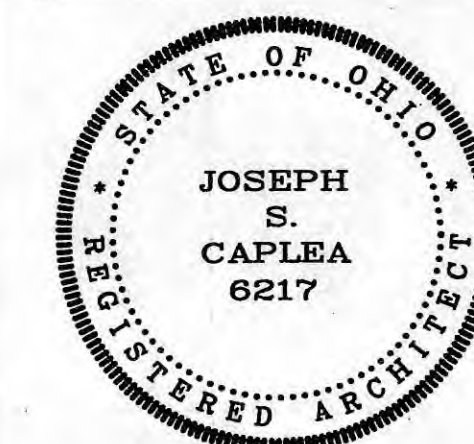

ATTIC VENTILATION REQUIREMENTS					
Soffit Vent:	7.53	square inches per square foot minimum			
Ridge Vent:	16	square inches per lineal foot minimum			
Roof Vents:	61	square inches per unit minimum			
<i>Attic Areas</i>					
Area "A" - Actual Square Footage			715 S.F.		
Total Required Ventilation			2.38 S.F.		
Required Low:	1.20	S.F.	Actual Low:	4.1	S.F. (OK)
Required High:	1.20	S.F.	Actual High:	1.3	S.F. (OK)
Area "B" - Actual Square Footage			525 S.F.		
Total Required Ventilation			1.75 S.F.		
Required Low:	0.88	S.F.	Actual Low:	3.4	S.F. (OK)
Required High:	0.88	S.F.	Actual High:	1.3	S.F. (OK)

[illegible]

NEW ADDITION FOR:
WARSTLER BROTHERS
LANDSCAPING, INC.

PROJECT NUMBER	02-1
----------------	------

PROJECT DATE	10-17-
--------------	--------

**MEZZANINE
FLOOR PLAN**

4.2



 1/4" = 1'-0" **MEZZANINE FLOOR PLAN**

ROOM FINISH SCHEDULE

(-)

UNPAINTED

(U)

SEALED

(S)

SEE REMARKS

(9)

NUMBER REFERS TO COLOR SCHEDULE - IF NO NUMBER IS SHOWN, COLOR HAS NOT YET BEEN SELECTED.

NO SELECTION REQUIRED

FLOORS

BASES

WALLS

CEILINGS

MISC.

SPACE

EXISTING

CONC. SEALED

V.C.T. - (SLIP-RESISTANT)

EXISTING

4" WOOD BASE

4" VINYL COVERED

EXISTING

DRYWALL PAINTED

O.S.B. SHEATHING

EXISTING

DRYWALL, TEX. KNOCK-DN

No.

NAME

100

RECEPTION

101

CUSTOMER CONFERENCE

102

STAIR (EXISTING)

103

FURNACE ROOM

104

NEW LUNCH ROOM

105

EXISTING BREAK ROOM

106

EXISTING MEN

107

OPERATIONS MANAGER

108

EXISTING TOOL STORAGE

109

EXISTING FURNACE ROOM

110

NEW TOOL STORAGE

ROOM FINISH SCHEDULE

Amounts, dimensions, etc., shown in schedules are for convenience in bidding only. All final amounts, dimensions, etc., shown on plans, elevations, sections, etc., are the responsibility of the successful supplier, sub-contractor or prime contractor.		☐ NO SELECTION REQUIRED ☐ UNPAINTED ☐ SEALED ☒ SEE REMARKS ☐ NUMBER REFERS TO COLOR SCHEDULE - IF NO NUMBER IS SHOWN, COLOR HAS NOT YET BEEN SELECTED.		FLOORS	BASES	WALLS	CEILINGS	MISC.	Amounts, dimensions, etc., shown in schedules are for convenience in bidding only. All final amounts, dimensions, etc., shown on plans, elevations, sections, etc., are the responsibility of the successful supplier, sub-contractor or prime contractor.
		SPACE		EXISTING NEW CARPET	EXISTING 4" WOOD, STAINED	EXISTING DRYWALL PAINTED	EXISTING DRYWALL, TEX. KNOCK-DN		
REMARKS	No.	NAME							REMARKS
	M01	OPEN OFFICE	1		1		1		
	M02	EXISTING WOMEN	1		1		1		
	M03	OFFICE	1		1	*	1	*	* MATCH EXISTING
	M04	OFFICE			1		1		
	M05	OFFICE			1		1		
* MATCH EXISTING	M06	OFFICE			1		1		
	M07	EXISTING OFFICE	1		1		1		
* MATCH EXISTING	M08	EXISTING OFFICE	1		1		1		

er Bros\4.2 (02108).aec

#	Date	Revision


NEW ADDITION FOR:
WARSTLER BROTHERS
LANDSCAPING, INC.
Canton, Ohio
4125 Salway NW

PROJECT NUMBER 02-108

PROJECT DATE 10-11-04

GROUND FLOOR PLAN

4.1

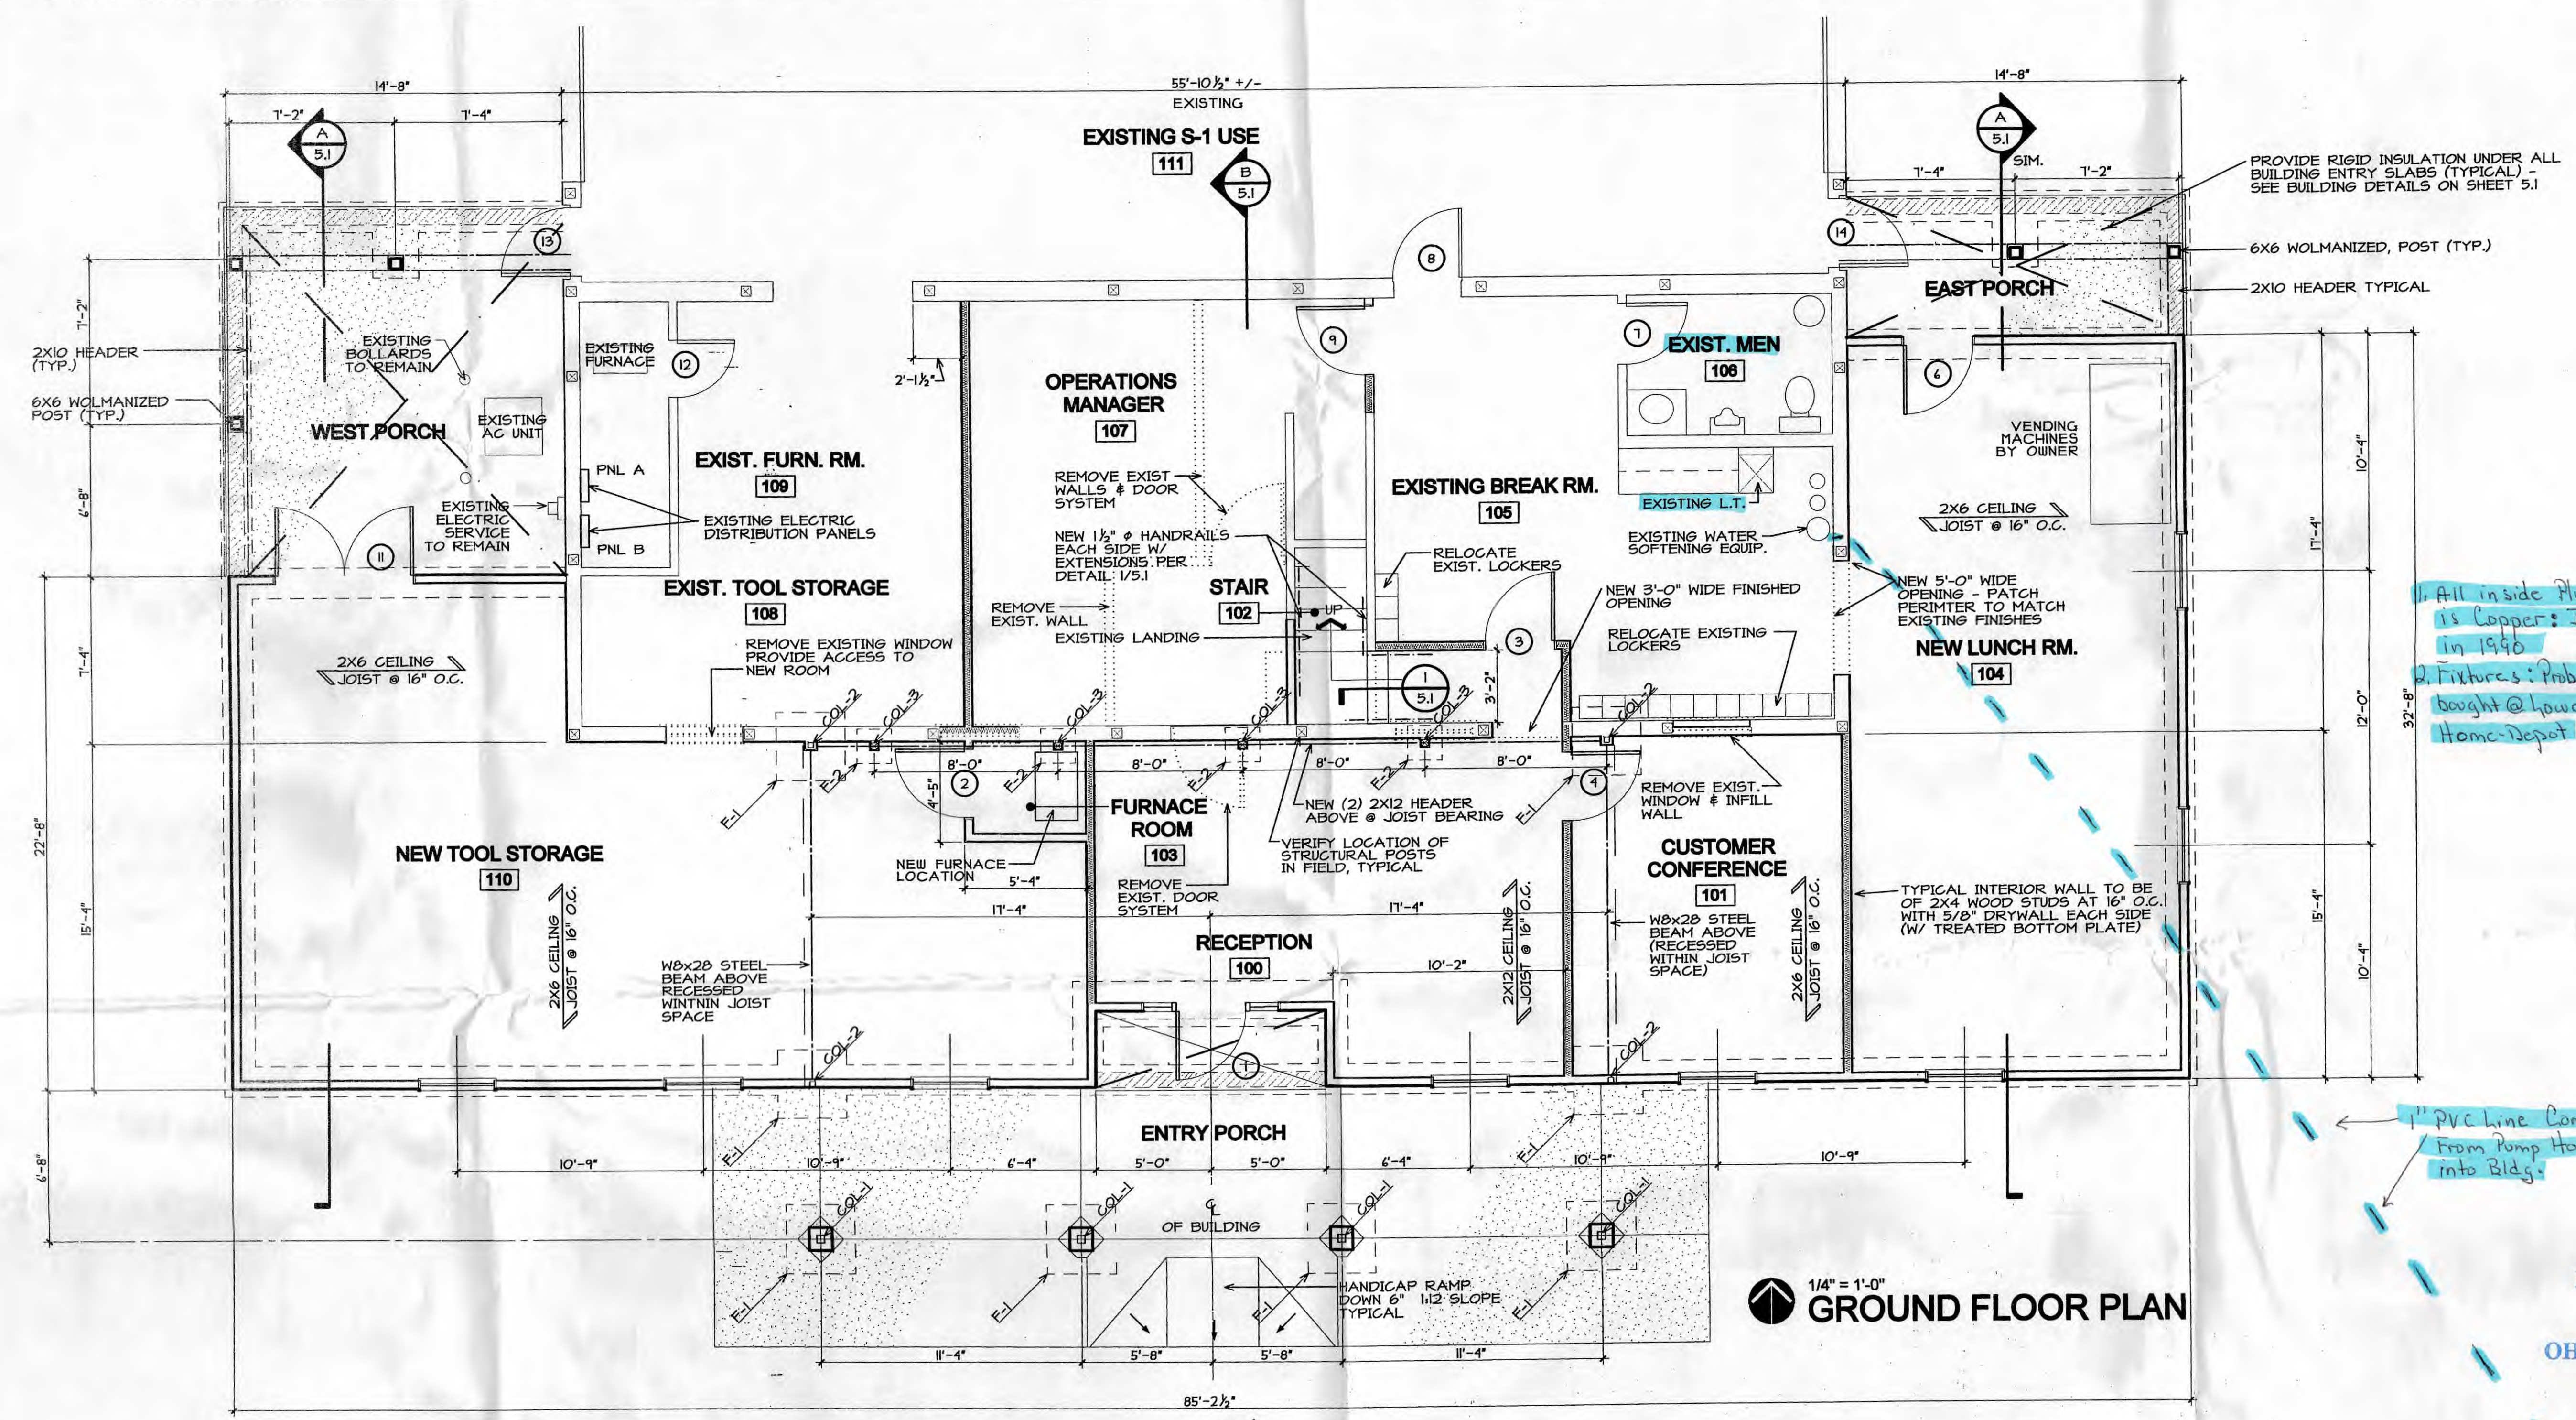

1/4" = 1'-0"
GROUND FLOOR PLAN

All inside Plumbing
is Copper. In stalled
in 1996.
2. Fixtures: Probably
bought @ Lowes or
Home Depot.

1" PVC line coming
from Pump House
into Bldg.

RECEIVED
MAR 09 2017
OHIO EPLAN

DOOR SCHEDULE

Door Number	New	Existing	DOORS			FRAMES			REMARKS
			Size	Type	Louver	Mat.	Depth	Head	
1	O		3-0	6-8	13/4	1	INSL		1 FIBERGLAS / METAL CLAD SYSTEM
2	O		3-0	6-8	13/8	4	WD		2
3	O		3-0	6-8	13/8	4	WD		3
4	O		3-0	6-8	13/8	4	WD		4
5	O		3-0	6-8	13/8	4	WD		5
6	O		3-0	6-8	13/4	2	INSL		6
7	O		2-8	6-8	5	5			7
8	O		3-0	6-8	5	5			8
9	O		3-0	6-8	13/8	4	WD		9
10	O		3-0	6-8	13/8	4	WD		10
11	O		PAIR 3-0	6-8	13/4	3	HM	5 3/4	11
12	O		3-0	6-8	5	5			12
13	O		3-0	6-8	5	5			13
14	O		3-0	6-8	5	5			14

DOOR SCHEDULE


Door Number	New	Existing	DOORS			FRAMES			REMARKS
			Size	Type	Louver	Mat.	Depth	Head	
M1	O		3-0	6-8	13/8	4	WD		M1
M2	O		3-0	6-8	13/8	4	WD		M2
M3	O		3-0	6-8	13/8	4	WD		M3
M4	O		3-0	6-8	13/8	4	WD		M4
M5	O		2 PAIR 1-6	6-8	13/8	6	WD		M5
M6	O		3-0	6-8	5	5			M6
M7	O		3-0	6-8	5	5			M7
M8	O		2-8	6-8	5	5			M8

HARDWARE SCHEDULE

Hardware Set Number	Panic Hardware	Closer (1 Each Door)	Entrance Lock	Office Lock	Closet Latch	Bath Privacy Lock	Storeroom Lock	Passage Assembly	1 1/2 Pair Butts (Per Door)	Wall/Floor Stop	Threshold	Weather Stripping	REMARKS
1													
2													
3													
4													

HARDWARE NOTES:

1. ALL CLOSERS, THRESHOLDS, WEATHERSTRIPPING AND LEVER HANDLES SHALL BE APPROVED FOR HANDICAP USE.
2. VERIFY ALL HARDWARE REQUIREMENTS WITH OWNER PRIOR TO ORDERING.
3. PROVIDE SOLID BLOCKING WIN DOOR FOR CLOSERS AND OTHER HARDWARE.

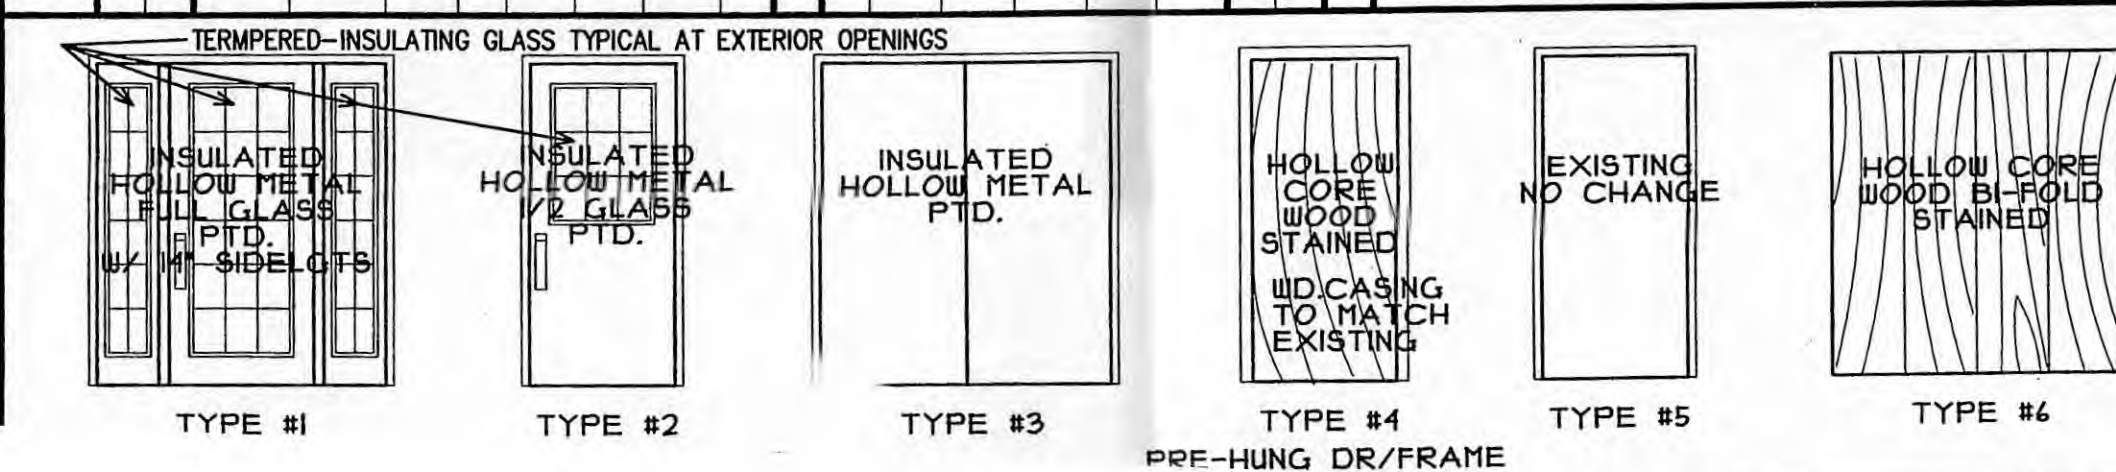

1/12/2005 at 8:16 PM by @User_1