

RE: GH & A-BRICK RECLAMATION
YARD

Report
Drinking Water Program
Fulton County
PWS ID: OH2637913



RECEIVED

MAR 07 2017

DDAGW - NWDO

March 7, 2017

Ohio Environmental Protection Agency
Northwest District Office
Division of Drinking and Ground Waters
347 N Dunbridge Rd
Bowling Green, OH 43402

Ohio Department of Health (ODH)
Attn: Lead Program, 6th Floor
246 North High Street
Columbus, OH 43215

Ohio Department of Job and Family Services (ODJFS)
Office of Family Assistance – Bureau of Child Care Licensing and Monitoring
P.O. Box 183204
Columbus, OH 43218-3204

Re: Mapping Lead Plumbing and Fixtures
PWS ID: OH2637913


Dear Sir/Madam:

Please find enclosed the lead plumbing and fixtures maps for Glenn Hunter & Associates (GH&A) located at 1286 County Road #6 Delta, Ohio.

Also enclosed is the Verification Claiming No lead Service Lines. The well and its associated components were installed in 2009. The well services two rental office/break trailers which were constructed in 1998 (well log and photo of data plate enclosed).

Please contact me by telephone at 419.533.0925 or by e-mail at mturnbull@ghacorp.net, if you have any questions or require additional information.

Kind Regards,

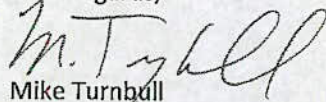
Mike Turnbull
EHS & HR Director

Glenn Hunter & Associates 1222 County Road 6 Delta, Ohio 43515
Tel: (419) 533-0925 Fax: (419) 533-0970



RECEIVED

MAR 07 2017

DDAGW - NWDO

MAPPING AND LEAD PLUMBING NARRATIVE

SOURCE

Glenn Hunter & Associates
1286 County Road #6
Delta, OH 43515

PWS ID: OH2637913

NARRATIVE

The Glenn Hunter & Associates (GH&A) drinking water system is comprised of a single groundwater well and two mobile/office trailers – Break-Room Trailer and Managers Trailer.

The Break-Room Trailer has the following fixtures:

One (1) pressure tank.
Two (2) toilets
One (1) urinal
Two (2) sinks (one in the bathroom area and one in the break room area)
One (1) electric hot water tank

The Manager's Trailer has the following fixtures:

One (1) shower (never used)
One (1) toilet
One (1) sink
One (1) electric hot water tank

There are three (3) sample locations:

1. Break-Room Trailer Bathroom Sink
2. Break-Room Trailer Kitchen Sink
3. Manager's Trailer Bathroom Sink

For sampling, the sample locations had previously and will continue to duplicate/utilize twice, two of the three locations.

A site map showing the trailers, dimensions, and well location is attached.

RECEIVED

MAR 07 2017

DDAGW - NWDO

East

OFFICES

North

South

West

*21 visible

Soldered Joints

Break Trailer
above

all copper lines

pressure tank
and plastic
lines going
under trailer

Electrical storage
tank water heater

count
top sink

Sink

uniflow

air

toilet

Sample
Location

Sample
Location

North

West

East


South

* 28 visible solder joints



Managers
Trailer
above
all copper lines
ran along the wall

Electric Storage
Tank Water Heater

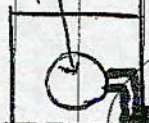

Si

toilet

Slusher
DBAGW - NWDO

MAR 07 2017

RECEIVED

Sample
Location

RECEIVED

MAR 07 2017

DDAGW - NWDO

toilet

urnall

East

* / visible
Solder joint

North

Break Trailer
Under

plastic pipe
with heat tape


Water heater


line comes
out of the ground

goes to pressure tank
and to water heater

South

West

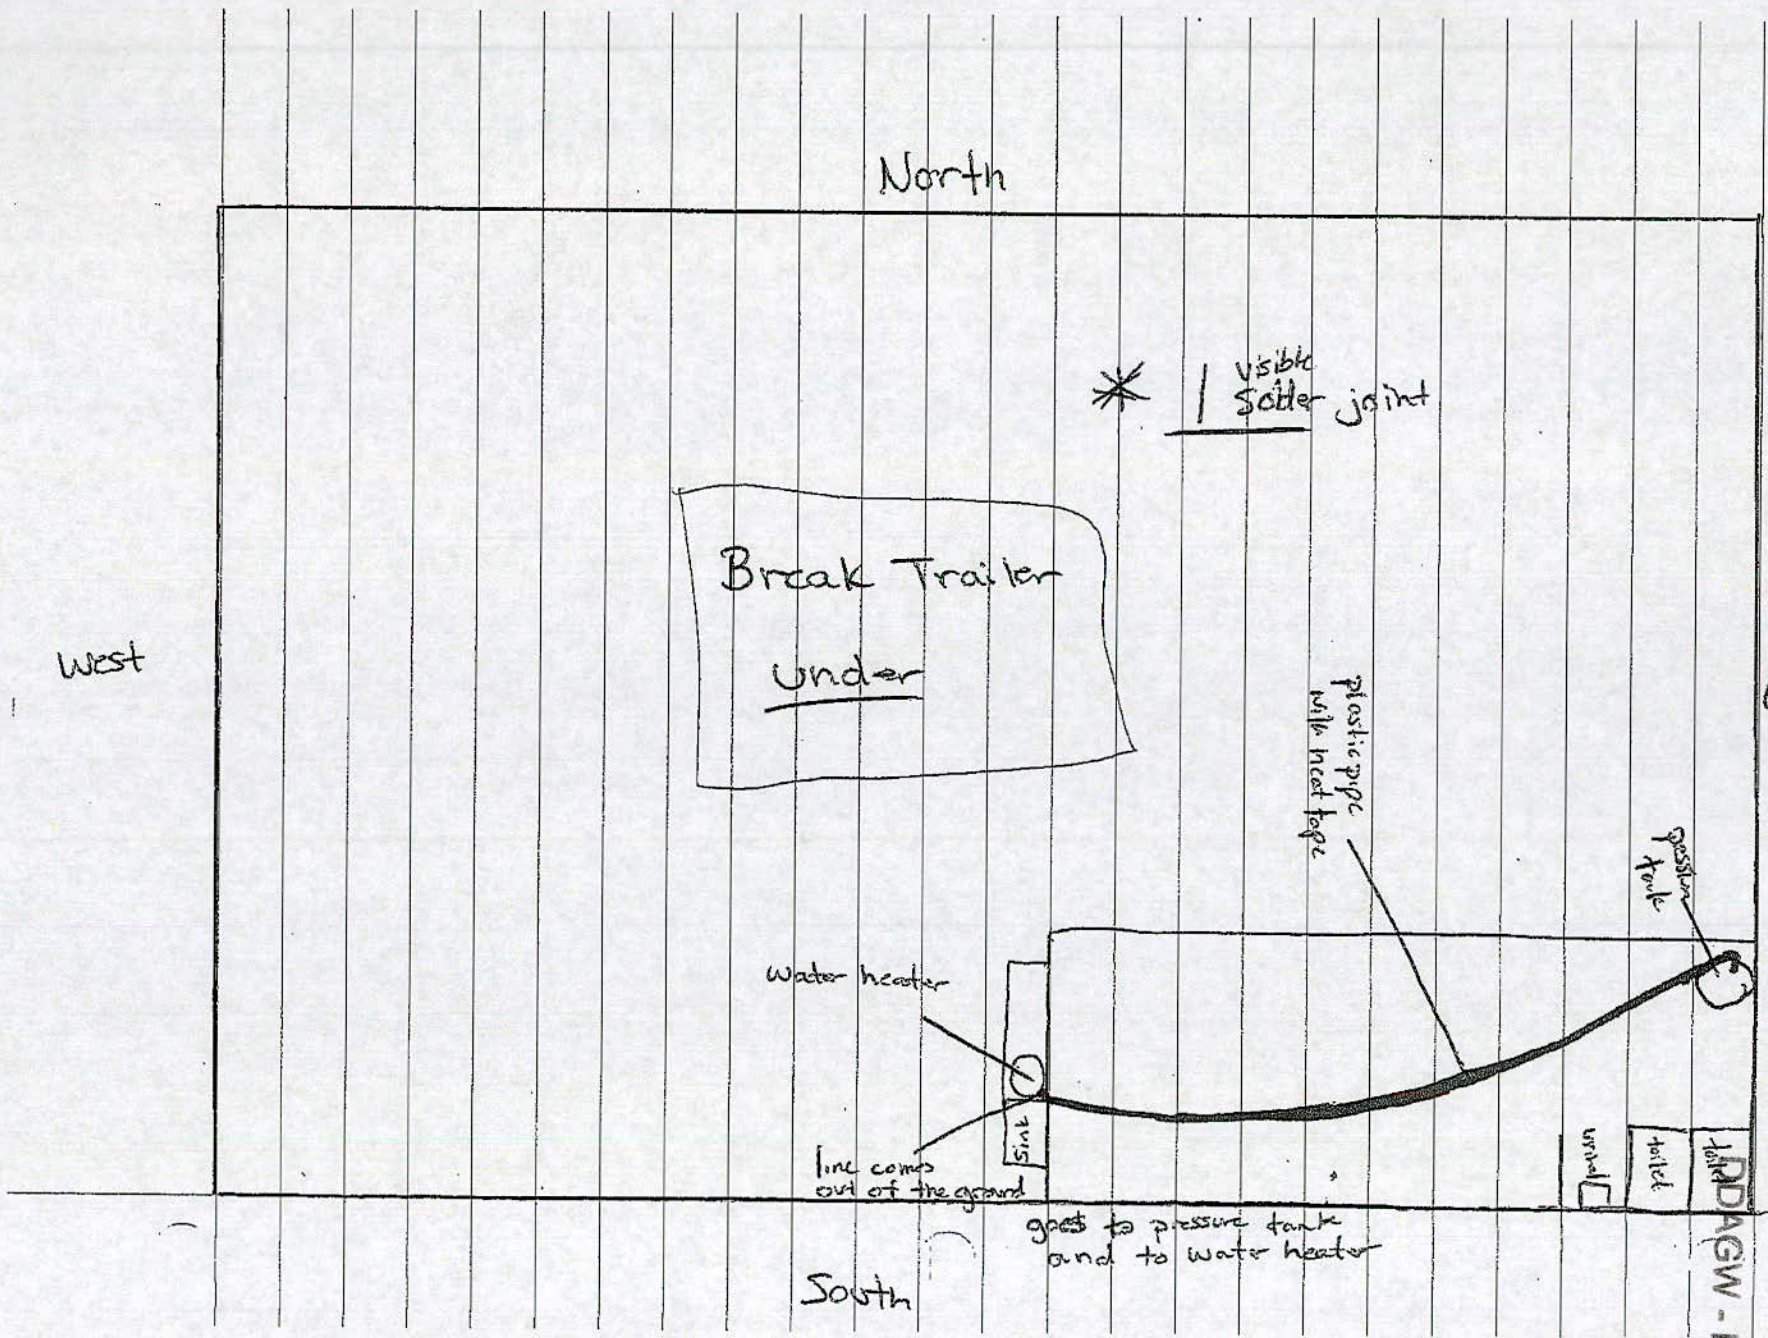

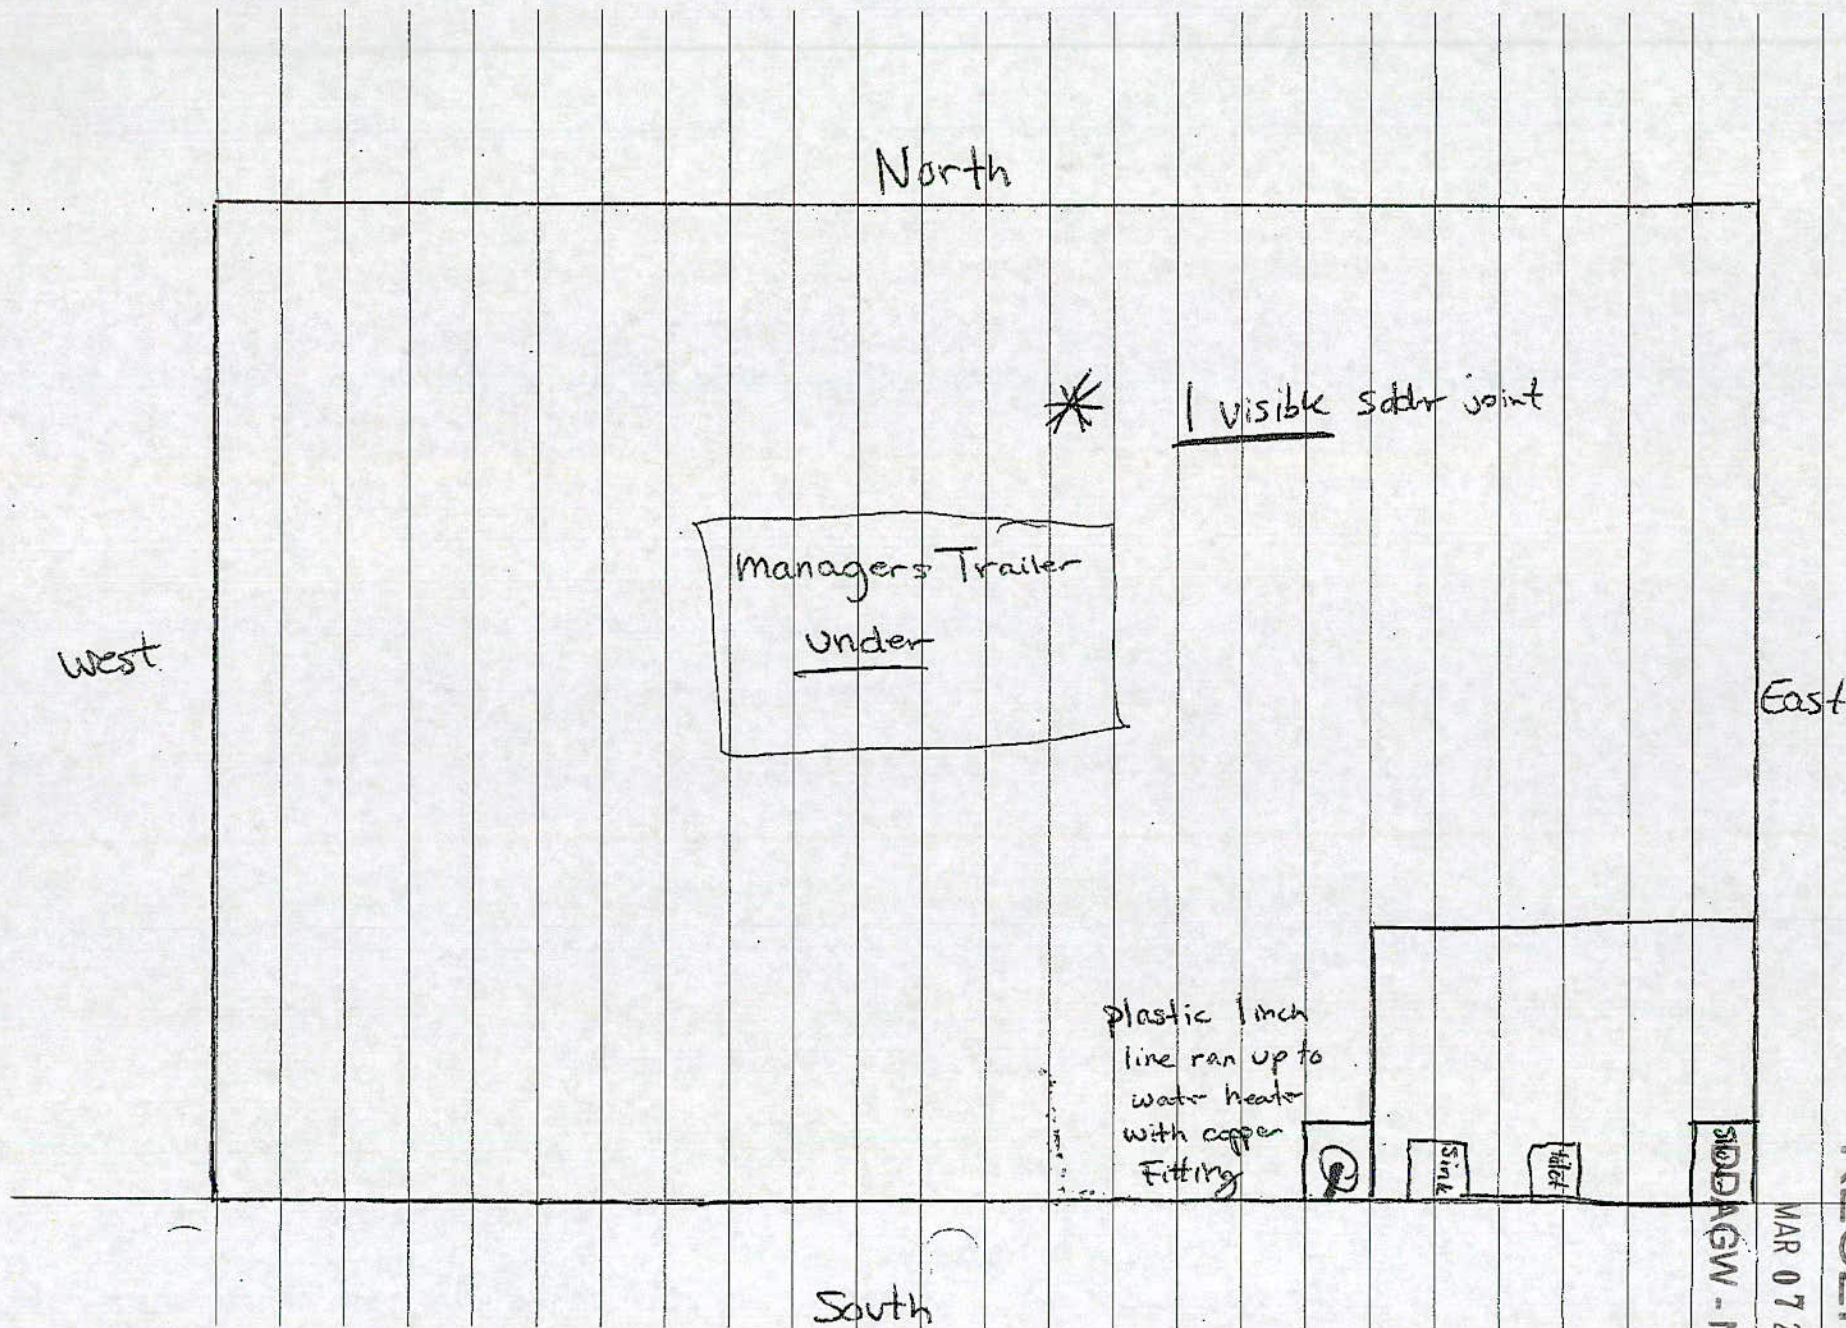

SIDDAAGW - NWDO


MAR 07 2017

RECEIVED

Google Maps

Manager's
Trailer

Break
Trailer

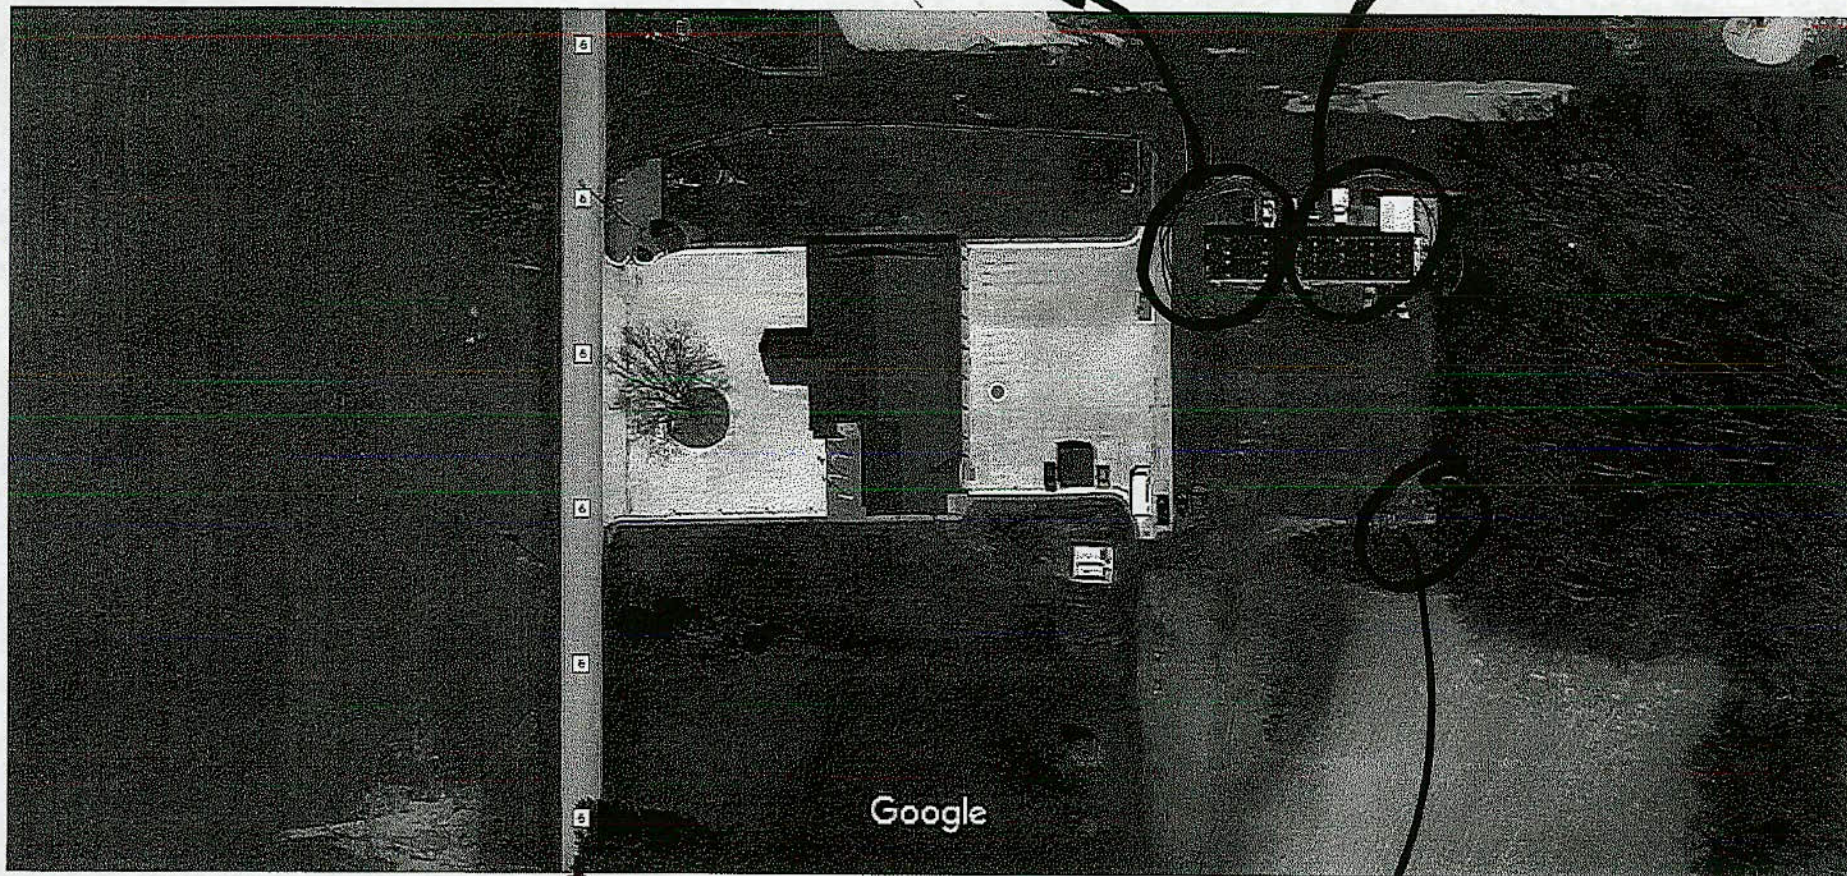

Google

Imagery ©2017 Google Map data ©2017 Google 50 ft

4
N

County
Road #6

Well
Location

RECEIVED

MAR 07 2017

DDAGW - NWDO

MAR 07 2017

Well Log Number

DNR 7802.05e

Ohio Department of Natural Resources
Division of Water, 2045 Morse Road, Columbus, Ohio 43229-6605
Voice (614) 265-6740 Fax (614) 265-6767

2022504

Page 1 of 1 for this record.

[illegible]

Completion of this form is required by section 1521.05, Ohio Revised Code - file within 30 days after completion of drilling.
Distribute copies of this record to Customer, and Local Health Department.



MOBILE FACILITY ENGINEERING, Inc.

306 W. STATE STREET • CASSOPOLIS, MI 49031

PHONE: 616/445-3838

DATA PLATE

Model No. MF2440-C15-98

Serial No. 106302, 106303

Label P-100783, F2-84979

Date 3/24/98

Label P-100782, F2-84980

Date _____

Codes which unit is constructed to:

<input checked="" type="checkbox"/>	<u>1991</u>	Uniform Building Code
<input type="checkbox"/>	<u>1991</u>	Uniform Plumbing Code
<input type="checkbox"/>	<u>1993</u>	Uniform Mechanical Code
<input type="checkbox"/>	<u>1993</u>	BOCA Basic Building Code
<input type="checkbox"/>	<u>1993</u>	BOCA Basic Plumbing Code
<input type="checkbox"/>	<u>1993</u>	BOCA Basic Mechanical Code
<input type="checkbox"/>	<u>1993</u>	National Electric Code
<input type="checkbox"/>		Southern Standard Building Code
<input type="checkbox"/>		Southern Standard Plumbing Code
<input type="checkbox"/>		Southern Standard Mechanical Code
<input type="checkbox"/>		One and Two Family Dwelling Code
<input type="checkbox"/>	<u>ASHRAE 90A ENERGY CODE 1990</u>	
<input type="checkbox"/>	<u>1992 IECC</u>	
<input type="checkbox"/>	<u>1993 IMC/UMC</u>	

RECEIVED

MAR 07 2017

DDAGW - NWDO

Appliances:

	Make & Model	Capacity Rating
Air Conditioner	<u>Calsonic # W4241-200</u>	<u>23,000 BTU COOL</u>
Furnace	<u>Calsonic # W4241-200</u>	<u>34,000 BTU COOL</u>
Water Heater	<u>N/A</u>	
Range	<u>N/A</u>	

**VERIFICATION FORM FOR COMMUNITY PUBLIC WATER SYSTEMS
CLAIMING NO LEAD SERVICE LINES**

The owner or operator of all community public water systems must identify and map areas of their distribution system that are known or are likely to contain lead service lines. Systems must submit a copy of the applicable map to the Ohio Department of Health and the Ohio Department of Job and Family Services. Systems must also submit a report to the director containing at least both of the following: (1) The applicable map with narrative, and (2) A list of sampling locations used to collect samples as required by Ohio Revised Code (ORC) Section 6109.121 and any rules adopted thereunder, including contact information for the owner and occupant of each sampling site.

Should a water system determine no lead service lines exist in their distribution system, they must provide information stating they reviewed, at the minimum, historical permit records and local ordinances, distribution maintenance records and information pertaining to installation dates or materials for all services lines. This information must be verified below.

I HEREBY CERTIFY THAT THE FOLLOWING METHOD(S) WERE USED TO DETERMINE NO LEAD SERVICE LINES EXIST IN THIS WATER SYSTEM'S DISTRIBUTION SYSTEM, AS REQUIRED BY ORC 6109.121(F):

LEAD SERVICE LINE VERIFICATION
<p>This PWS states they have no lead service lines and has reviewed the following information (select one or more of the following):</p> <ul style="list-style-type: none"><input type="checkbox"/> Historical permit records and/or local ordinances<input type="checkbox"/> Distribution maintenance records (i.e. meter replacement, waterline break repairs)<input checked="" type="checkbox"/> Information pertaining to installation dates for all service lines (i.e. after 1986 when lead services lines were banned)<input type="checkbox"/> Service line material of all service lines is known (i.e. all service lines are known to be PVC)

M.W. Turnbull 7 March '17
Signature of Responsible Person Date

Mike Turnbull
Printed Name and Title of Responsible Person

PWS NAME: Glenn Hunter & Assoc.
PWS ID: OH 2637913
COUNTY: Fulton

For Ohio EPA use only:
Date Verification Rec'd: _____

RECEIVED

MAR 07 2017

DDAGW - NWDO