



Hayden Heights MHP was established in 1972. The Hayden Heights MHP drinking water distribution mains consist of Cast Iron. The tapping saddles and corp stop are made of brass or Plastic. The copper setters that were made after June 1986 may not contain Lead. No lead service lines have been encountered over numerous years of distribution maintenance. The Hayden Heights MHP now has a mechanism in place to track/remove any potential lead service lines encountered in the future.



Because it is practically impossible to determine the lead content of an installed fixture, fitting or pipe, it should be assumed that the manufacture or installation date is the primary indicator of the lead content. Therefore, the characteristics of buildings and piping solder or fixtures would be buildings in Ohio built prior to 1998 or that use plumbing material or solder manufactured before 1998 may have materials with greater than 8% lead and are at a higher risk of contributing lead to the drinking water than materials manufactured after 1998. In addition, buildings built and plumbing materials manufactured after 2014 were required to have less than 0.25% lead by weight and have the lowest risk for contributing lead to the drinking water. It should be noted however that, although prohibited, some use of leaded solder or leaded components may have occurred after the prohibitions became effective.

The 2 wells at the water plant should not be under the influence of mining or industry. And the test results are not showing any significant impact of impurities at the current time.

Operator of Record,

A handwritten signature in black ink, appearing to read "M. Mike McLaughlin". The signature is written in a cursive, flowing style.

M. Mike McLaughlin

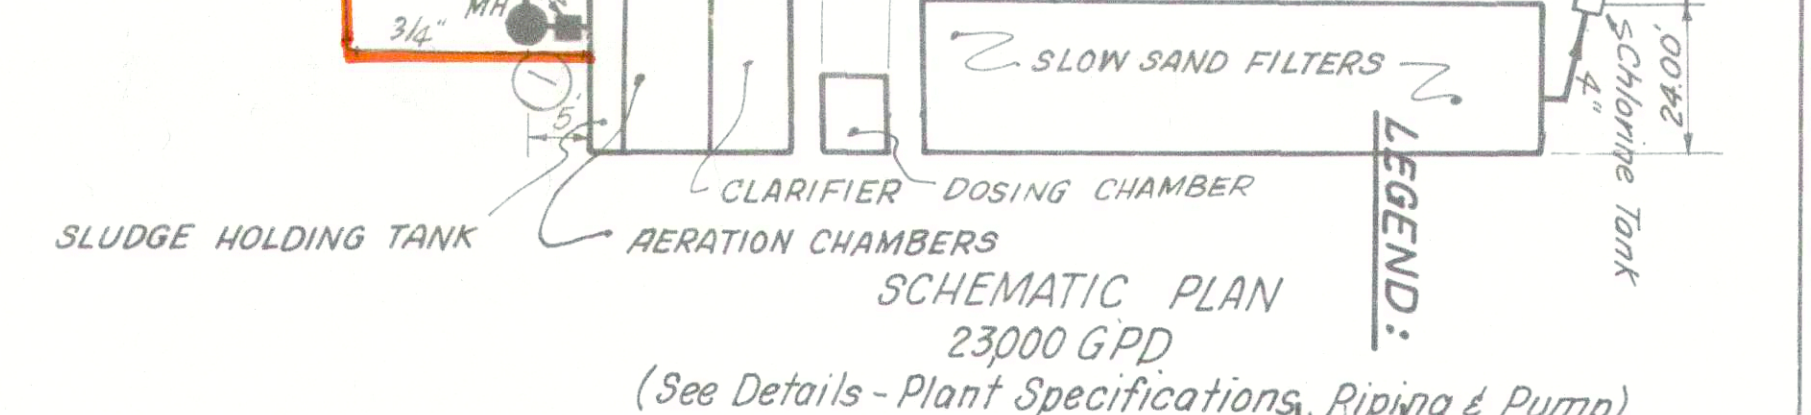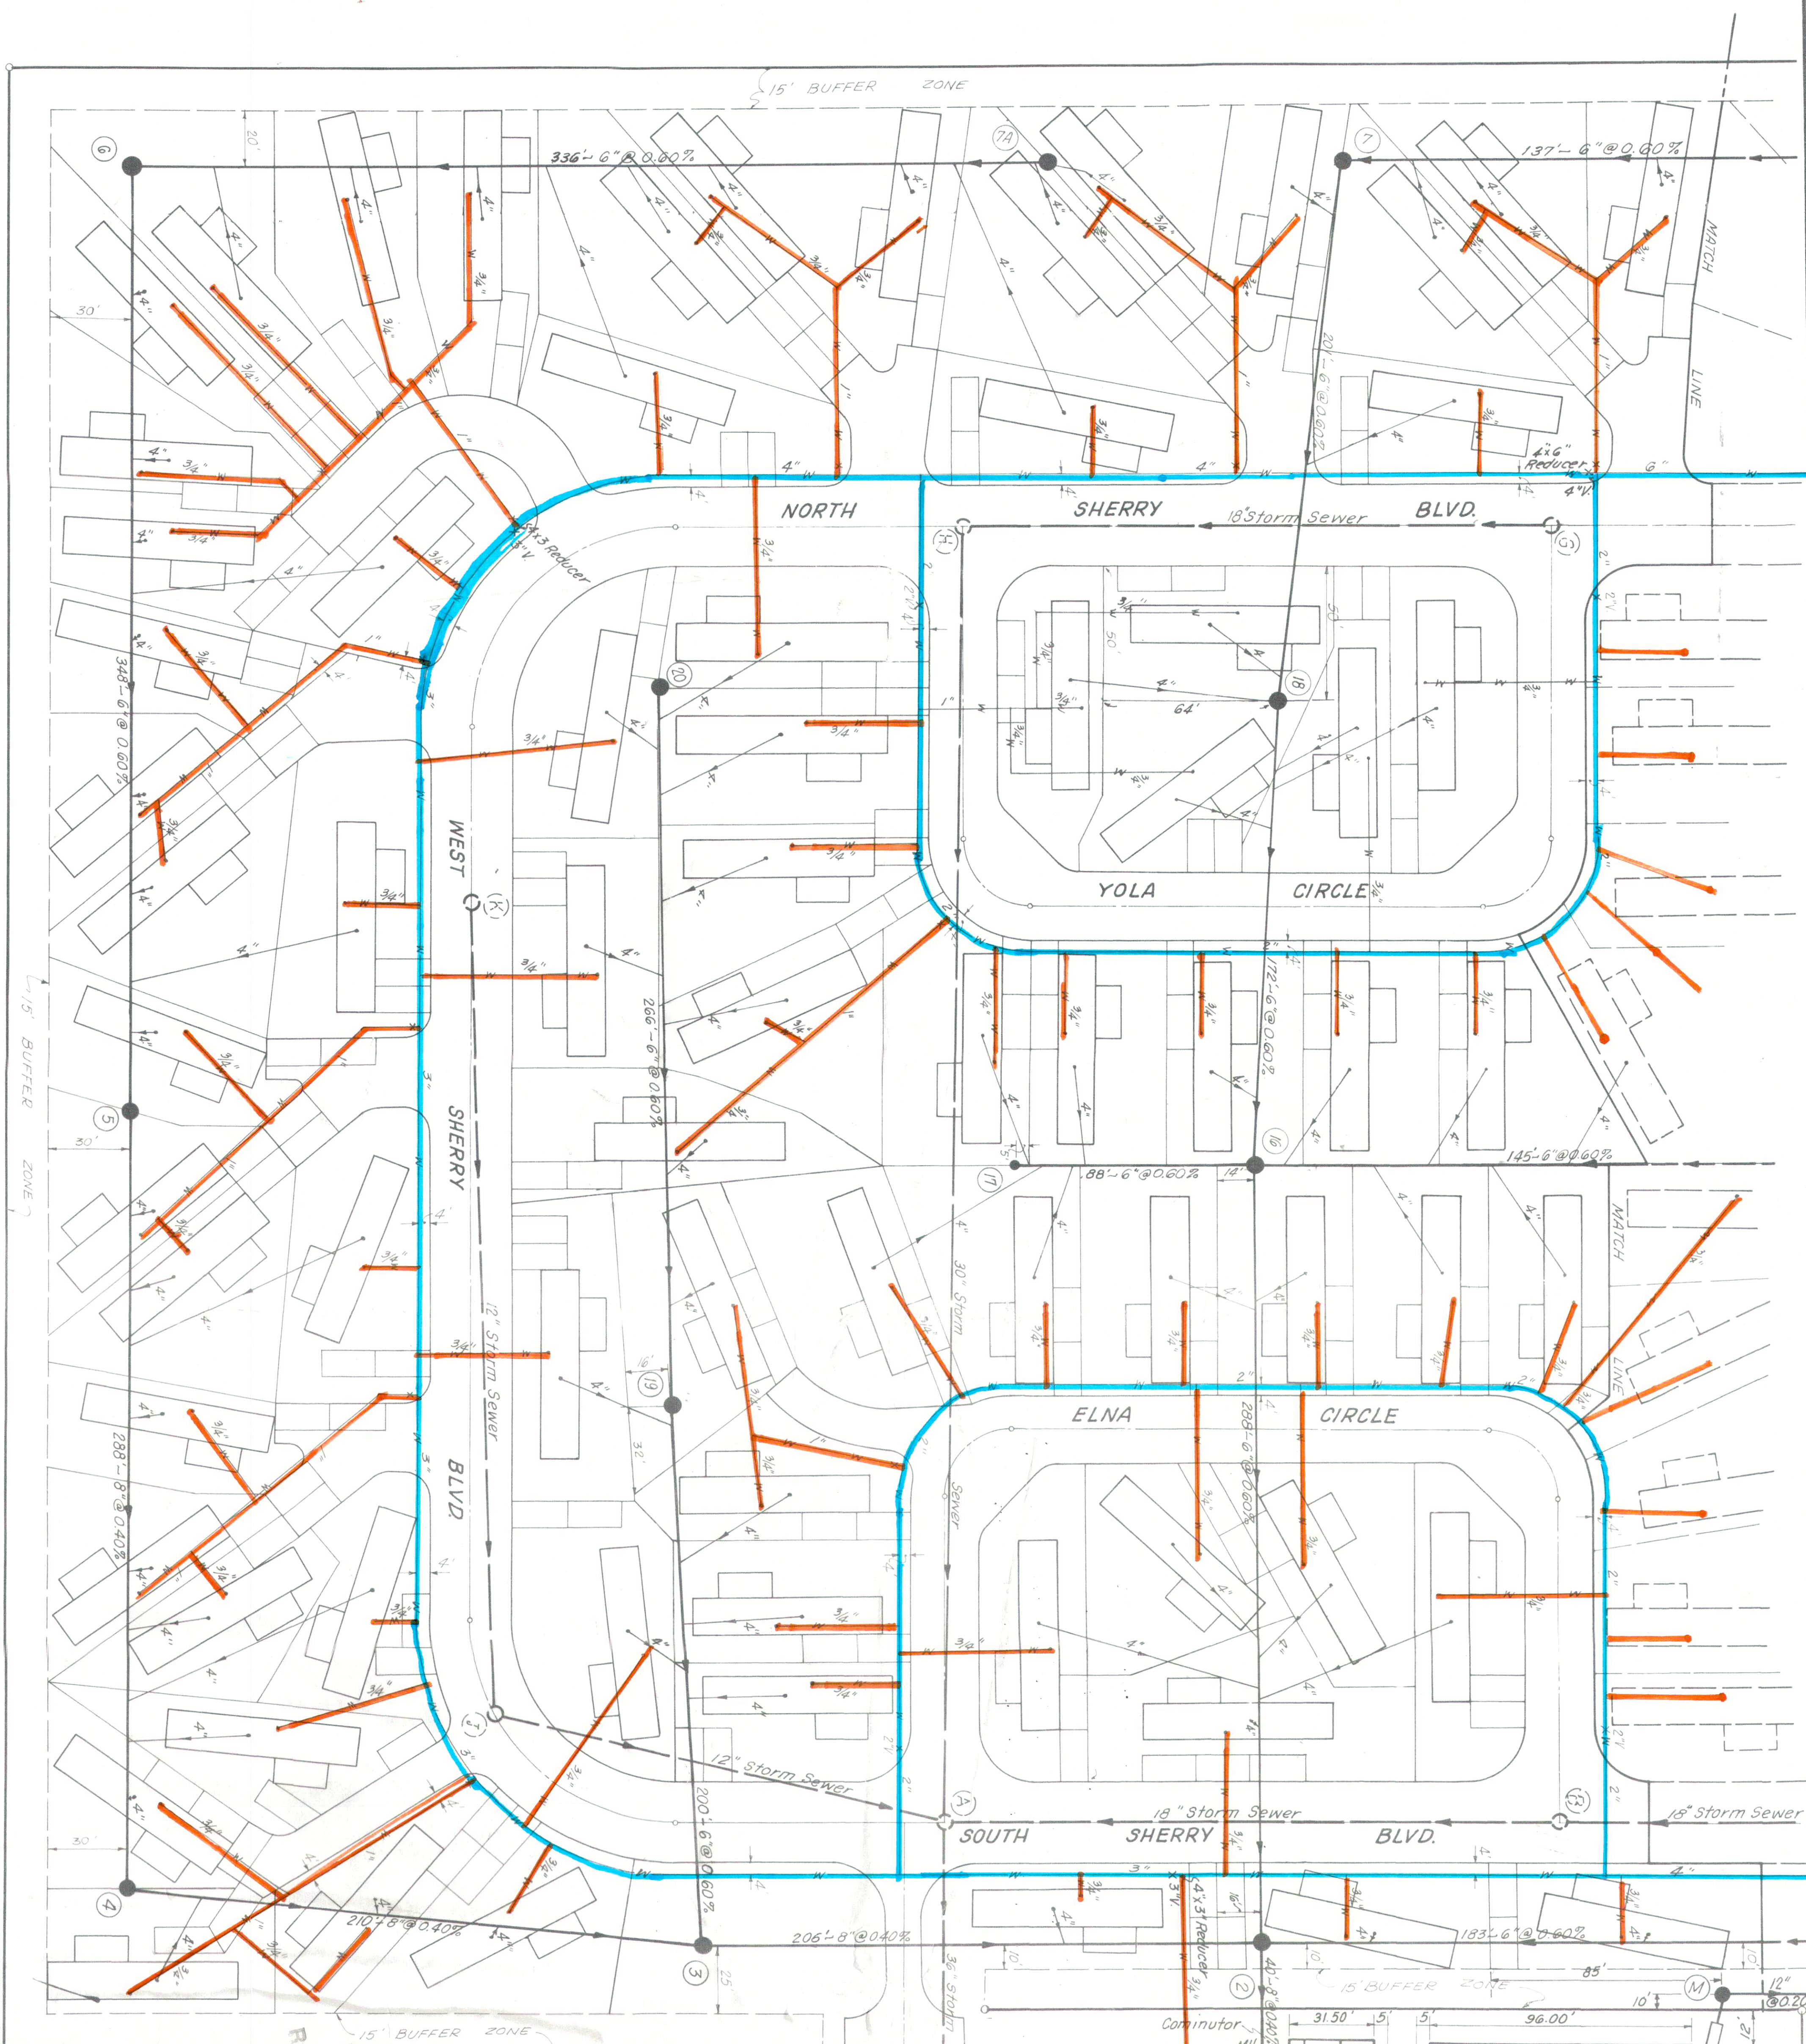

- LEGEND:**
- = Copper or Plastic Service Line
 - = Cast Iron Main
 - = SANITARY SEWER
 - = WATER LINE
 - = STORM SEWER
- Note: For Fencing around Holding Basin and Sewage Plant see sheet 5

TRAILER PARK APPROVED
 STATE OF OHIO DEPARTMENT OF HEALTH
 AS EVIDENCED BY COPY OF
 LETTER OF APPROVAL
 HERETO ATTACHED

WATER SUPPLY APPROVED
 STATE OF OHIO DEPARTMENT OF HEALTH
 AS EVIDENCED BY COPY OF
 LETTER OF APPROVAL
 HERETO ATTACHED

REFERENCES:
 For Well House Details and Tertiary and Plant Building Details see section 5-7 in specifications.
 Revised: 7-19-72 E.A.F.

OWNER:
JUL-LE-MAR ESTATES
MOBILE HOME PARK
 J. FRANCISCO JR.

SAUNTERY AND WATER DISTRIBUTION PLAN

DESIGNED BY:
K.D.C.
CONSULTING ENGINEERS
 2813 WESTERVILLE ROAD
 COLUMBUS, OHIO 43224

CHECKED BY:
B.R.

DATE:
 MAY, 1972

PROJECT NO.:
 T-12

SHEET NO.:
 12

RECEIVED
 JUL 19 1972
 OHIO DEPARTMENT OF HEALTH
 DIVISION OF PUBLIC HEALTH



— = Cast Iron Mains
— = Copper Service Lines
 No Lead Service lines have ever been seen
 But lead containing compounds or fixtures may be present.



TRAILER PARK
APPROVED
 STATE OF OHIO DEPARTMENT OF HEALTH
 AS SUPERVISOR OF DIVISION OF
 LETTER OF APPROVAL
 LETTER OF APPROVAL

WATER SUPPLY
APPROVED
 STATE OF OHIO DEPARTMENT OF HEALTH
 AS SUPERVISOR OF DIVISION OF
 LETTER OF APPROVAL
 LETTER OF APPROVAL

SEWERAGE
APPROVED
 STATE OF OHIO DEPARTMENT OF HEALTH
 AS SUPERVISOR OF DIVISION OF
 LETTER OF APPROVAL
 LETTER OF APPROVAL

NOTE: For Sanitary Profiles see sheet 13 & 14.
 For Well House and Well Details
 see specifications.
 Hayden Heights MHP
 PWS ID OH2501612
 JUL 19 1972

RECEIVED
 JUL 19 1972
 OHIO DEPARTMENT OF HEALTH
 DIVISION OF WATER SUPPLY

OWNER:		JUL-LE-MAR ESTATES MOBILE HOME PARK J. FRANCISCO JR.	
SANITARY AND WATER DISTRIBUTION PLAN			
DESIGNED	K.D.C.	TRI-ASSOCIATES, INC.	Project No.
DRAWN	R.A.F.	CONSULTING ENGINEERS	T-12
CHECKED	B.R.	4819 WEST KYLE - KOS	SHEET NO
		Columbus, Ohio 43224	11
SCALE: 1" = 30'	DATE	May, 1972	