


DRIVE WAY

NORTH  
Service Line

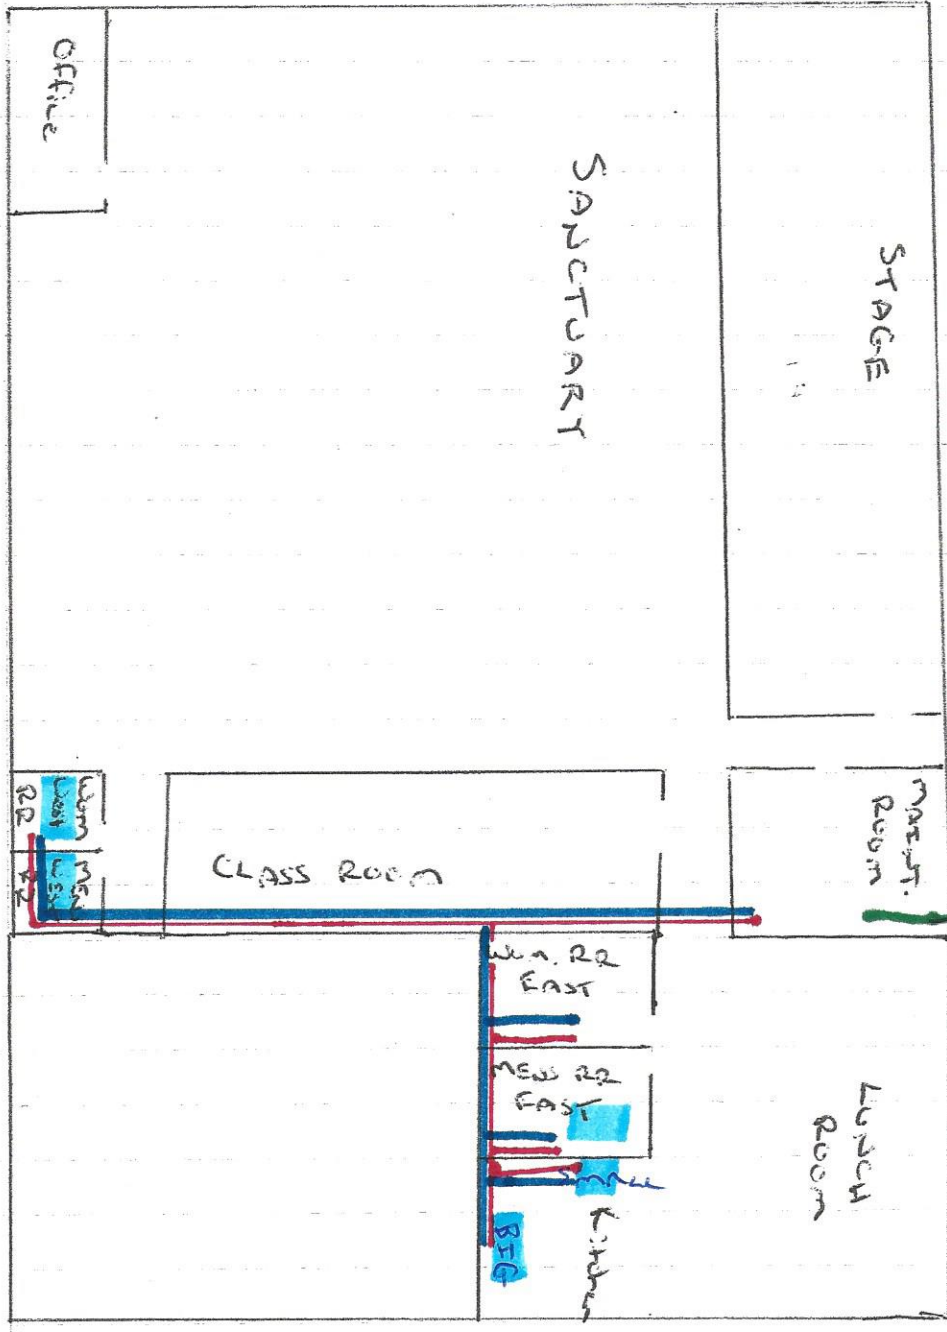

Creekside Child Care  
 OH 2570716  
 Nontransient Non-Community  
 Contact  
 Jeff Hickman  
 614-576-9807  
 jhickm7@columbus.rr.com

Service Line - PVC  
 Interior Lines - Copper 7/8"

SAMPLE SITES -

- LC 201 Women's RR West
- LC 202 Mens RR West
- LC 203 Mens RR East
- LC 204 Kitchen Sink - Small
- LC 205 Kitchen Sink - Big

Hot water lines - Red  
 Cold water lines - Blue  
 Service line - Green

Creekside Child Care  
 2225 Rohr Rd.  
 Lockbourne, Ohio 43147  
 Phone - 614-491-4906

Building was constructed in 1986 per the  
 Franklin Cty. Auditor website.  
 1986-2014 lead solder was banned and  
 there was lower content of lead in brass