


Great Beginnings Academy  
 2345 Demorest Rd.  
 Grove City OH 43123  
 PWS ID OH 2563912

Contact Daniela Caceras 614.801.1001

Materials in Ohio built prior to 1990 or that use plumbing material or solder manufactured before 1998 may have materials with greater than 8% lead and are at a higher risk of contributing lead to the drinking water than materials manufactured after 1998. In addition, building built and plumbing material manufactured after 2014 were required to have less than 0.25% lead by weight and have the lowest risk for contributing lead to the drinking water. It should be noted however that, although prohibited, some use of leaded solder or leaded components may have occurred after the prohibitions became effective.

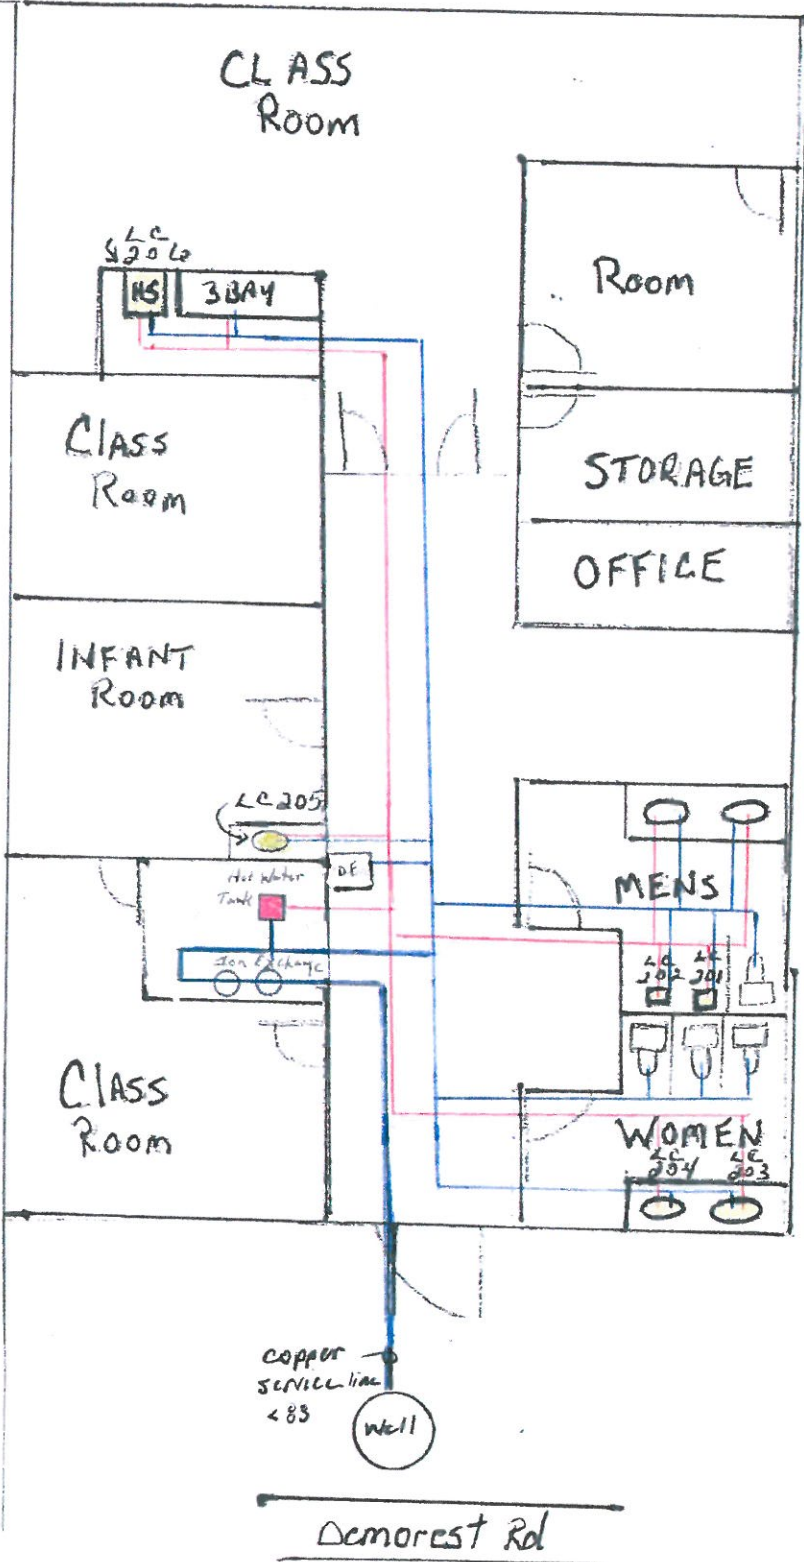

The building was built in 1978.

The service line is copper.

Interior plumbing is cupb < 83.

Fixtures are cupb < 83.

There are no lead lines in this facility.

— Cold water line  
 — Hot water line



Demorest Rd