


PEX water line
 copper water line with lead

LC201 - no lead brass fixture
 LC202 - no lead brass fixture
 LC203 - no lead brass fixture
 LC204 - no lead brass fixture
 LC205 - no lead brass fixture

FIRST FLOOR

GALEHOUSE COMPANIES, INC.

12667 Portage st., PO 267, Doylestown, OH 44230 - Ph 330-658-2022 - Fax 330-658-6977

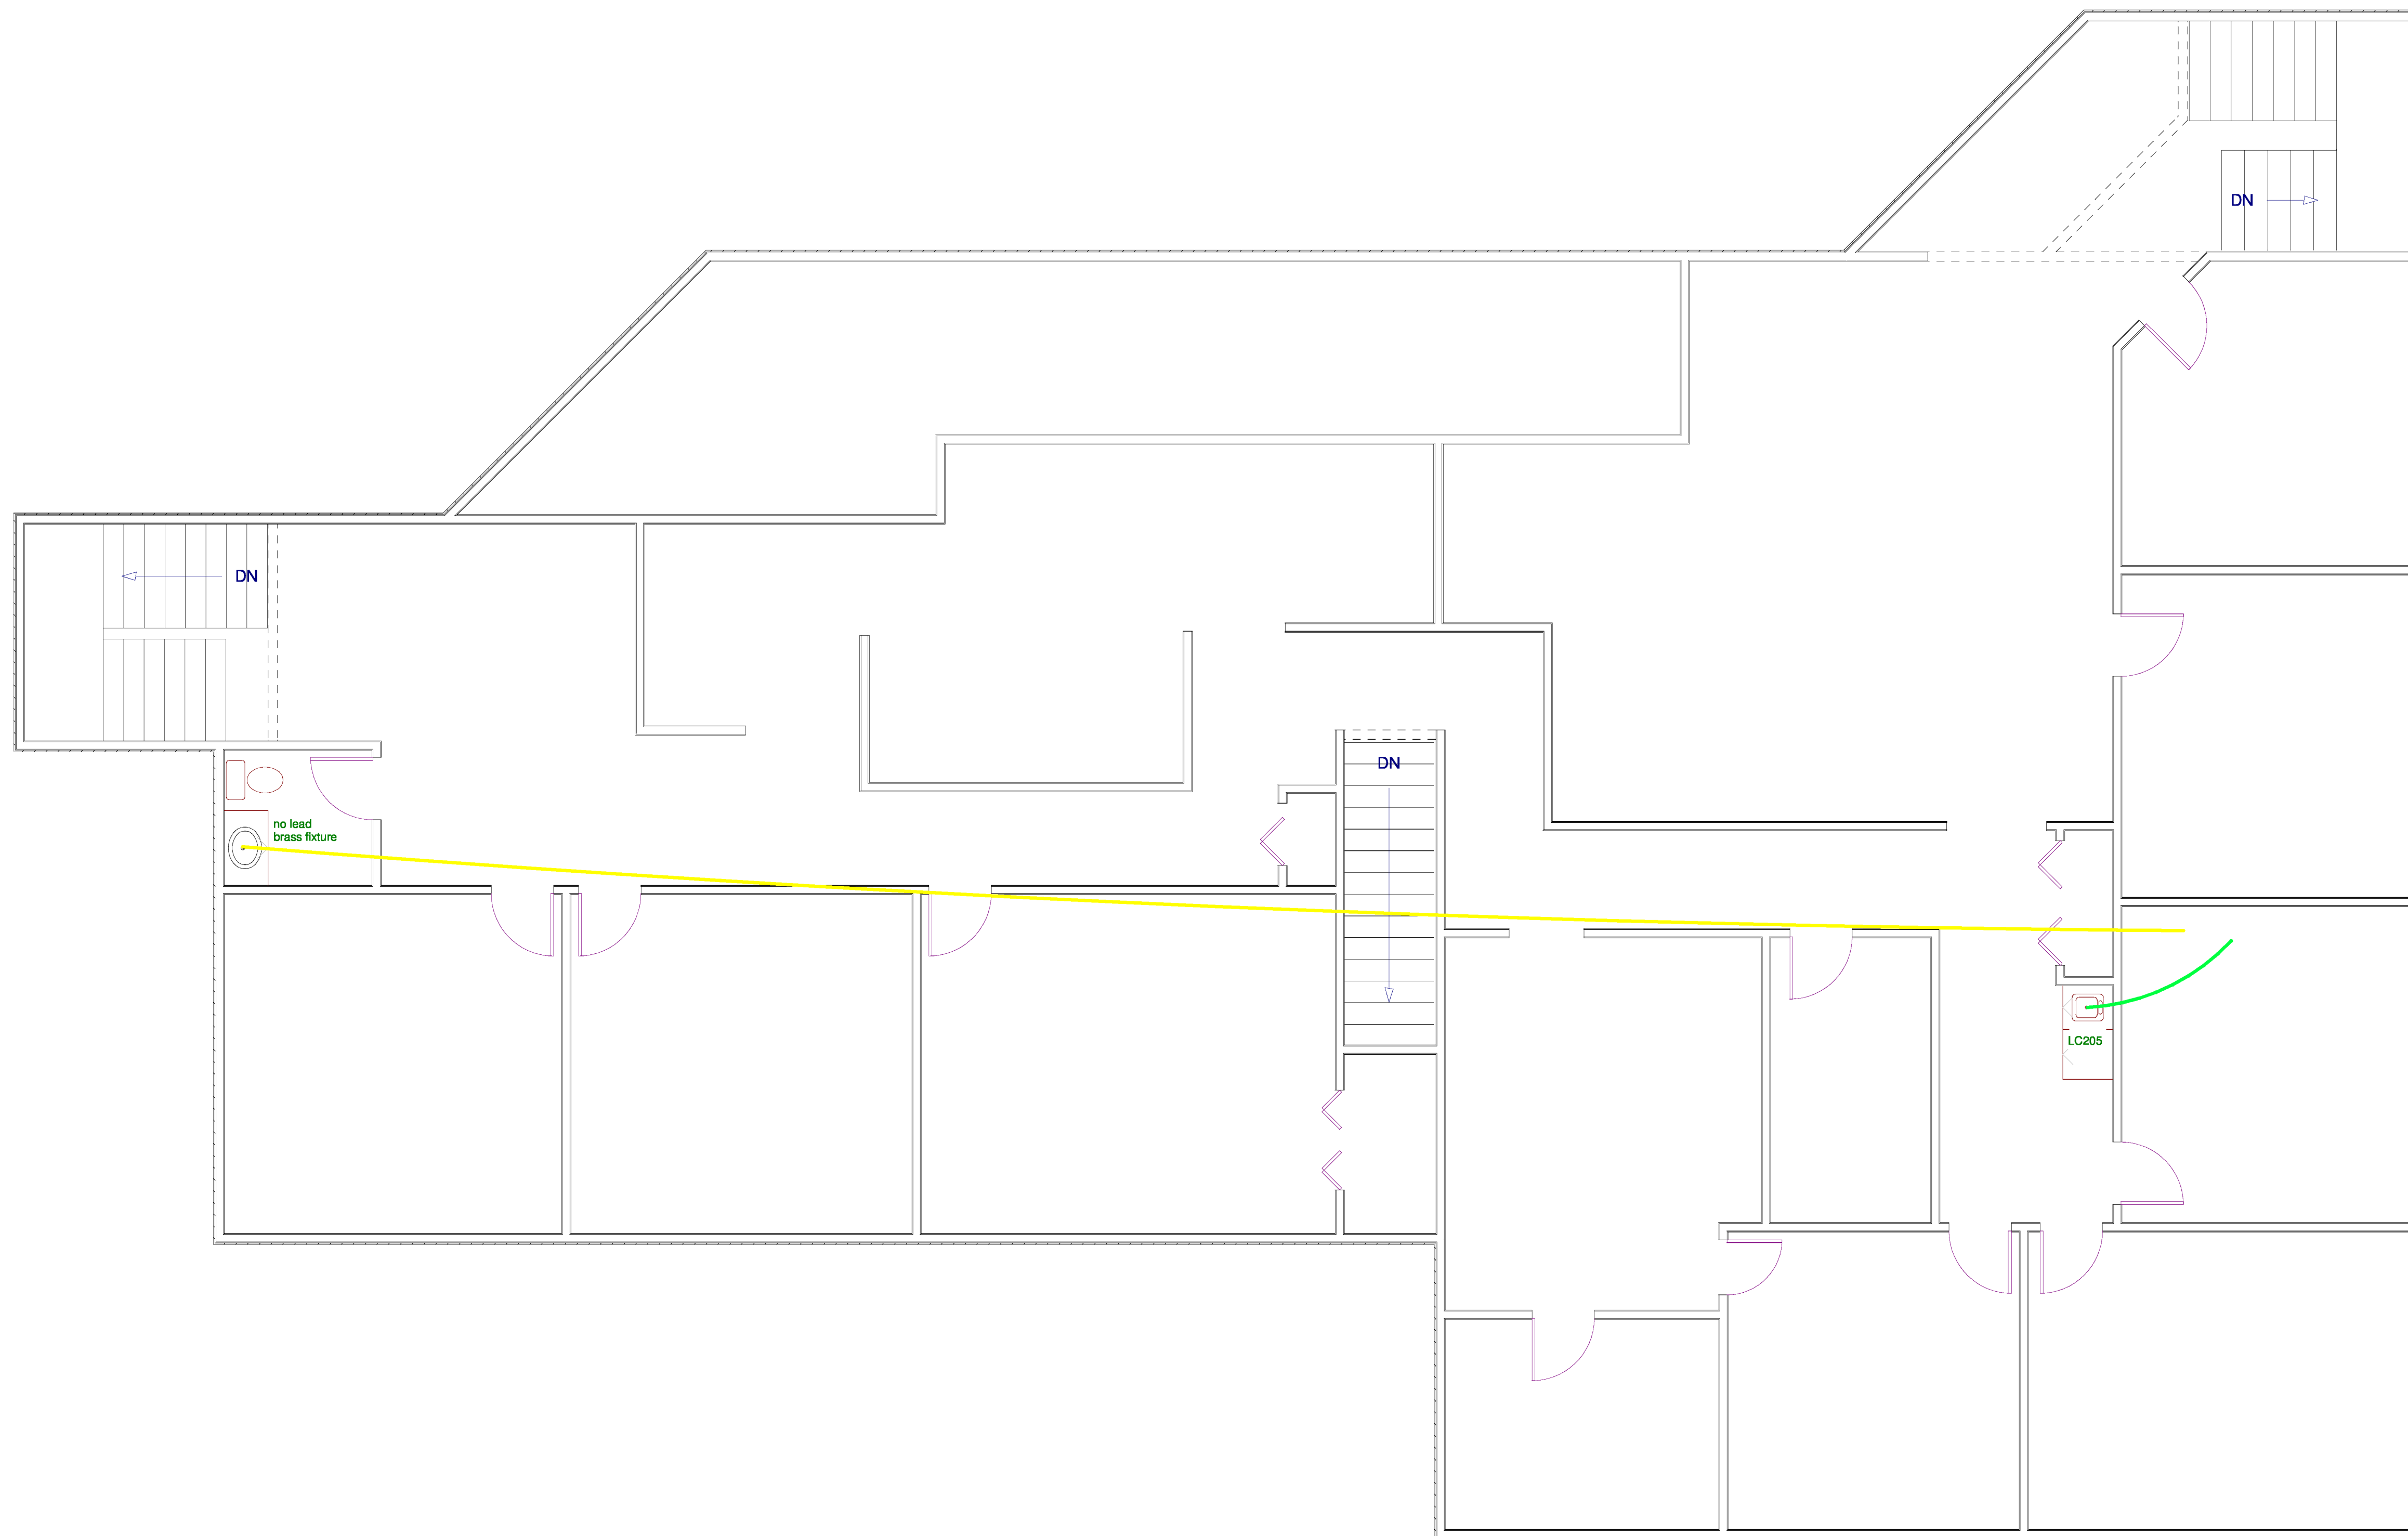

SECOND FLOOR

1/4" = 1' scale

Drawn by VWBauman
 REVISED 3-3-17

PAGE 2 OF 2

GALEHOUSE COMPANIES, INC.
 12667 Portage st., PO 267, Doylestown, OH 44230 - Ph 330-658-2022 - Fax 330-658-6977



12667 Portage St
Doylestown OH 44230

