


LEAD MAPPING IN DISTRIBUTION SYSTEM

1 DISTRIBUTION MAP

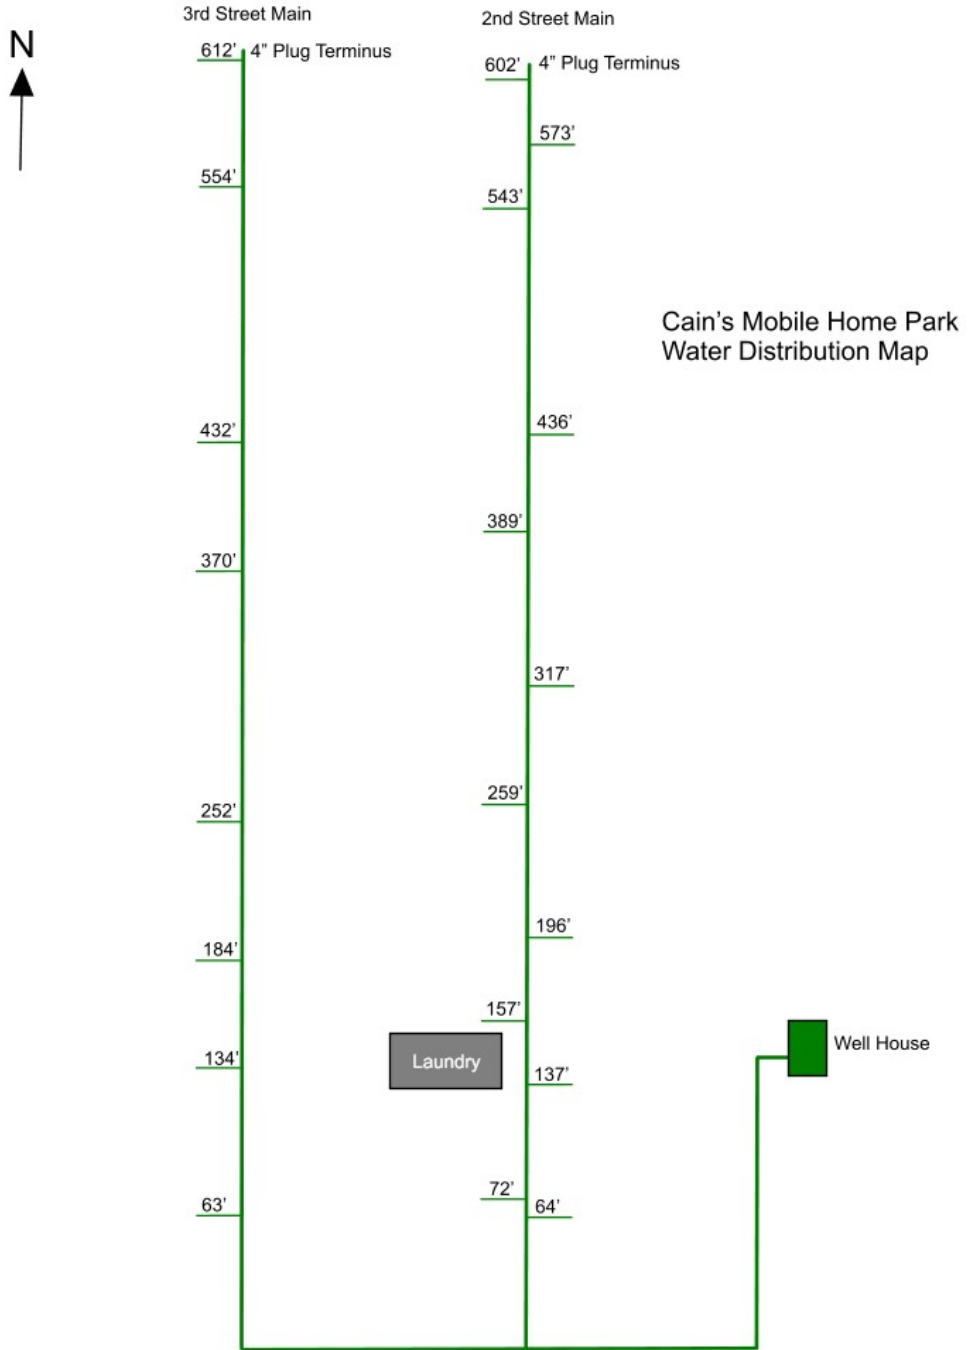

2 DISTRIBUTION MAINS

- All distribution mains are either 4" or 2" Schedule 80 PVC.

3 BUILDINGS SERVED BY WATER SYSTEM

With the exception of the Laundry and the Well House all structures are mobile homes.

3.1 Well House

- All plumbing is Schedule 80 PVC

3.2 Laundry (100 Artie Court)

- This structure was built before 1982 and we assume is used copper pipes with lead solder.

3.3 Mobile Homes

- The plumbing in these structures is either soft copper with brass compression fitting or PEX with brass fittings.

4 SAMPLING LOCATIONS

430 Artie Court, Tier 3, Mobile Home

324 Artie Court, Tier 3, Mobile Home

231 Artie Court, Tier 3, Mobile Home

102 Artie Court, Tier 3, Mobile Home

100 Artie Court, Tier 1, Laundry Building